04BH 29 2003

047
VENT. RAISE

0374_4563

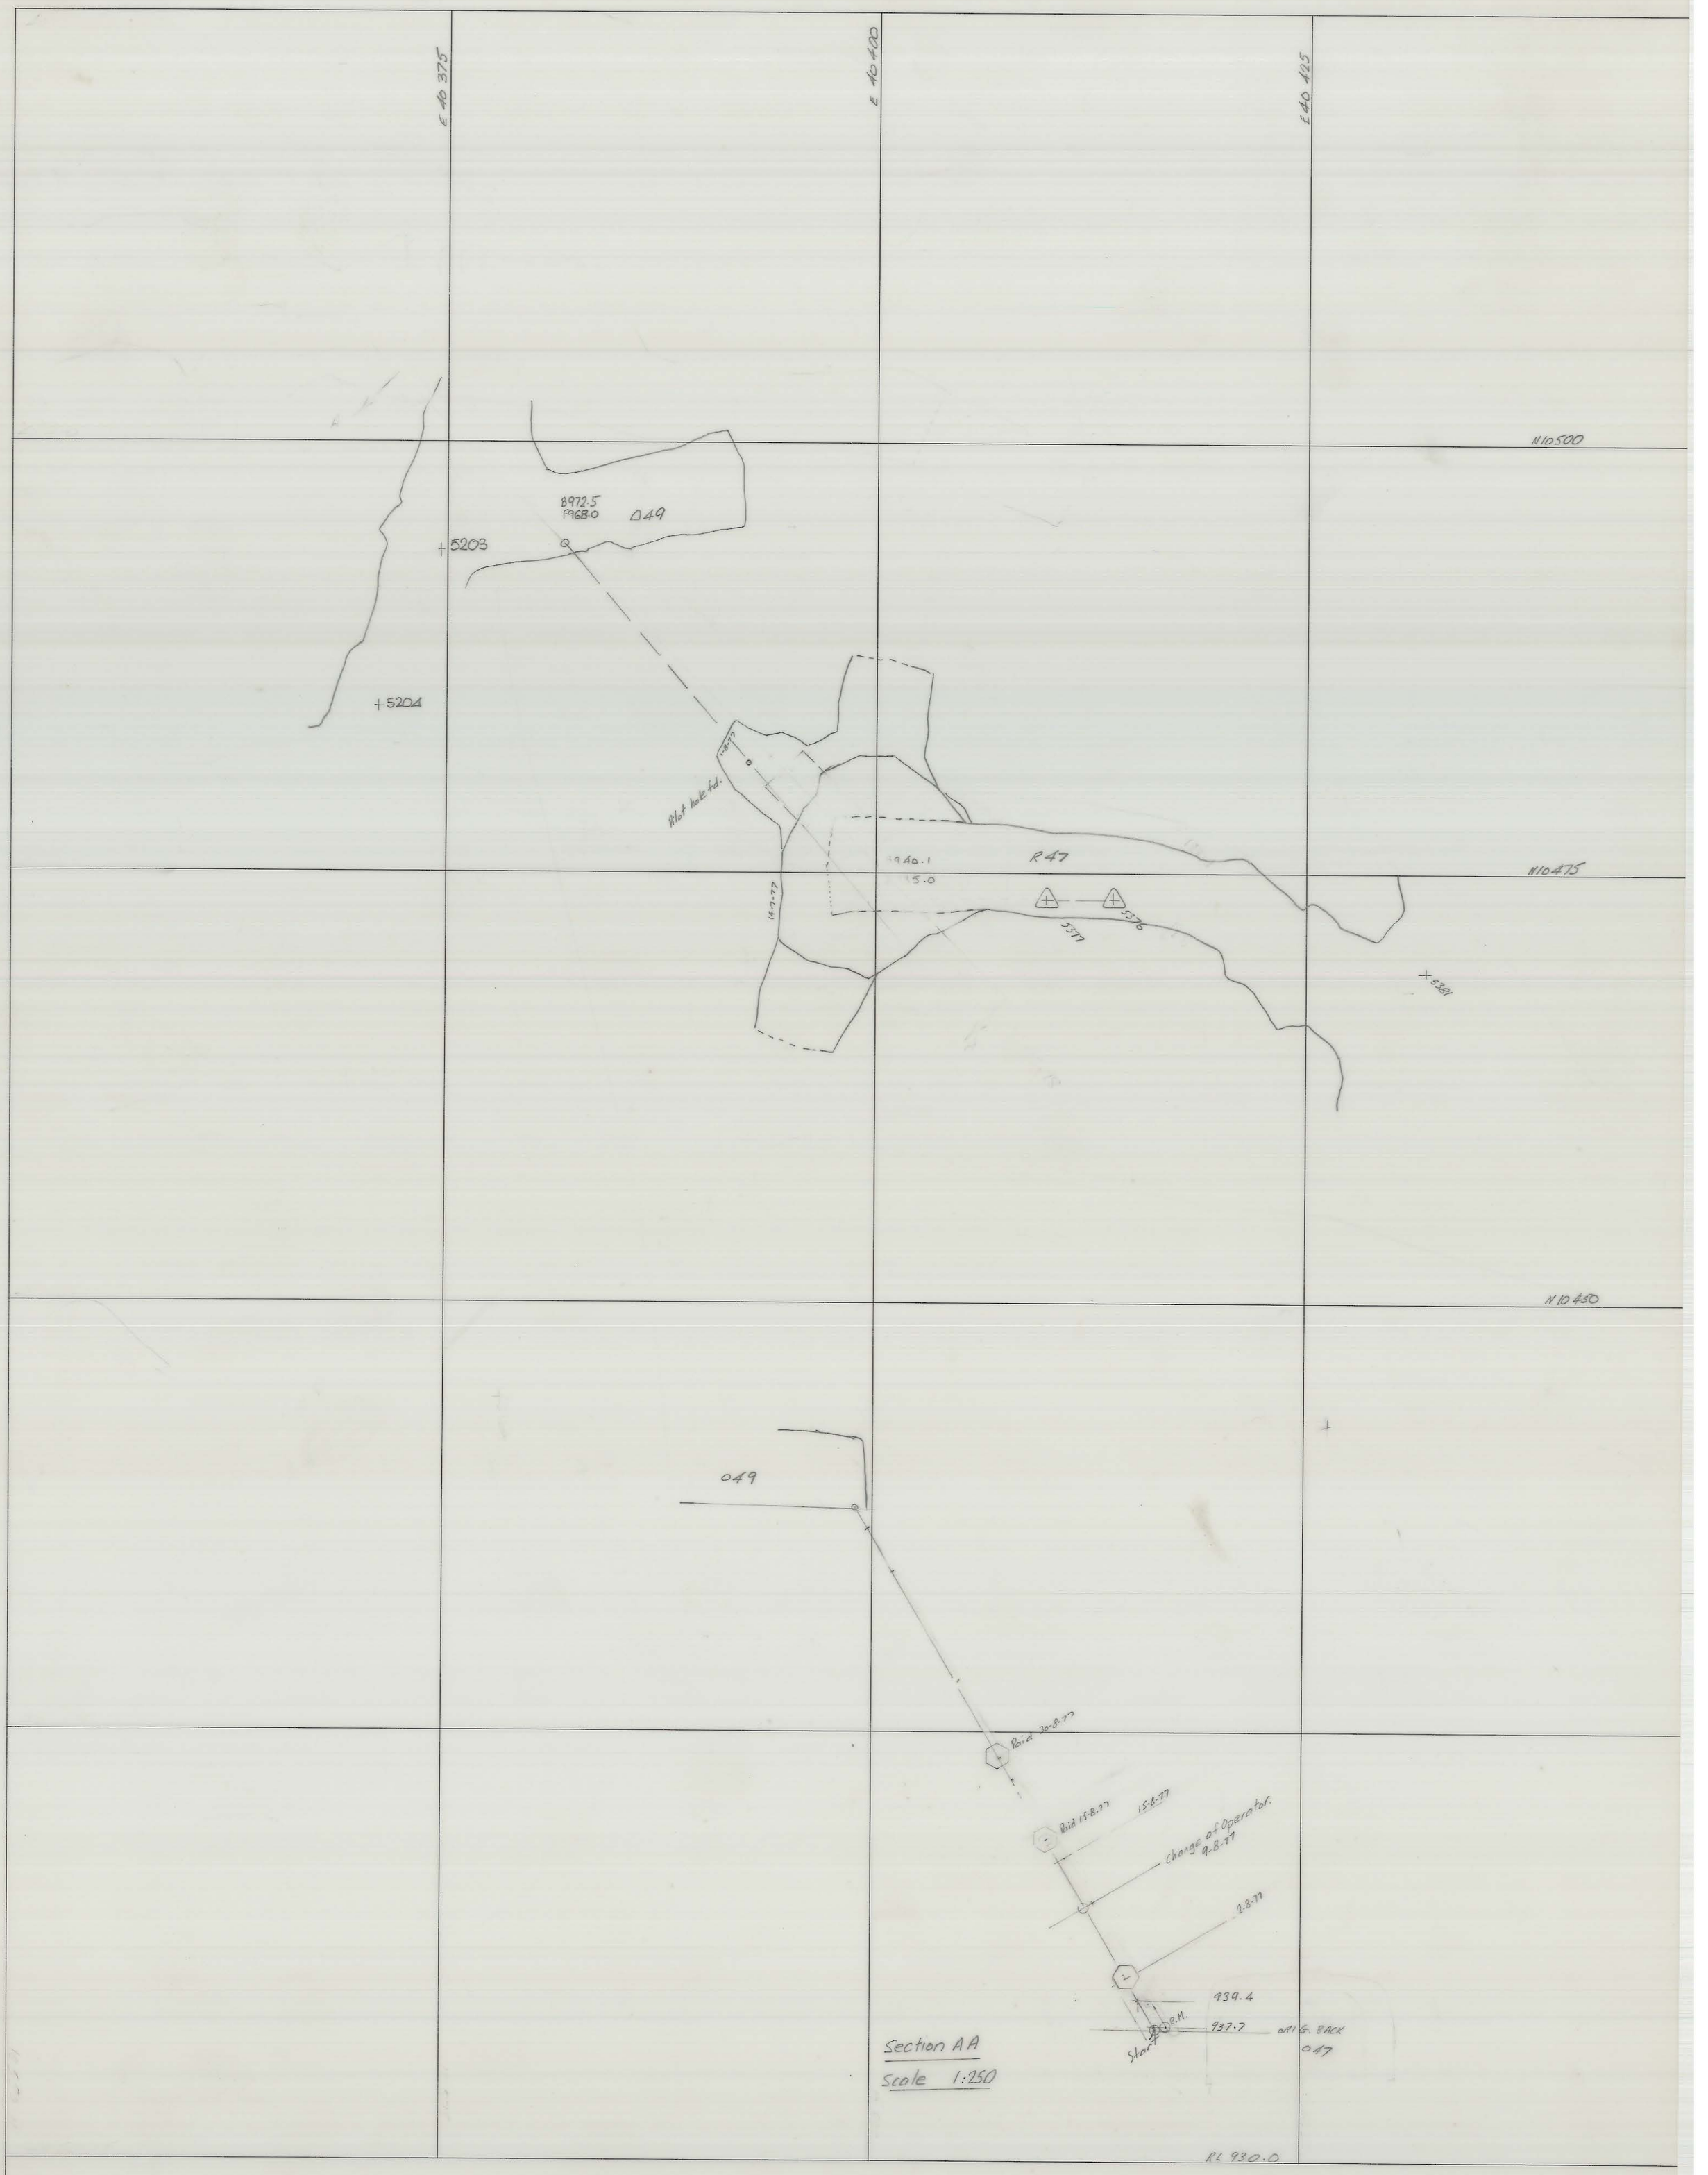

Plan No. 04 BH 29 _ 2003

Scale 1: 250

R47 _ 049 Vent. Raise