


04 BH 29-2005

K71-P70
R15E


0374_4564

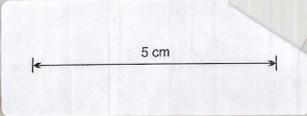

40 350

40 315


40 400

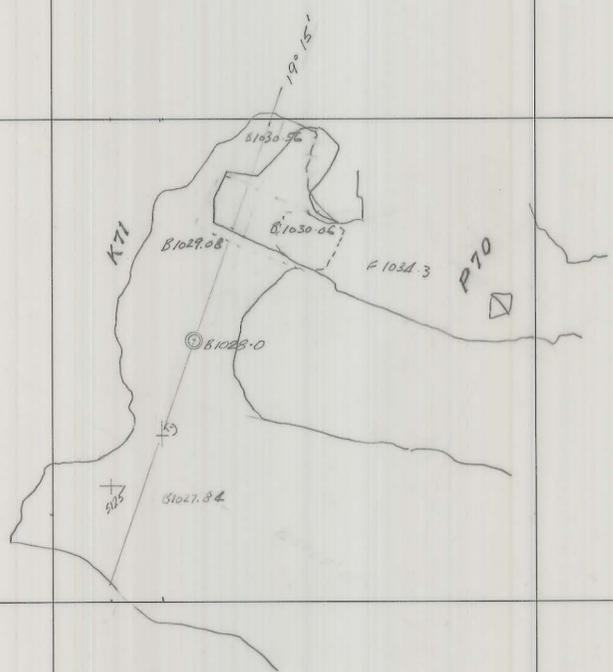

10 725

5124	10 706.959	40 355.752	1028.308
5125	10 706.064	40 353.011	1028.252
5114	10 704.538	40 359.400	1027.513
5111	10 699.334	40 384.549	1028.133

10 700

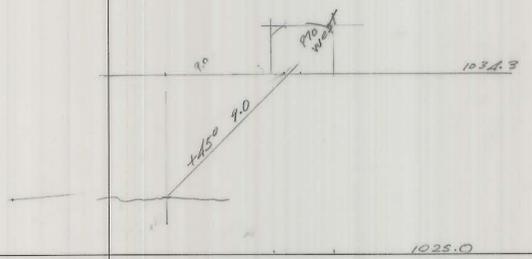

1025.0