



220/190
F-111-5

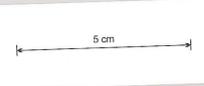

04 DM 19-175 107

0374_4577

DM
C. Wedge
E-113
T-110

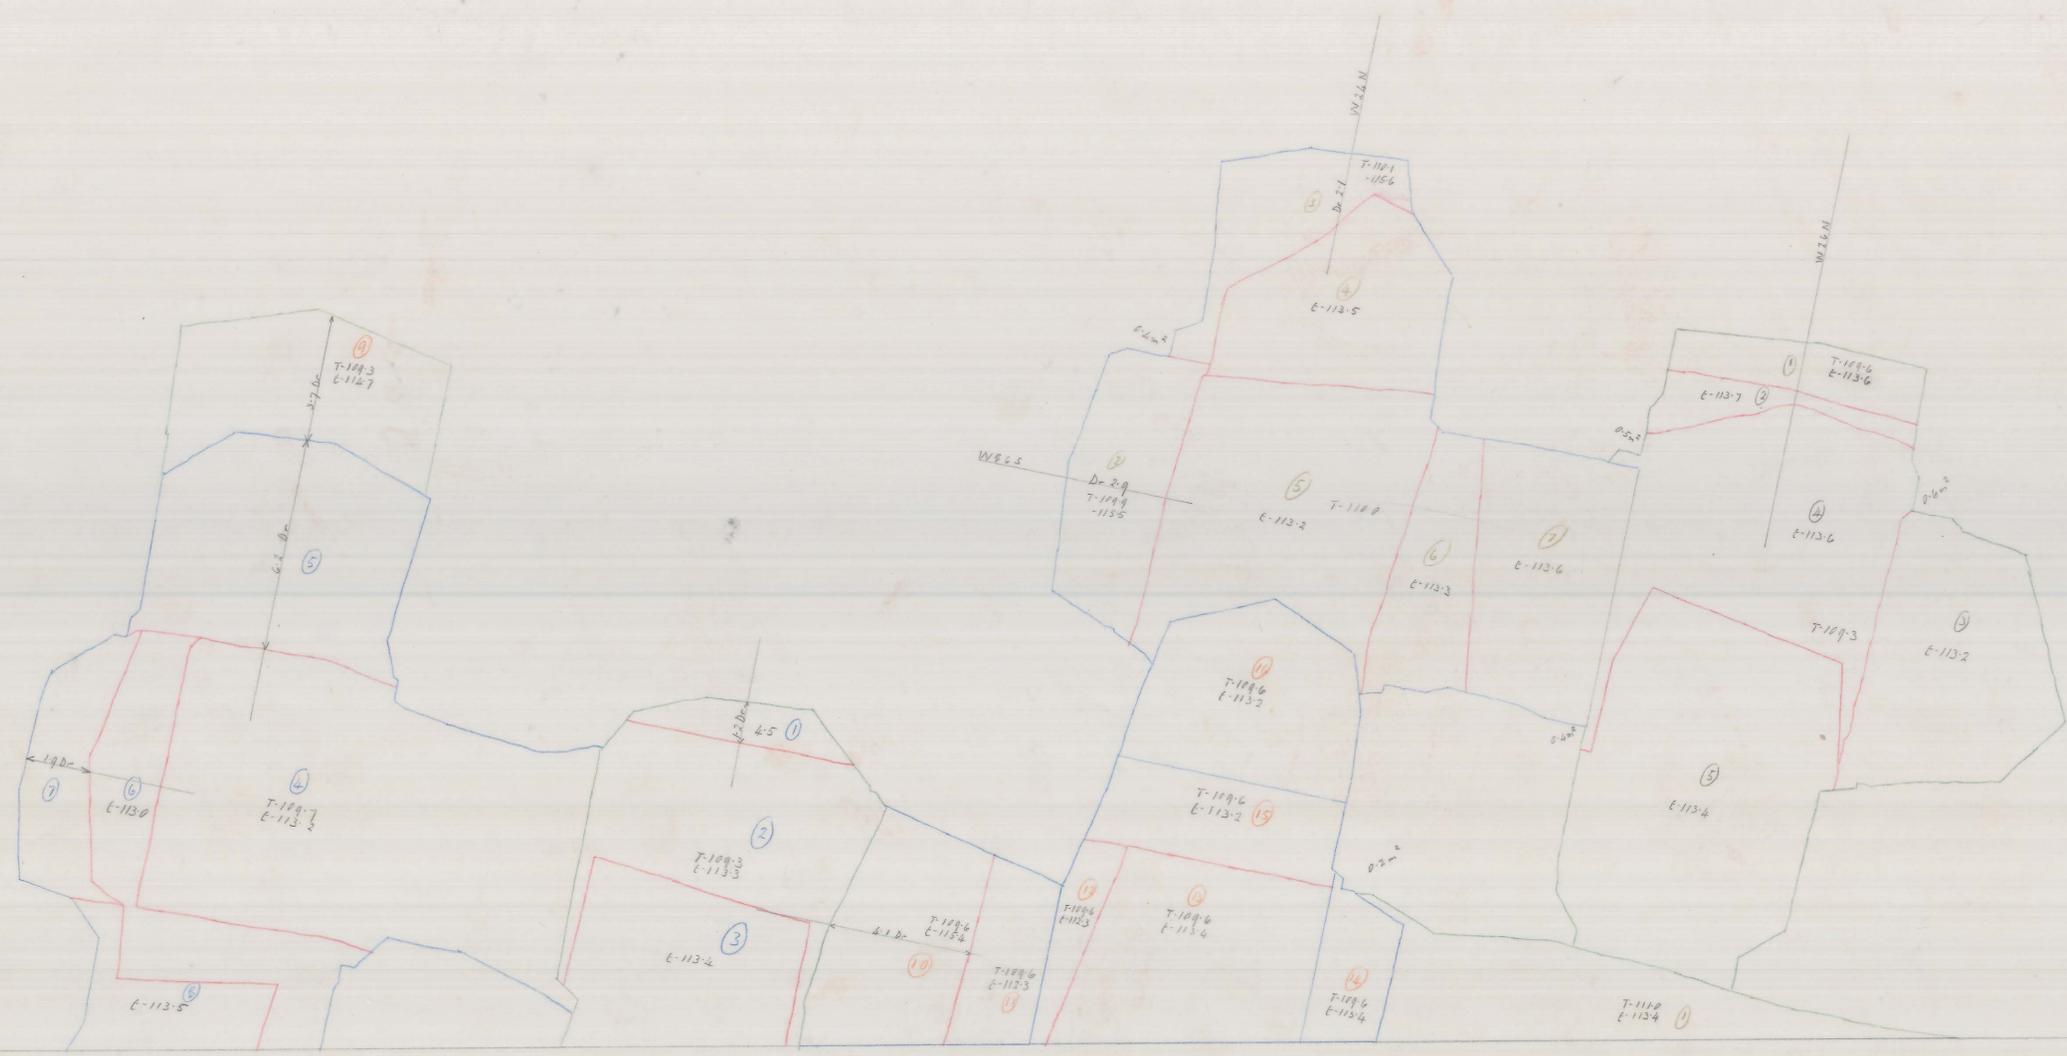

220 157 E

220 157 E

506 190 M