0374-458

04DM15-1069
SECTIONS DONE 28-8-90

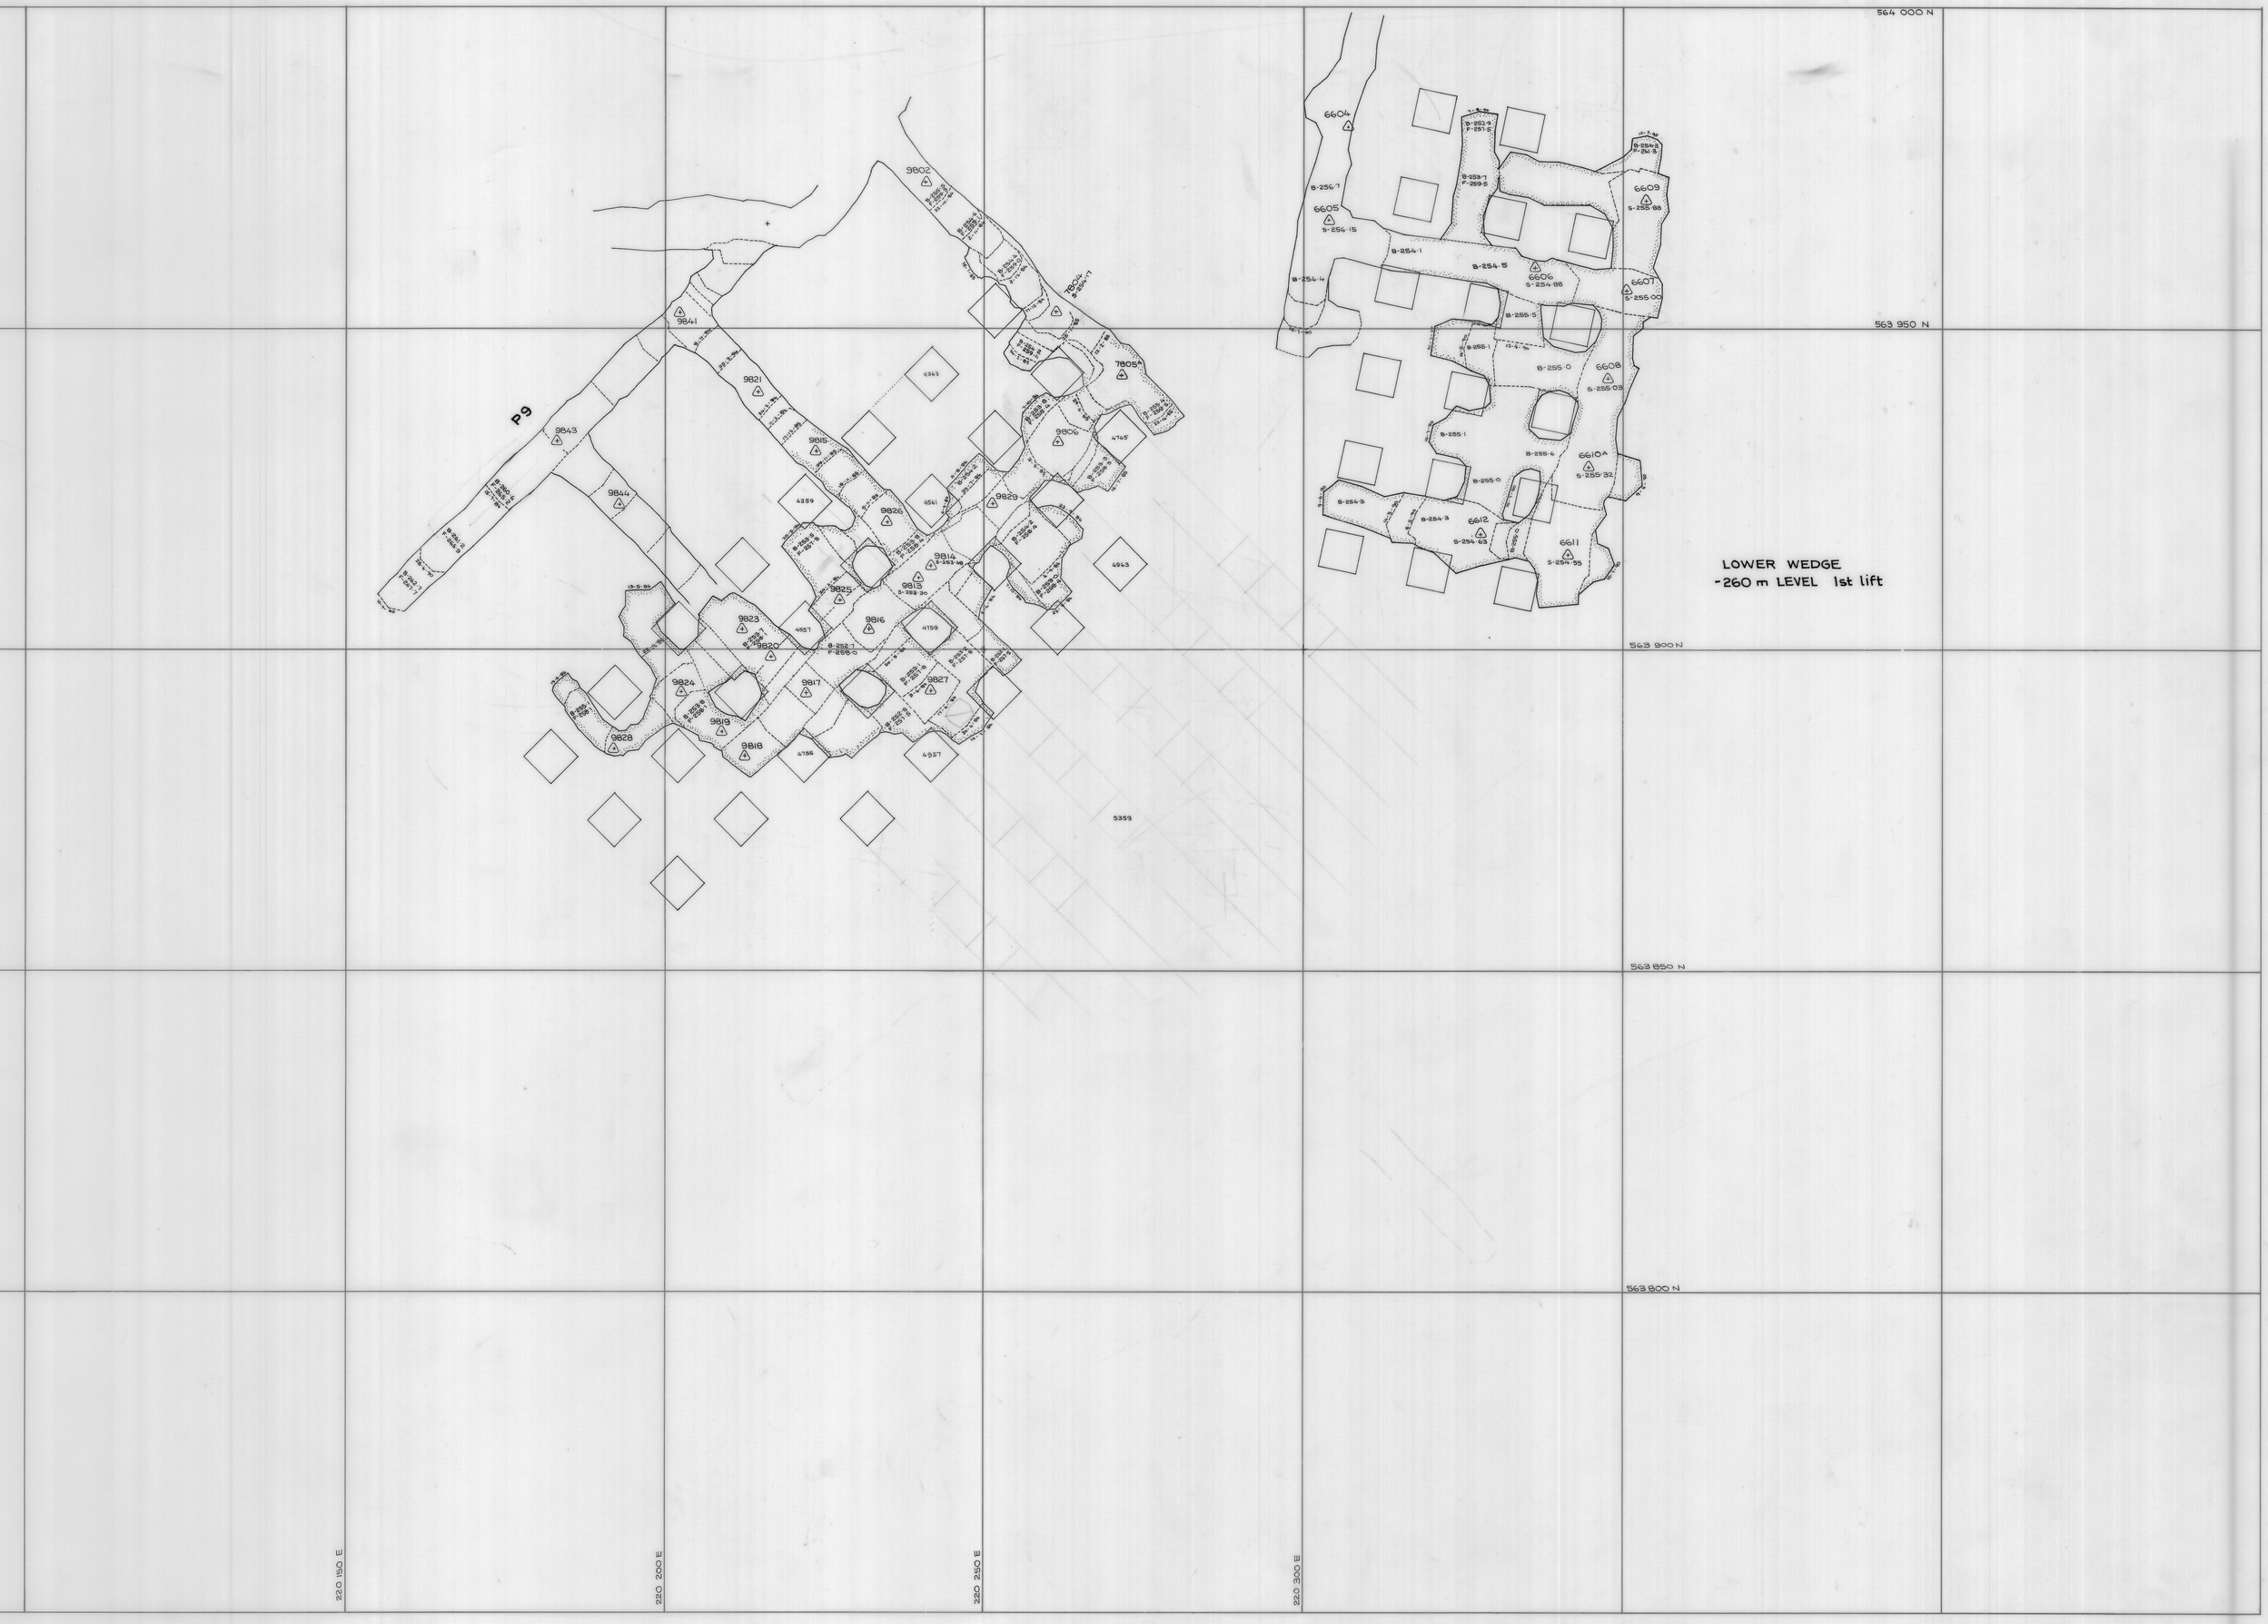

SCALE 1:500

NOTE - SEE ALSO 04DM14 - 1130 (THIS LIFT WAS A DEVELOPMENT U/C)

5 cm

north

LOCATION
DOLPHIN MINE

SUBJECT
SWAN STOPE
4th lift

KING ISLAND SCHEELITE
A DIVISION OF WARMAN INTERNATIONAL

GRASSY KING ISLAND

PLAN NUMBER
04DM15 - 1069