0374_461

04DM15 - 1072
SECTIONS BONE 28-8-90

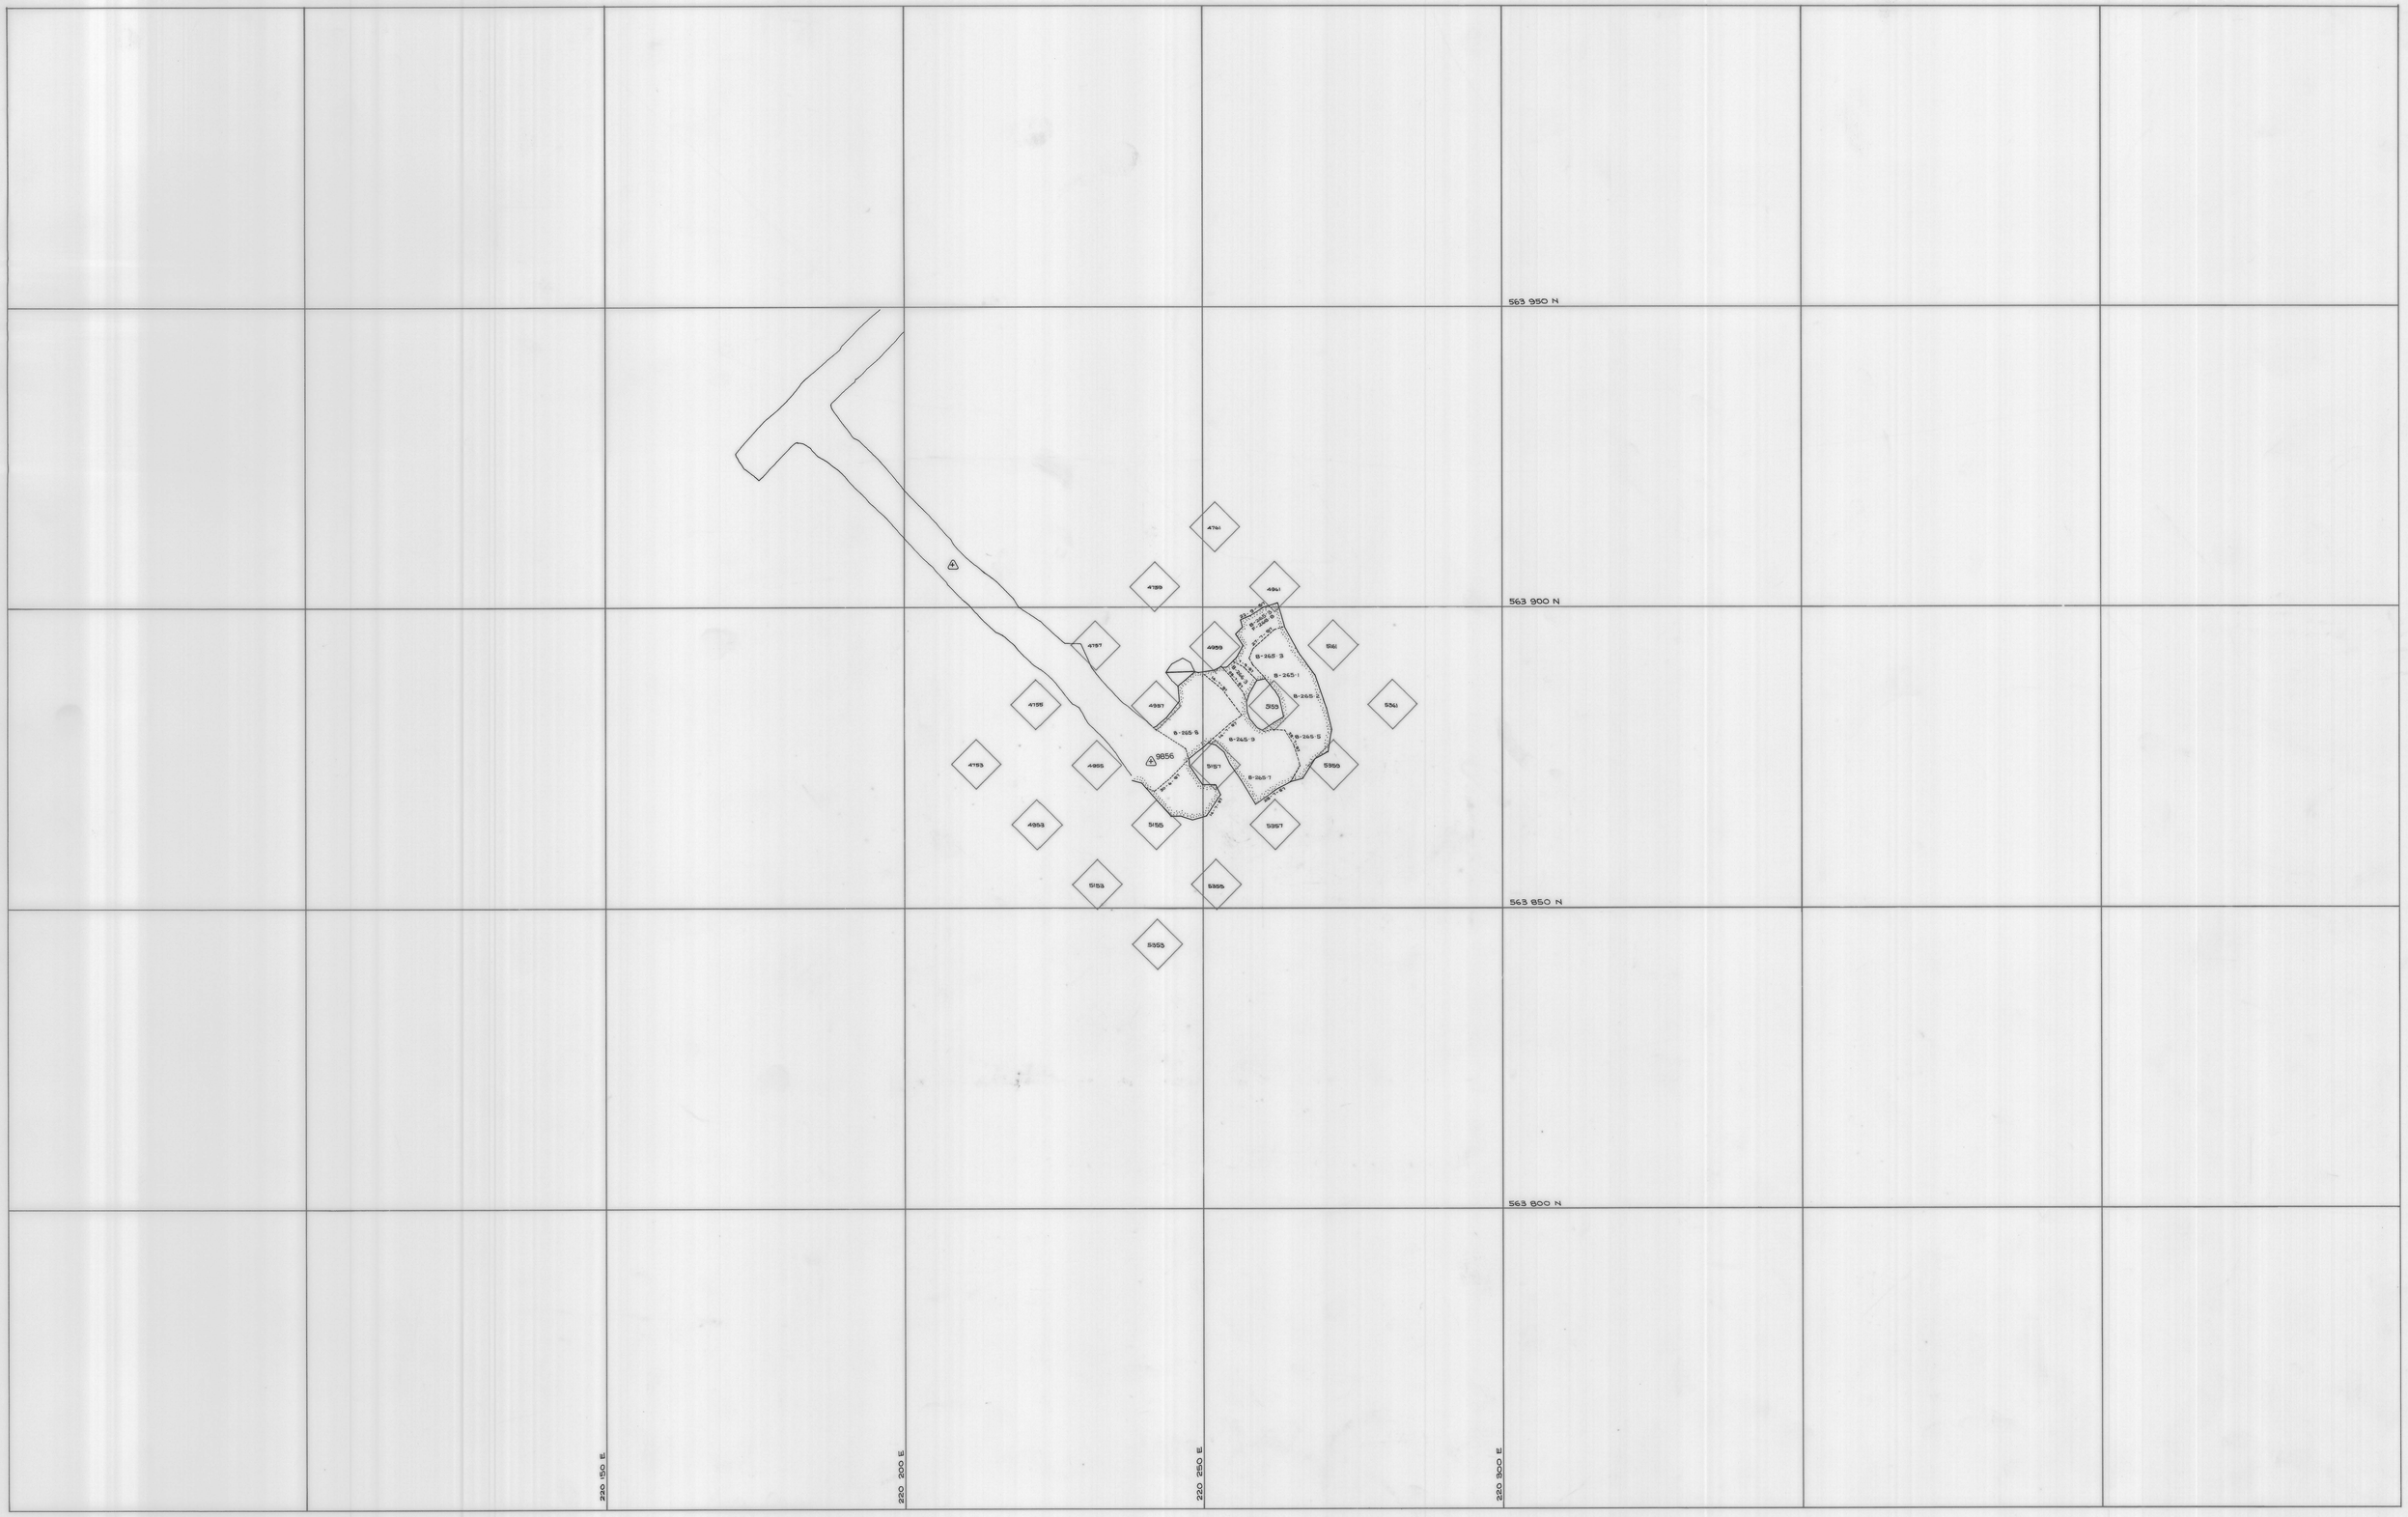

SCALE 1:500

5 cm

north

LOCATION
DOLPHIN MINE

SUBJECT
SWAN STOPE
1st lift

KING ISLAND SCHEELITE
A DIVISION OF WARMAN INTERNATIONAL

GRASSY KING ISLAND

PLAN NUMBER
04DM15 - 1072