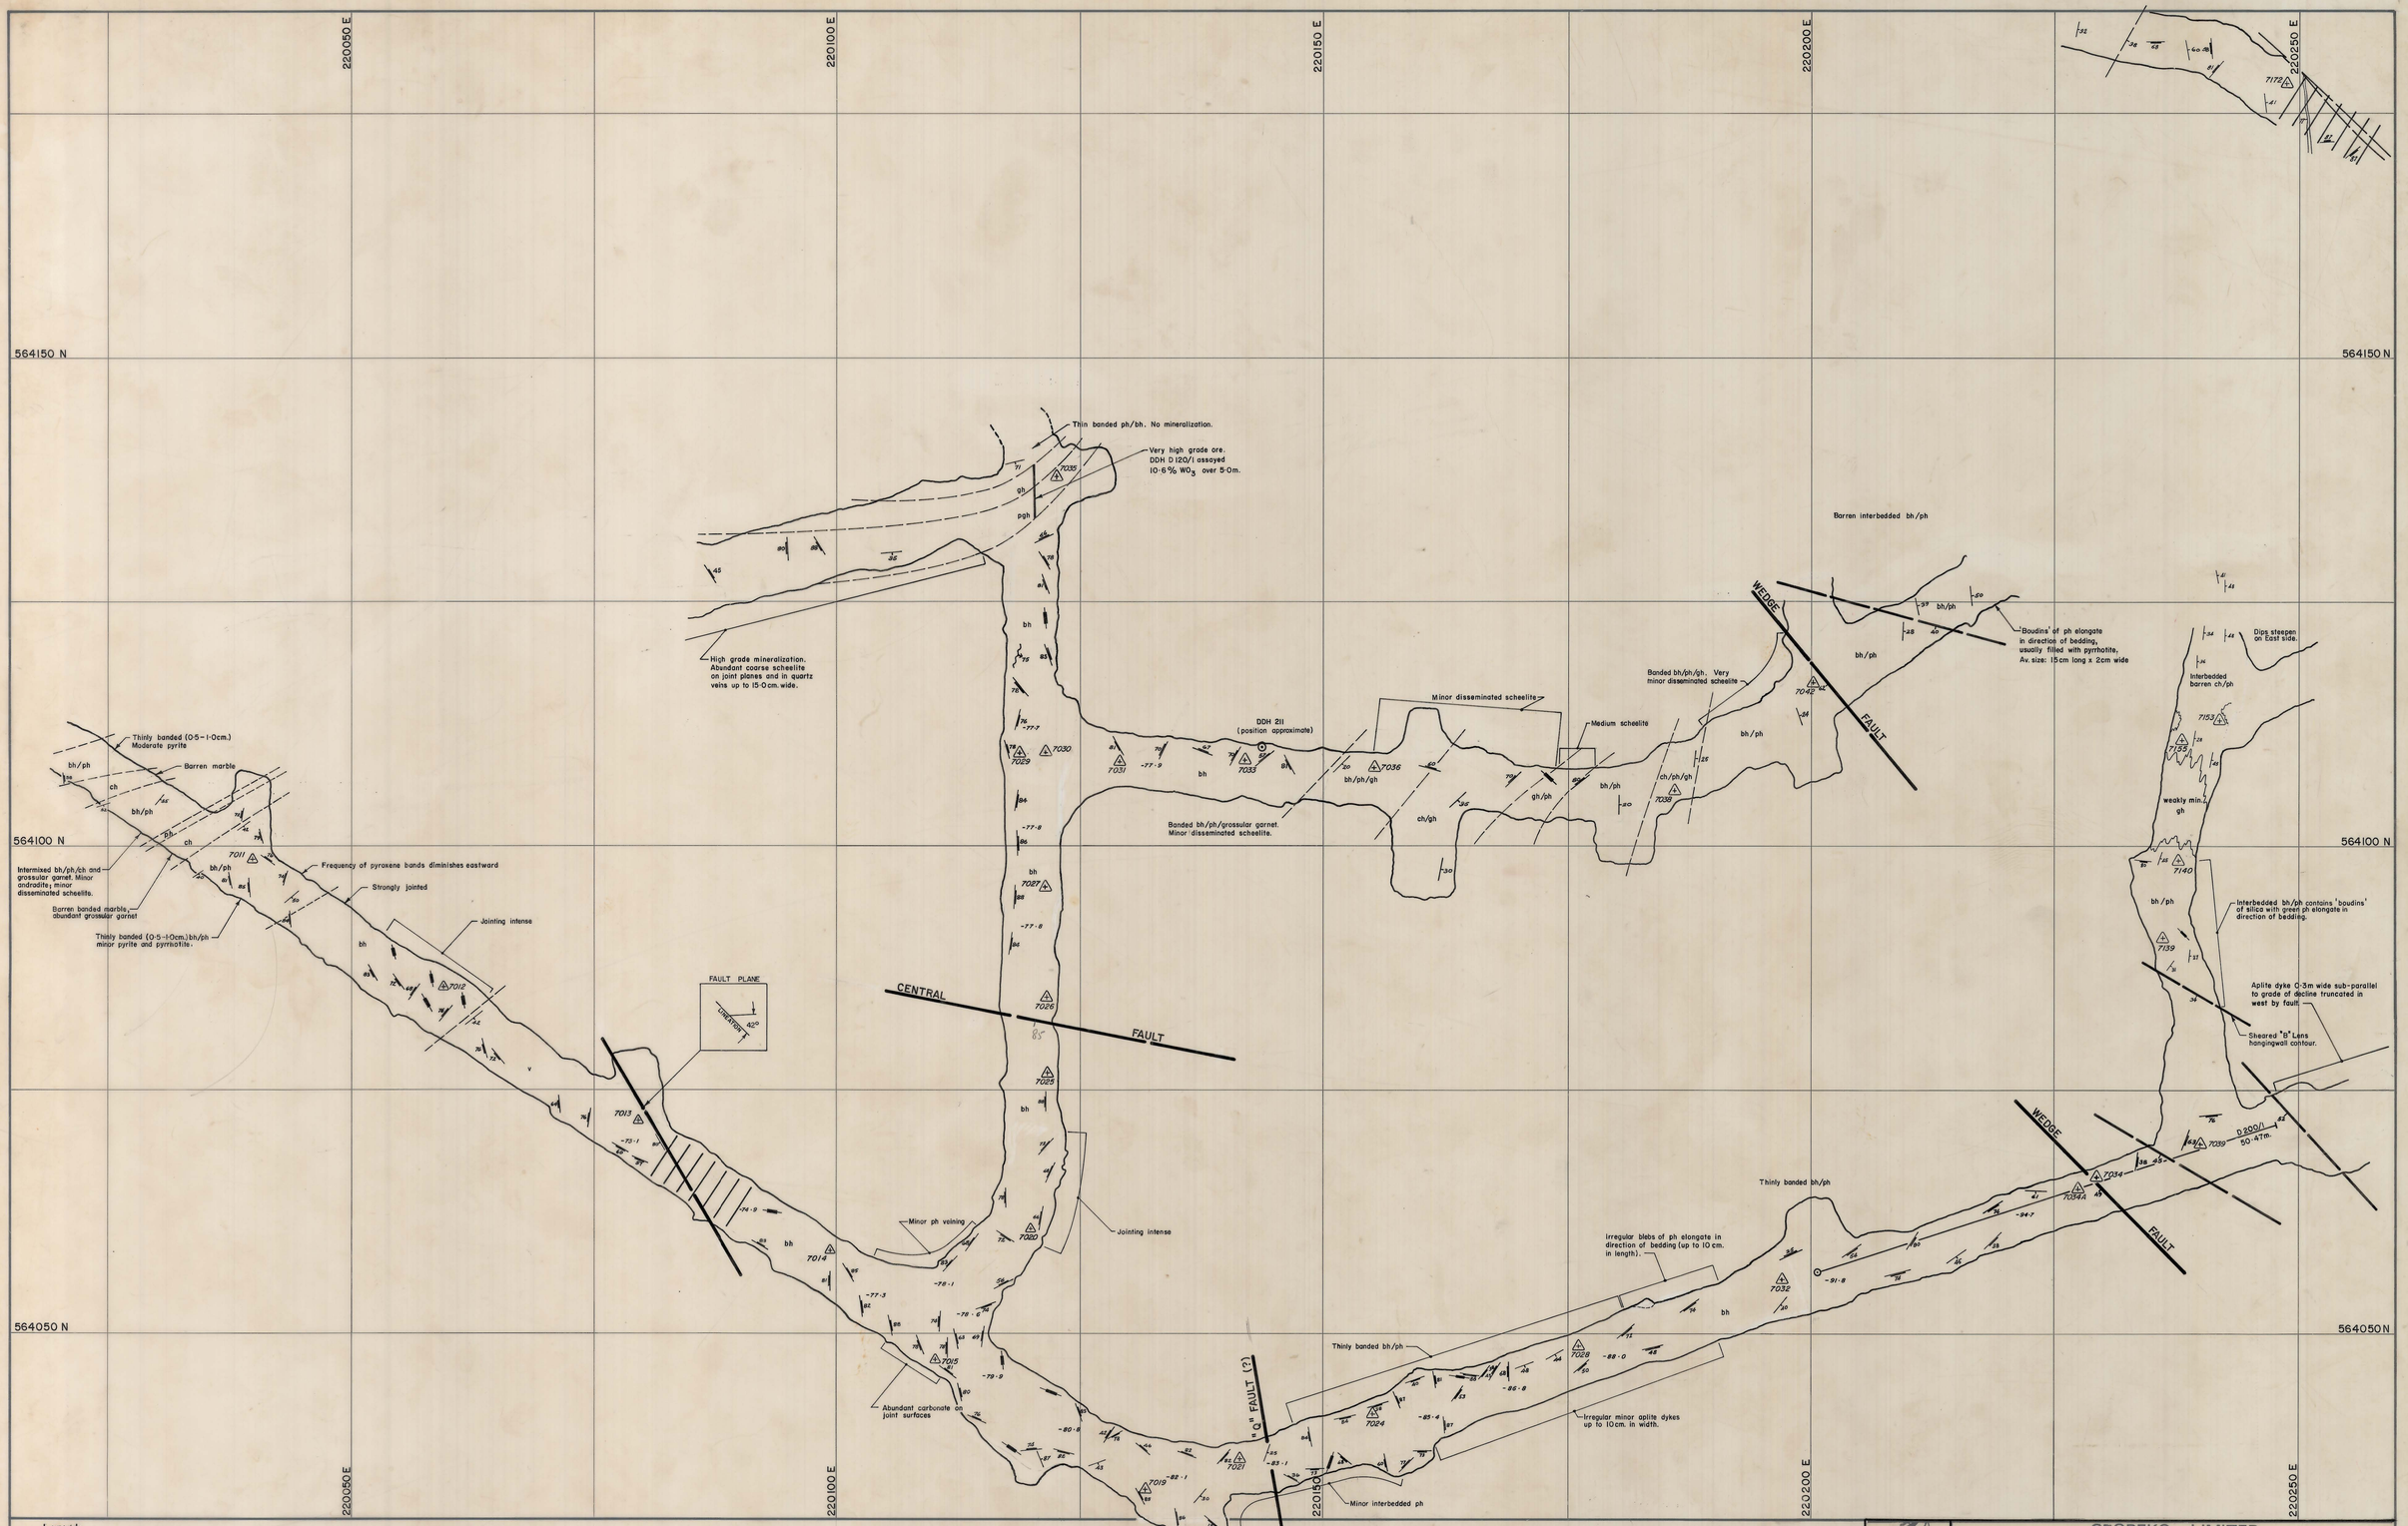KG2-07-002
DECLINE
07
0374_4656