0374_4673

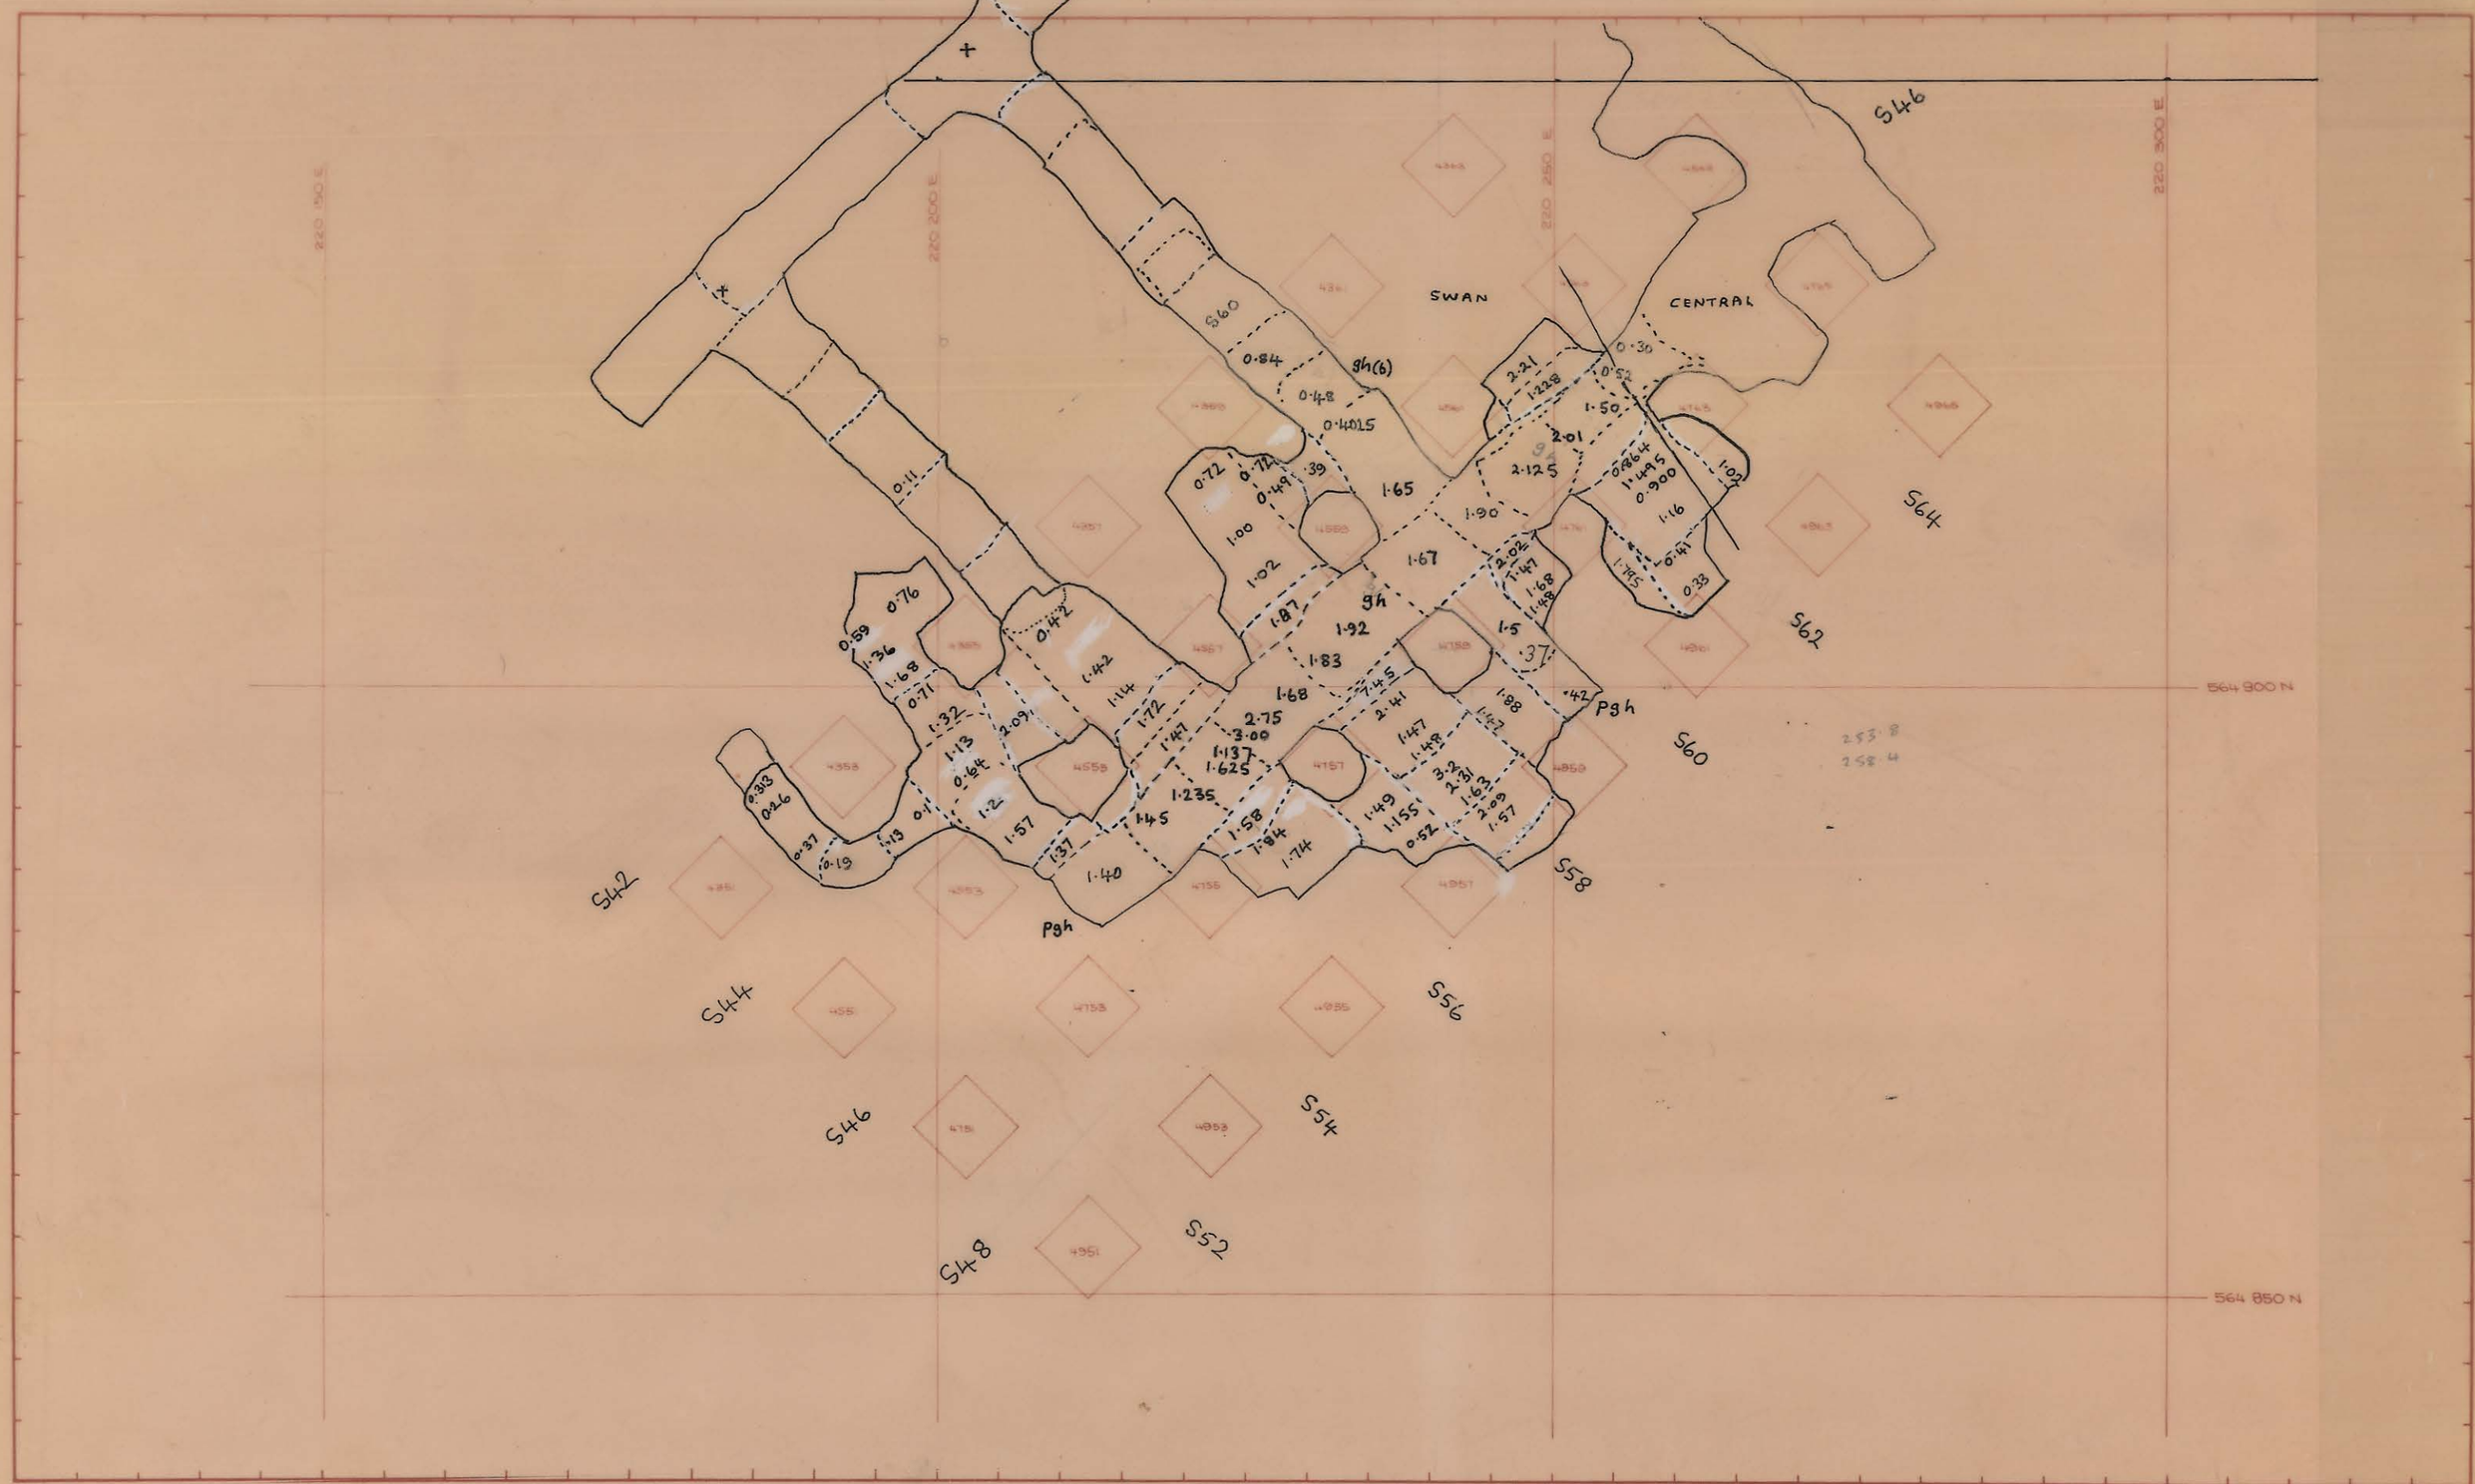

REF PLAN	GEOLOGY		
BACK – 253·5	SURVEY		
FLOOR – 258·5	PLANNING		
	ROCK MEC.		
	GRADE CON	AD7	1986
	DRAFTING		
	T.S.S.		

SCALE 1: 500

KIS KING ISLAND SCHEELITE GRASSY KING ISLAND

LIFT 04

LOWER CENTRAL & SWAN (SOUTHERN) STOPES

(– 253 mL)

DRAWING NUMBER