


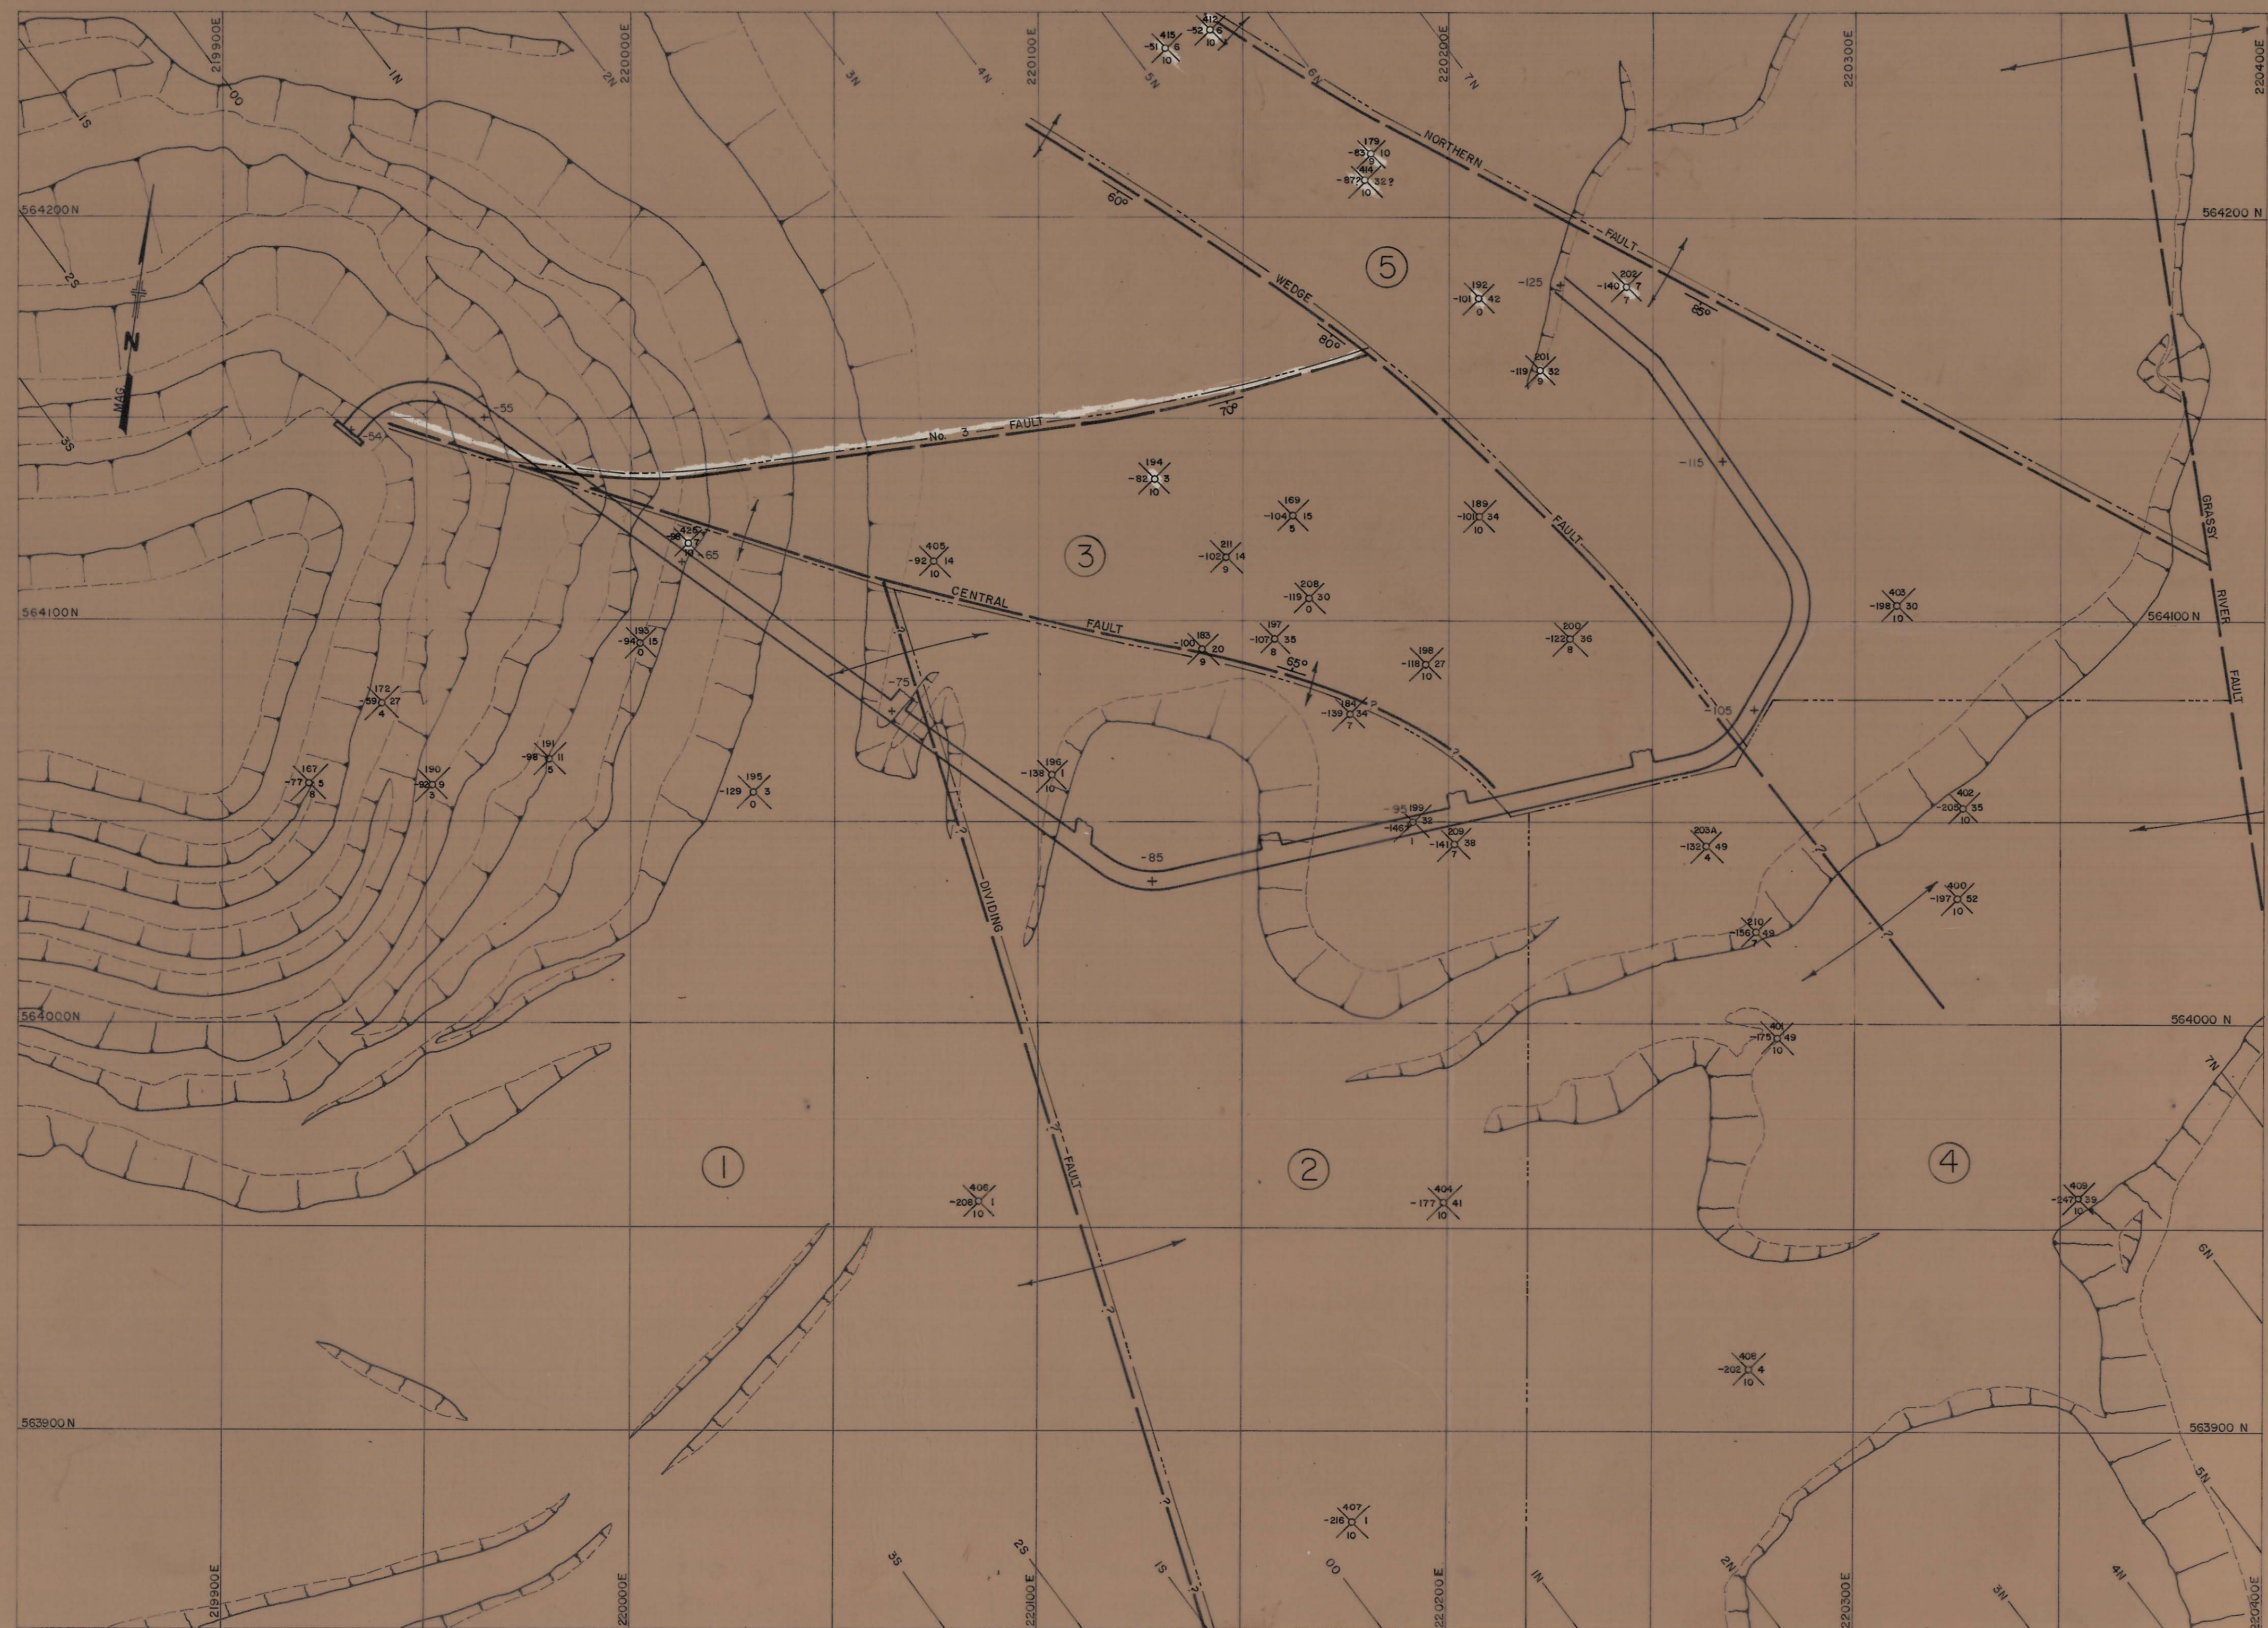

Legend

- v Upper meta-volcanics
- bh Biotite ± actinolite hornfels
- ph B lens pyroxene hornfels
- ch B lens marble

- pgf Pyroxene garnet hornfels
- gh C lens skarn
- Fault
- Uncertainty in fault position

- 105 FLOOR R.L. OF DECLINE
- DDH No. / HANGINGWALL R.L. / TOTAL ORE THICKNESS (metres)
- HANGINGWALL THICKNESS AVERAGED (metres)
- 2 BLOCKS WITHIN OREBODY
- BLOCK BOUNDARY

NOTE:
1. DECLINE POSITION AS AT MAY 10, 1973.



DATE: JULY, 1973
GEOLOGIST: D.H.M.
DRAWN: R.E.
CHECKED: M.C.R.

GEOPEKO LIMITED
KING ISLAND GROUP

SCALE: 1:1000

No. KG2-02-024

DOLPHIN MINE
MISCELLANEOUS PARAMETERS
PLAN PROJECTION