27 JUN 1981

0374_4697

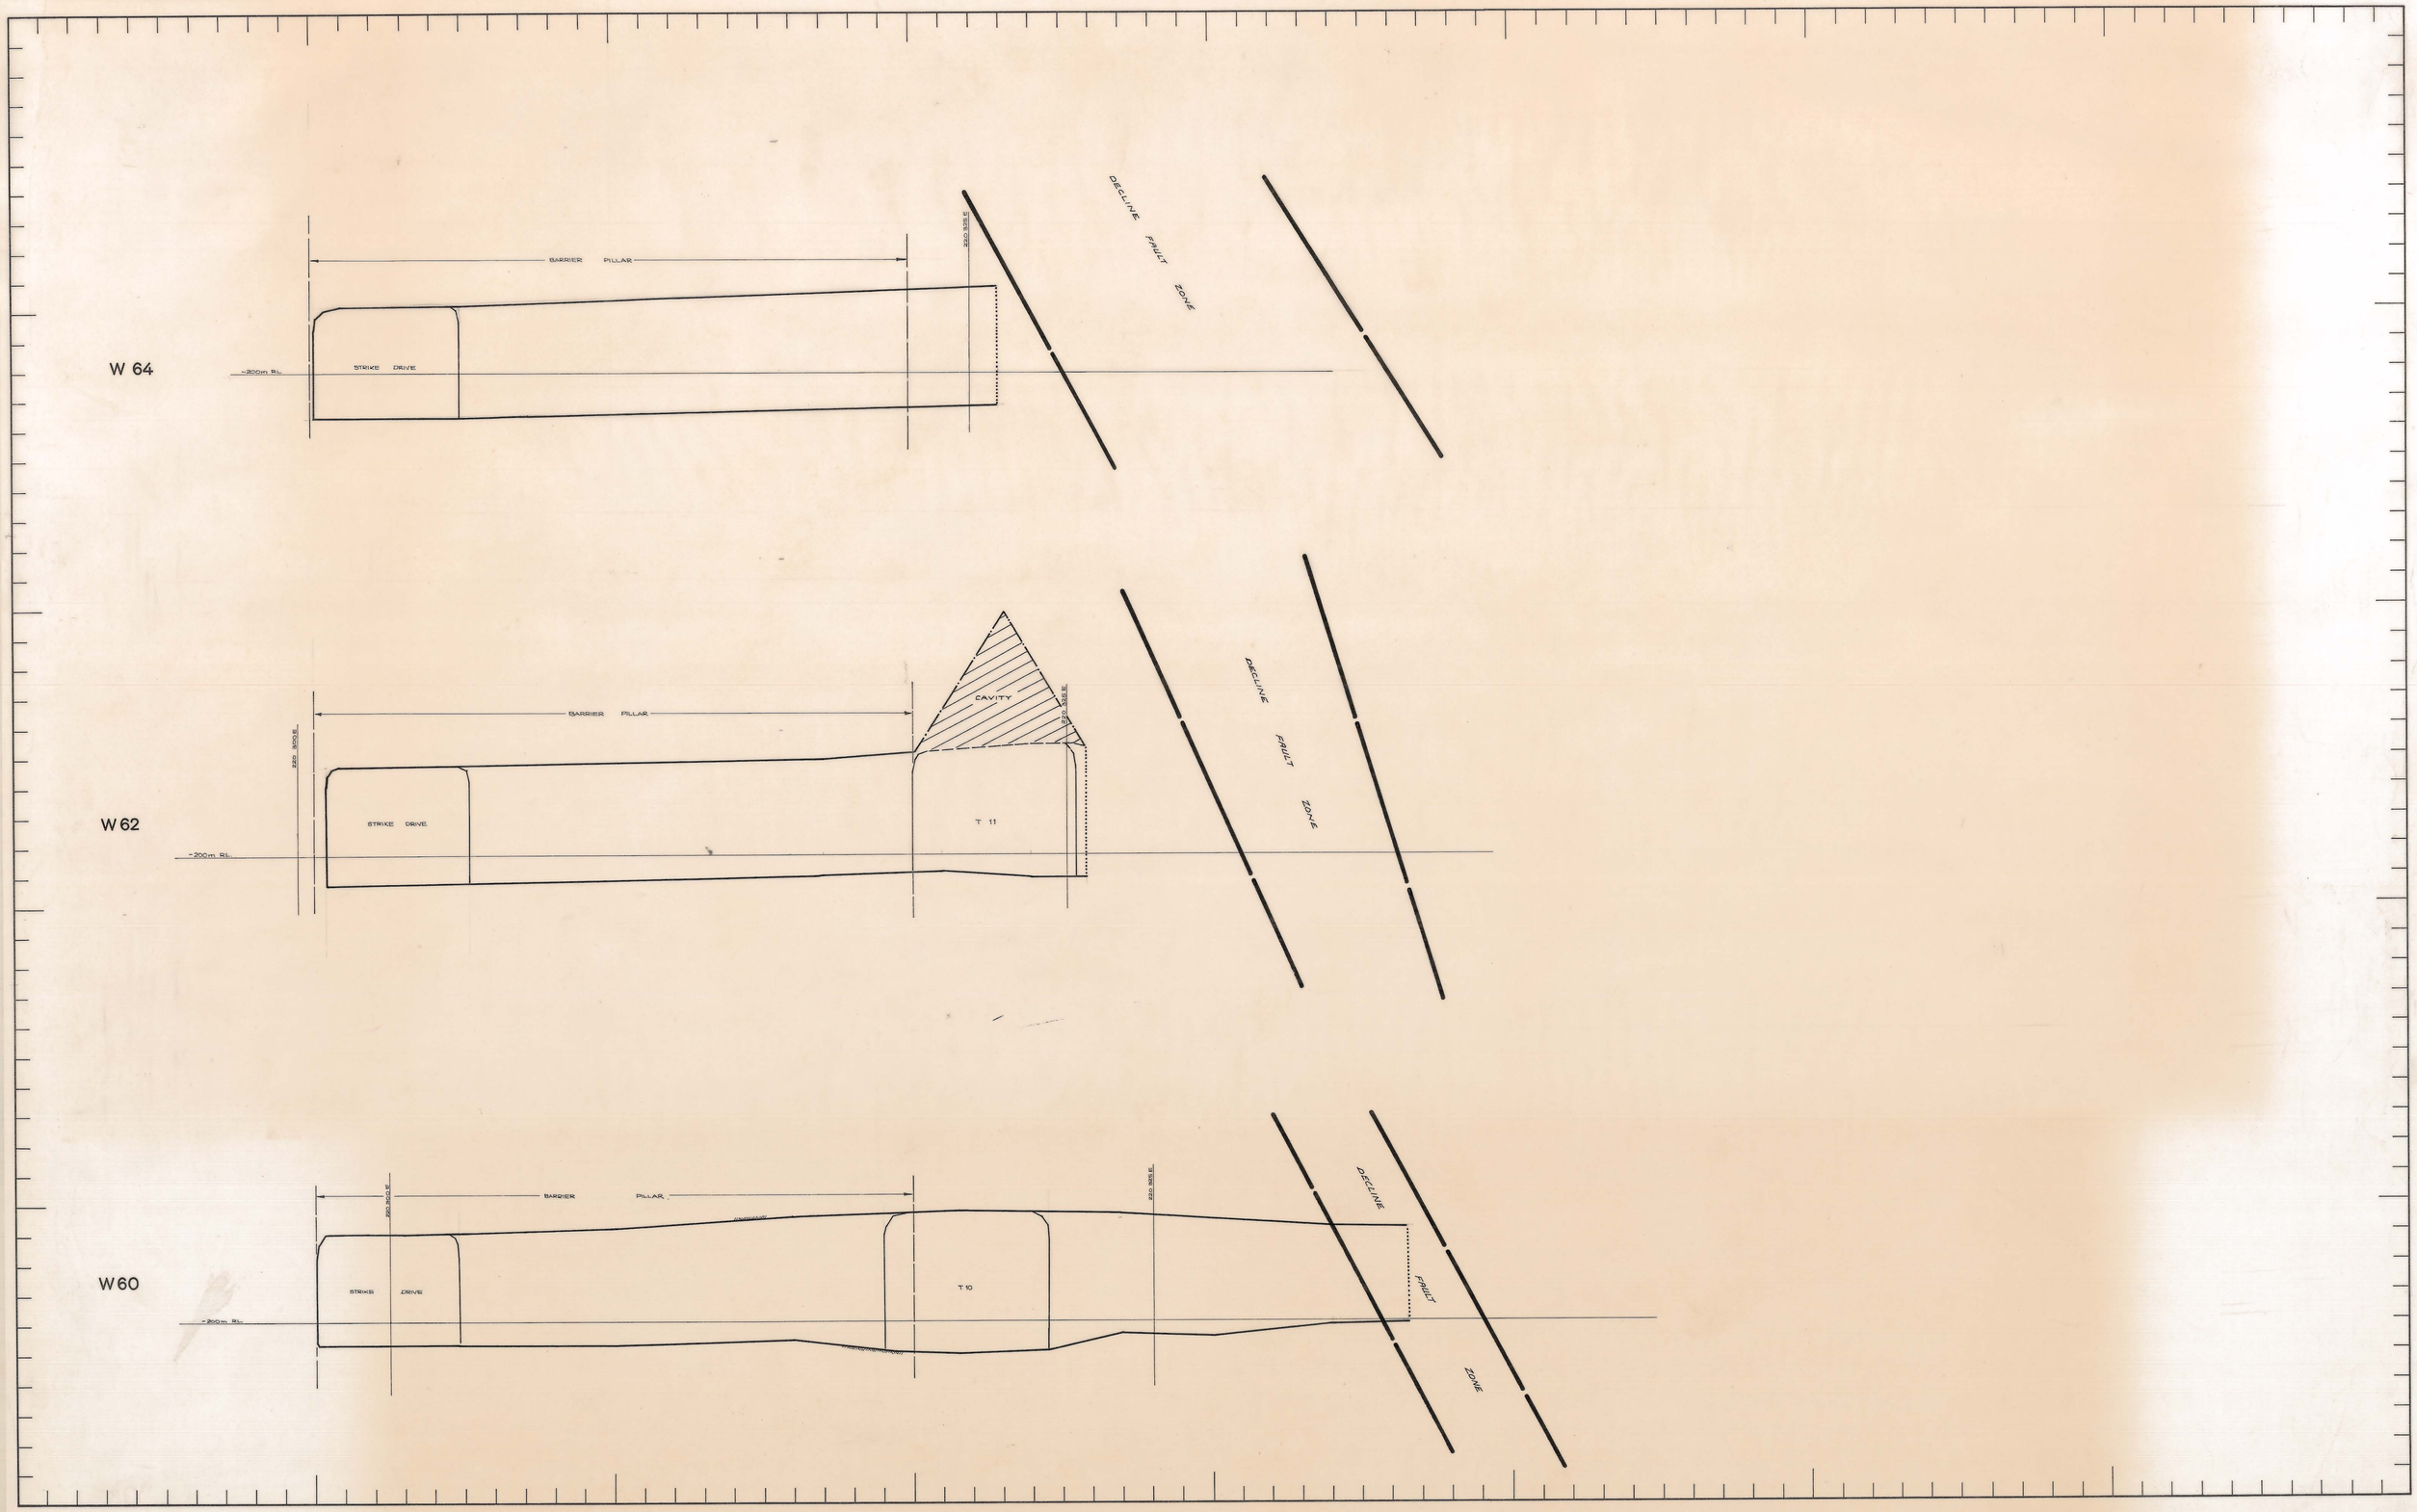

REVISIONS			
Nº	DATE		INITIALS

APPROVAL	INITIALS	DATE
PLANNING ENGINEER		
SNR. PLANNING ENGINEER		
TECHNICAL SERVICES SUPT.		
GENERAL MINING SUPT.		
MINE SUPT.		
SNR. SURVEYOR		
SNR. GEOLOGIST		
DOLPHIN GEOLOGIST	R.E.S.D.	3-2-81

SCALE 1:100

LOCATION: DOLPHIN MINE

SUBJECT: CENTRELINE SECTIONS OF -200m W64, W62, W60, LOWER WEDGE OREBODY

KING ISLAND SCHEELITE
A Member of the Peko Wallsend Group
GRASSY KING ISLAND

PRELIMINARY ☐ FINAL ☐

PLAN NUMBER