B LENS MAIN
1604 BHIS-1004
0374_4767

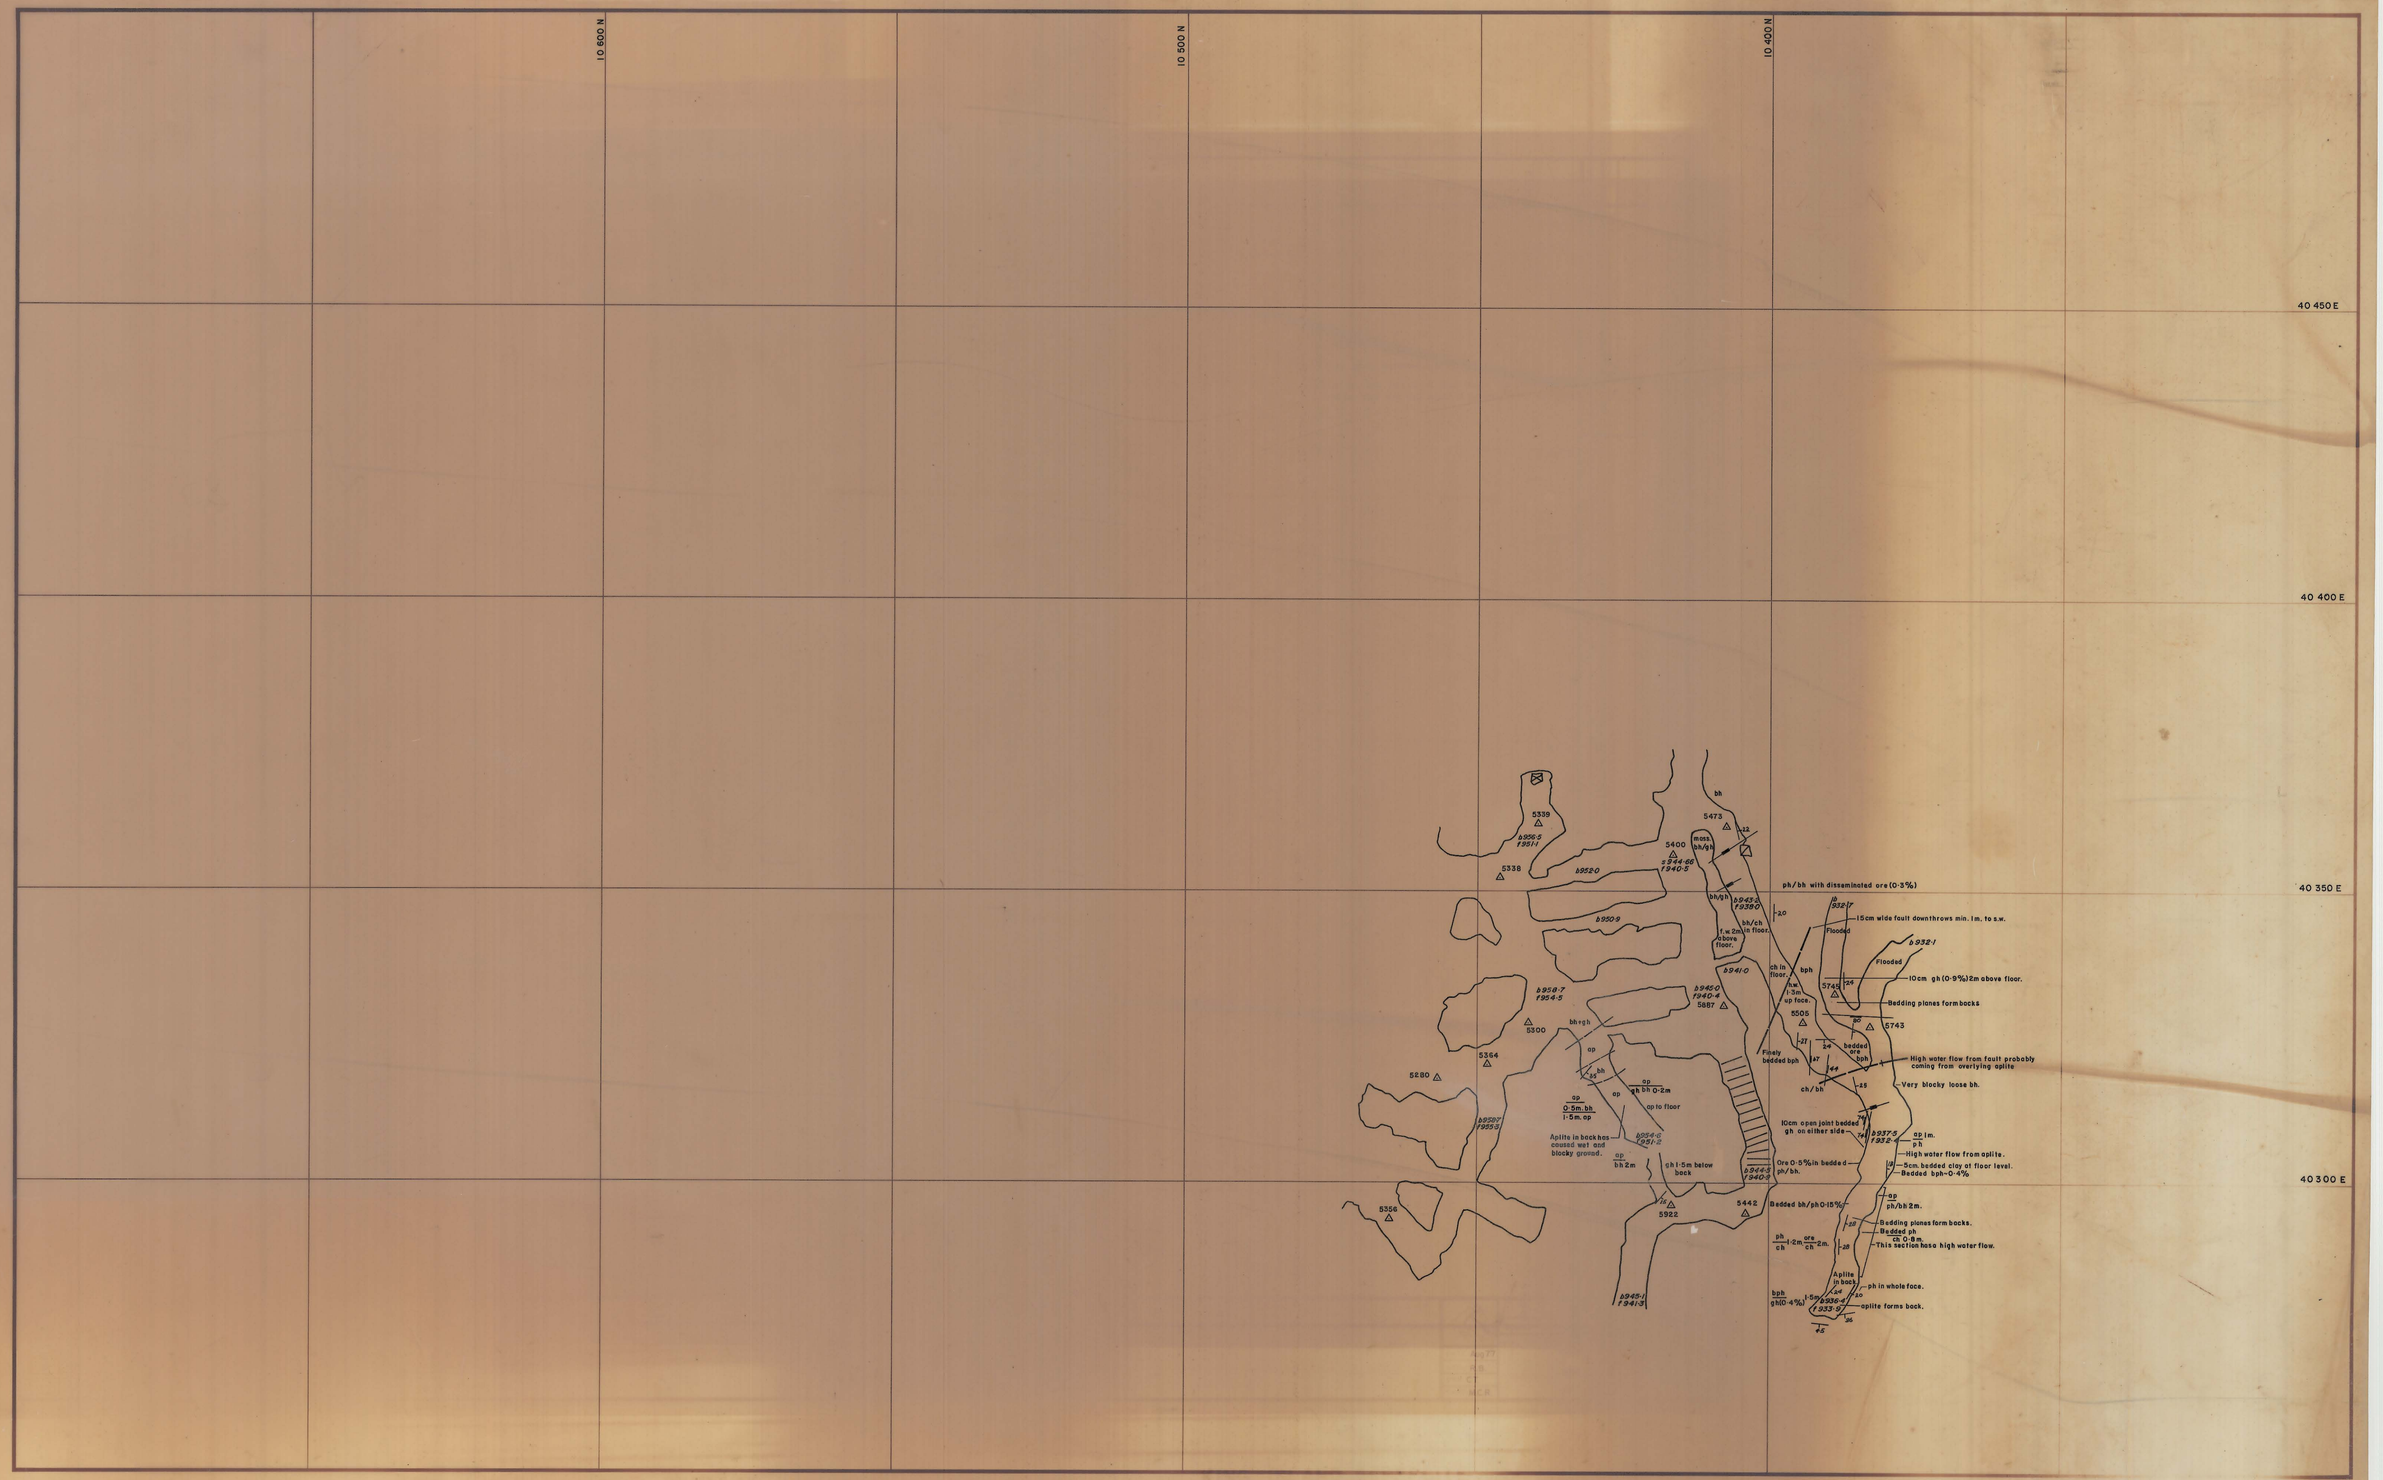


LEGEND:

- V — Upper metavolcanics
- bh/gh, bh/ph — Banded footwall beds
- bph — Biotite pyroxene hornfels
- bh — Banded hornfels
- ch — Marble
- bh — Biotite hornfels
- pgh — Pyroxene garnet hornfels
- Garnet hornfels
- strike and dip
- strike and dip vertical
- joint
- joint vertical
- geological boundary
- minor fault
- major fault
- b — back
- f — floor
- r — road
- s — spad

Note: op / gh 1·5m means aplite/gh contact is 1·5m above floor.

op 1·5m / gh means aplite/gh contact is 1·5m below back.

KING ISLAND S

SCALE 1:500

04 BHIS-1004

DATE:
DRAWN: M.vdS.
GEOLOGY: R.E.S-D
CHECKED:

BOLD HEAD MINE

B LENS - MAIN