27 JUN 1981

FAULT BLOCK
LIFT N°5

5 cm

0374_4790

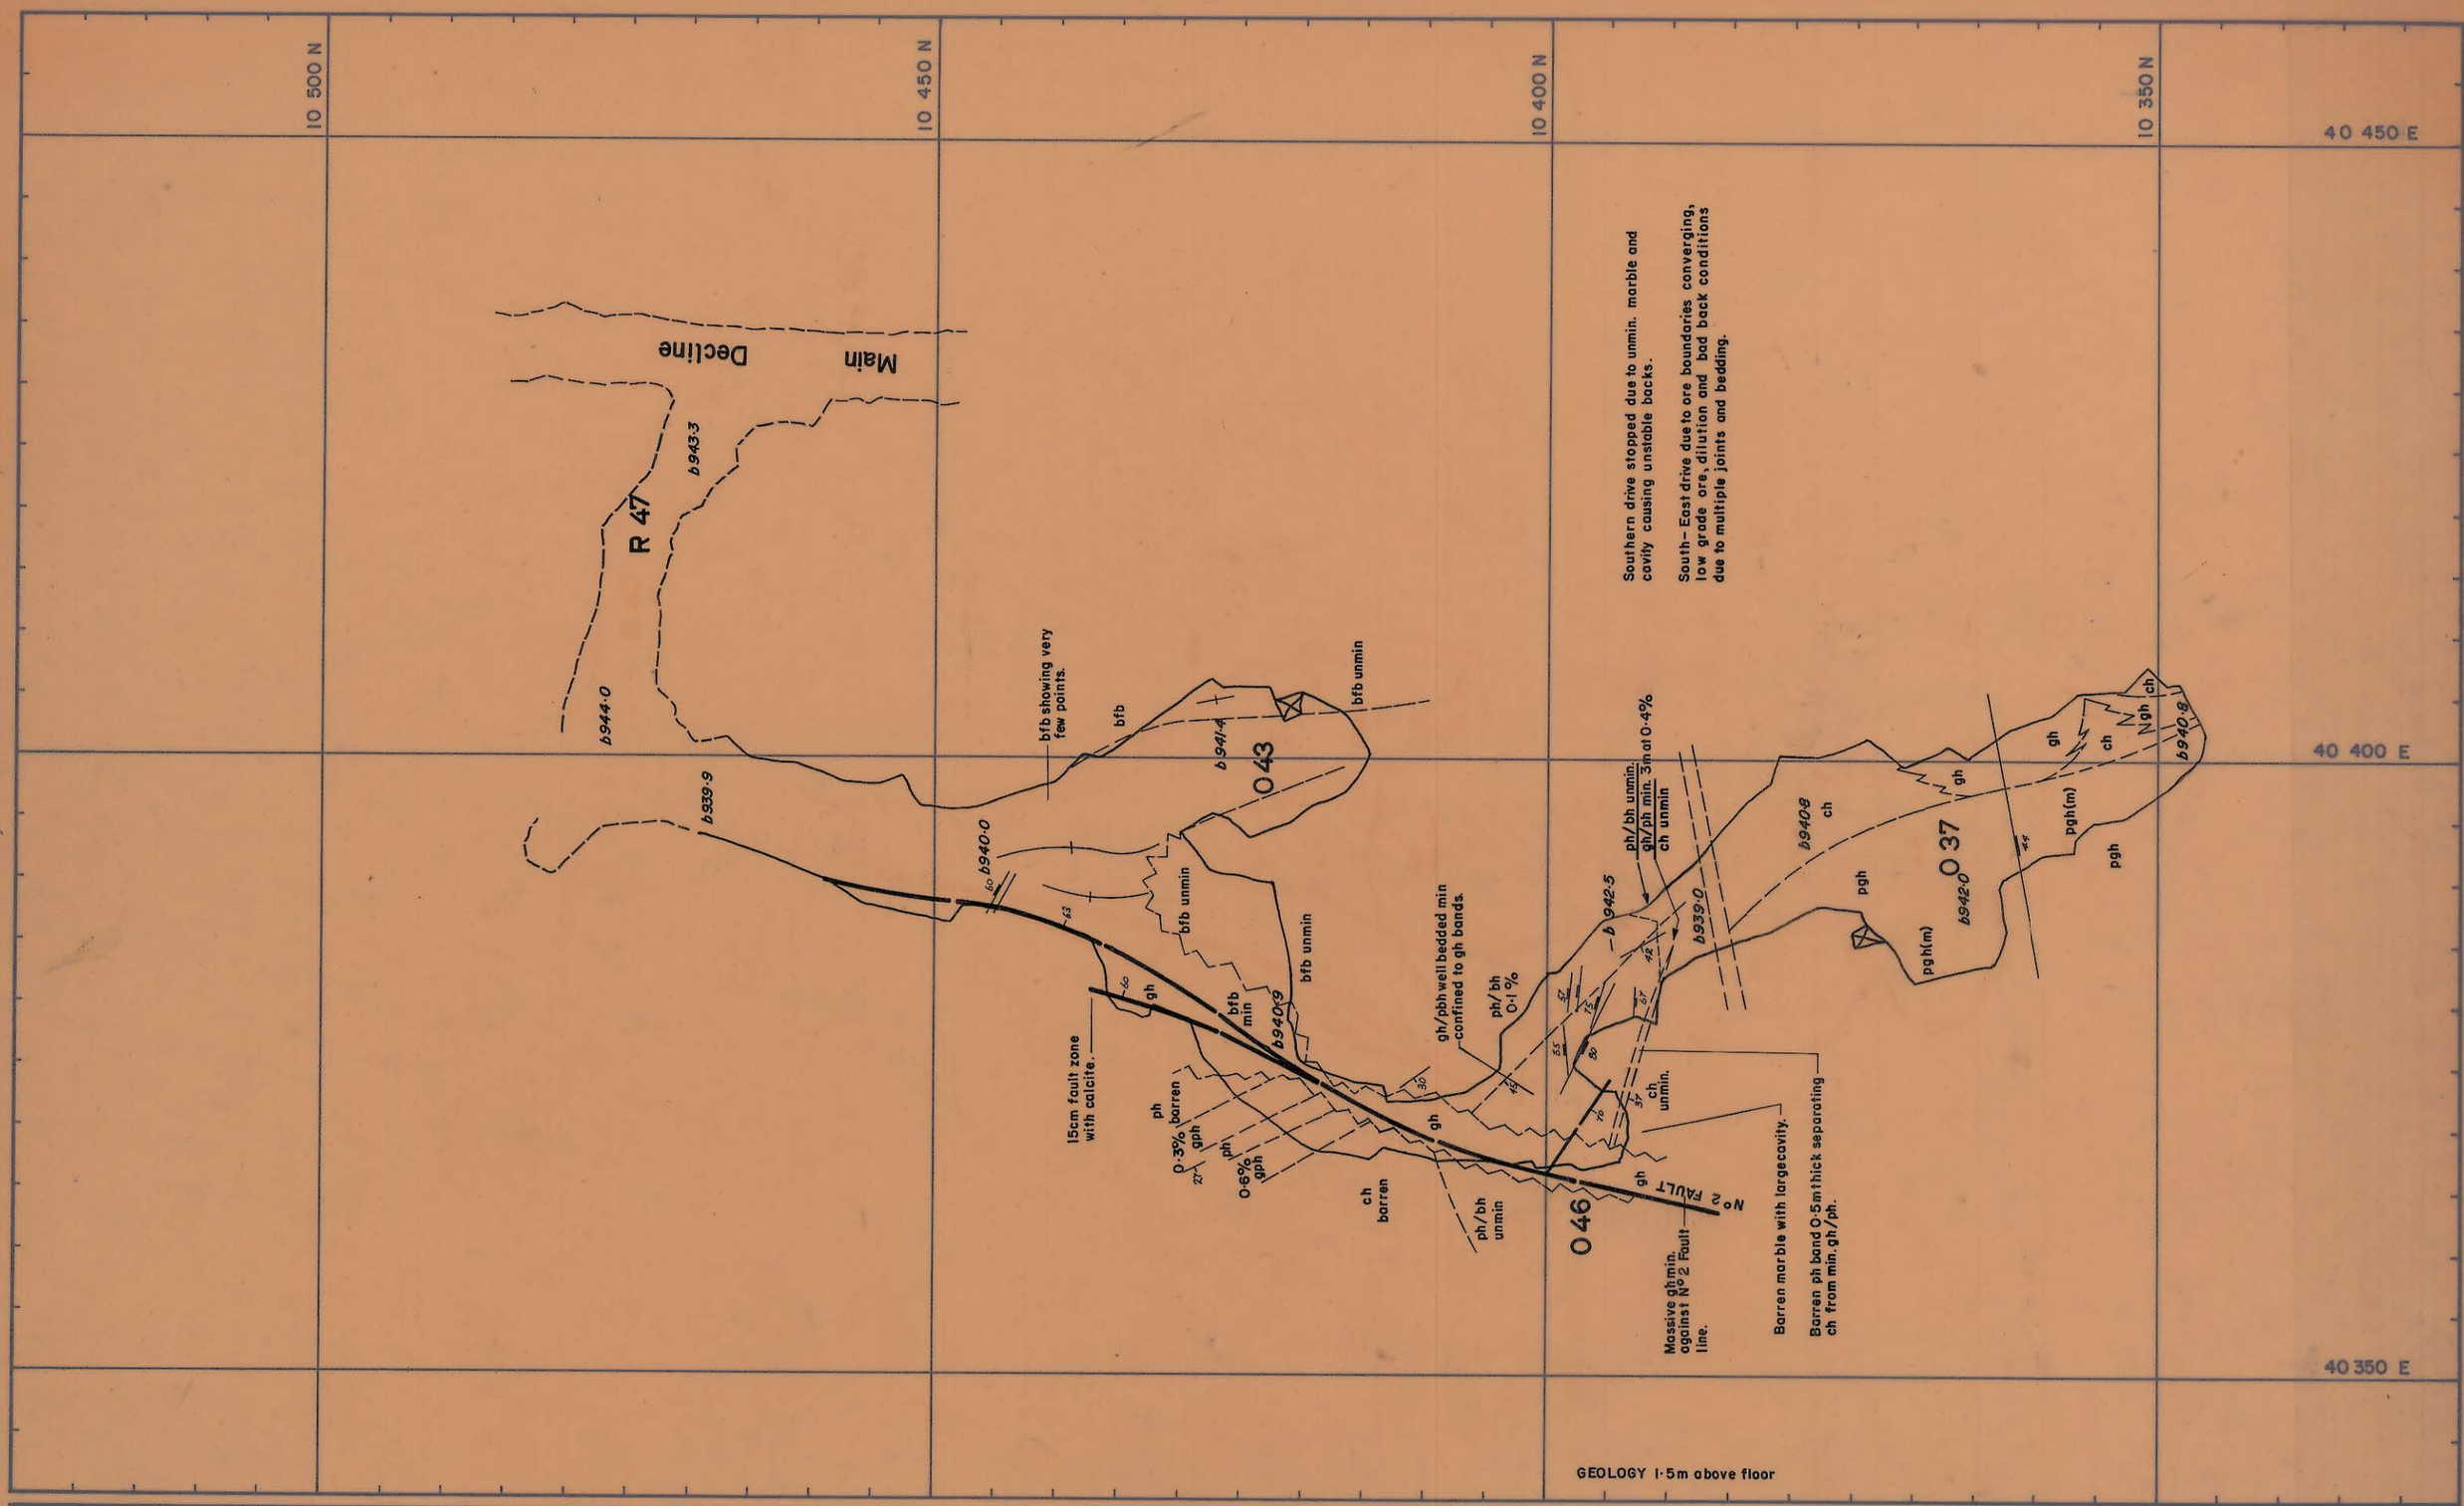

REF. PLAN

O 46 mapped by T.F.P. June '80

O 37 mapped by R.E.S-D.

GEOLOGY		
SURVEY		
PLANNING		
ROCK MEC.		
GRADE CON.		
DRAFTING	M.vdS.	
T.S.S.		

SCALE 1:500

KING ISLAND SCHEELITE
GRASSY KING ISLAND

BOLD HEAD MINE

FAULT BLOCK
Lift n° 5

DRAWING NUMBER