27 JUN 1981

FAULT BLOCK
UNDER CUT

5 cm

0374_4795

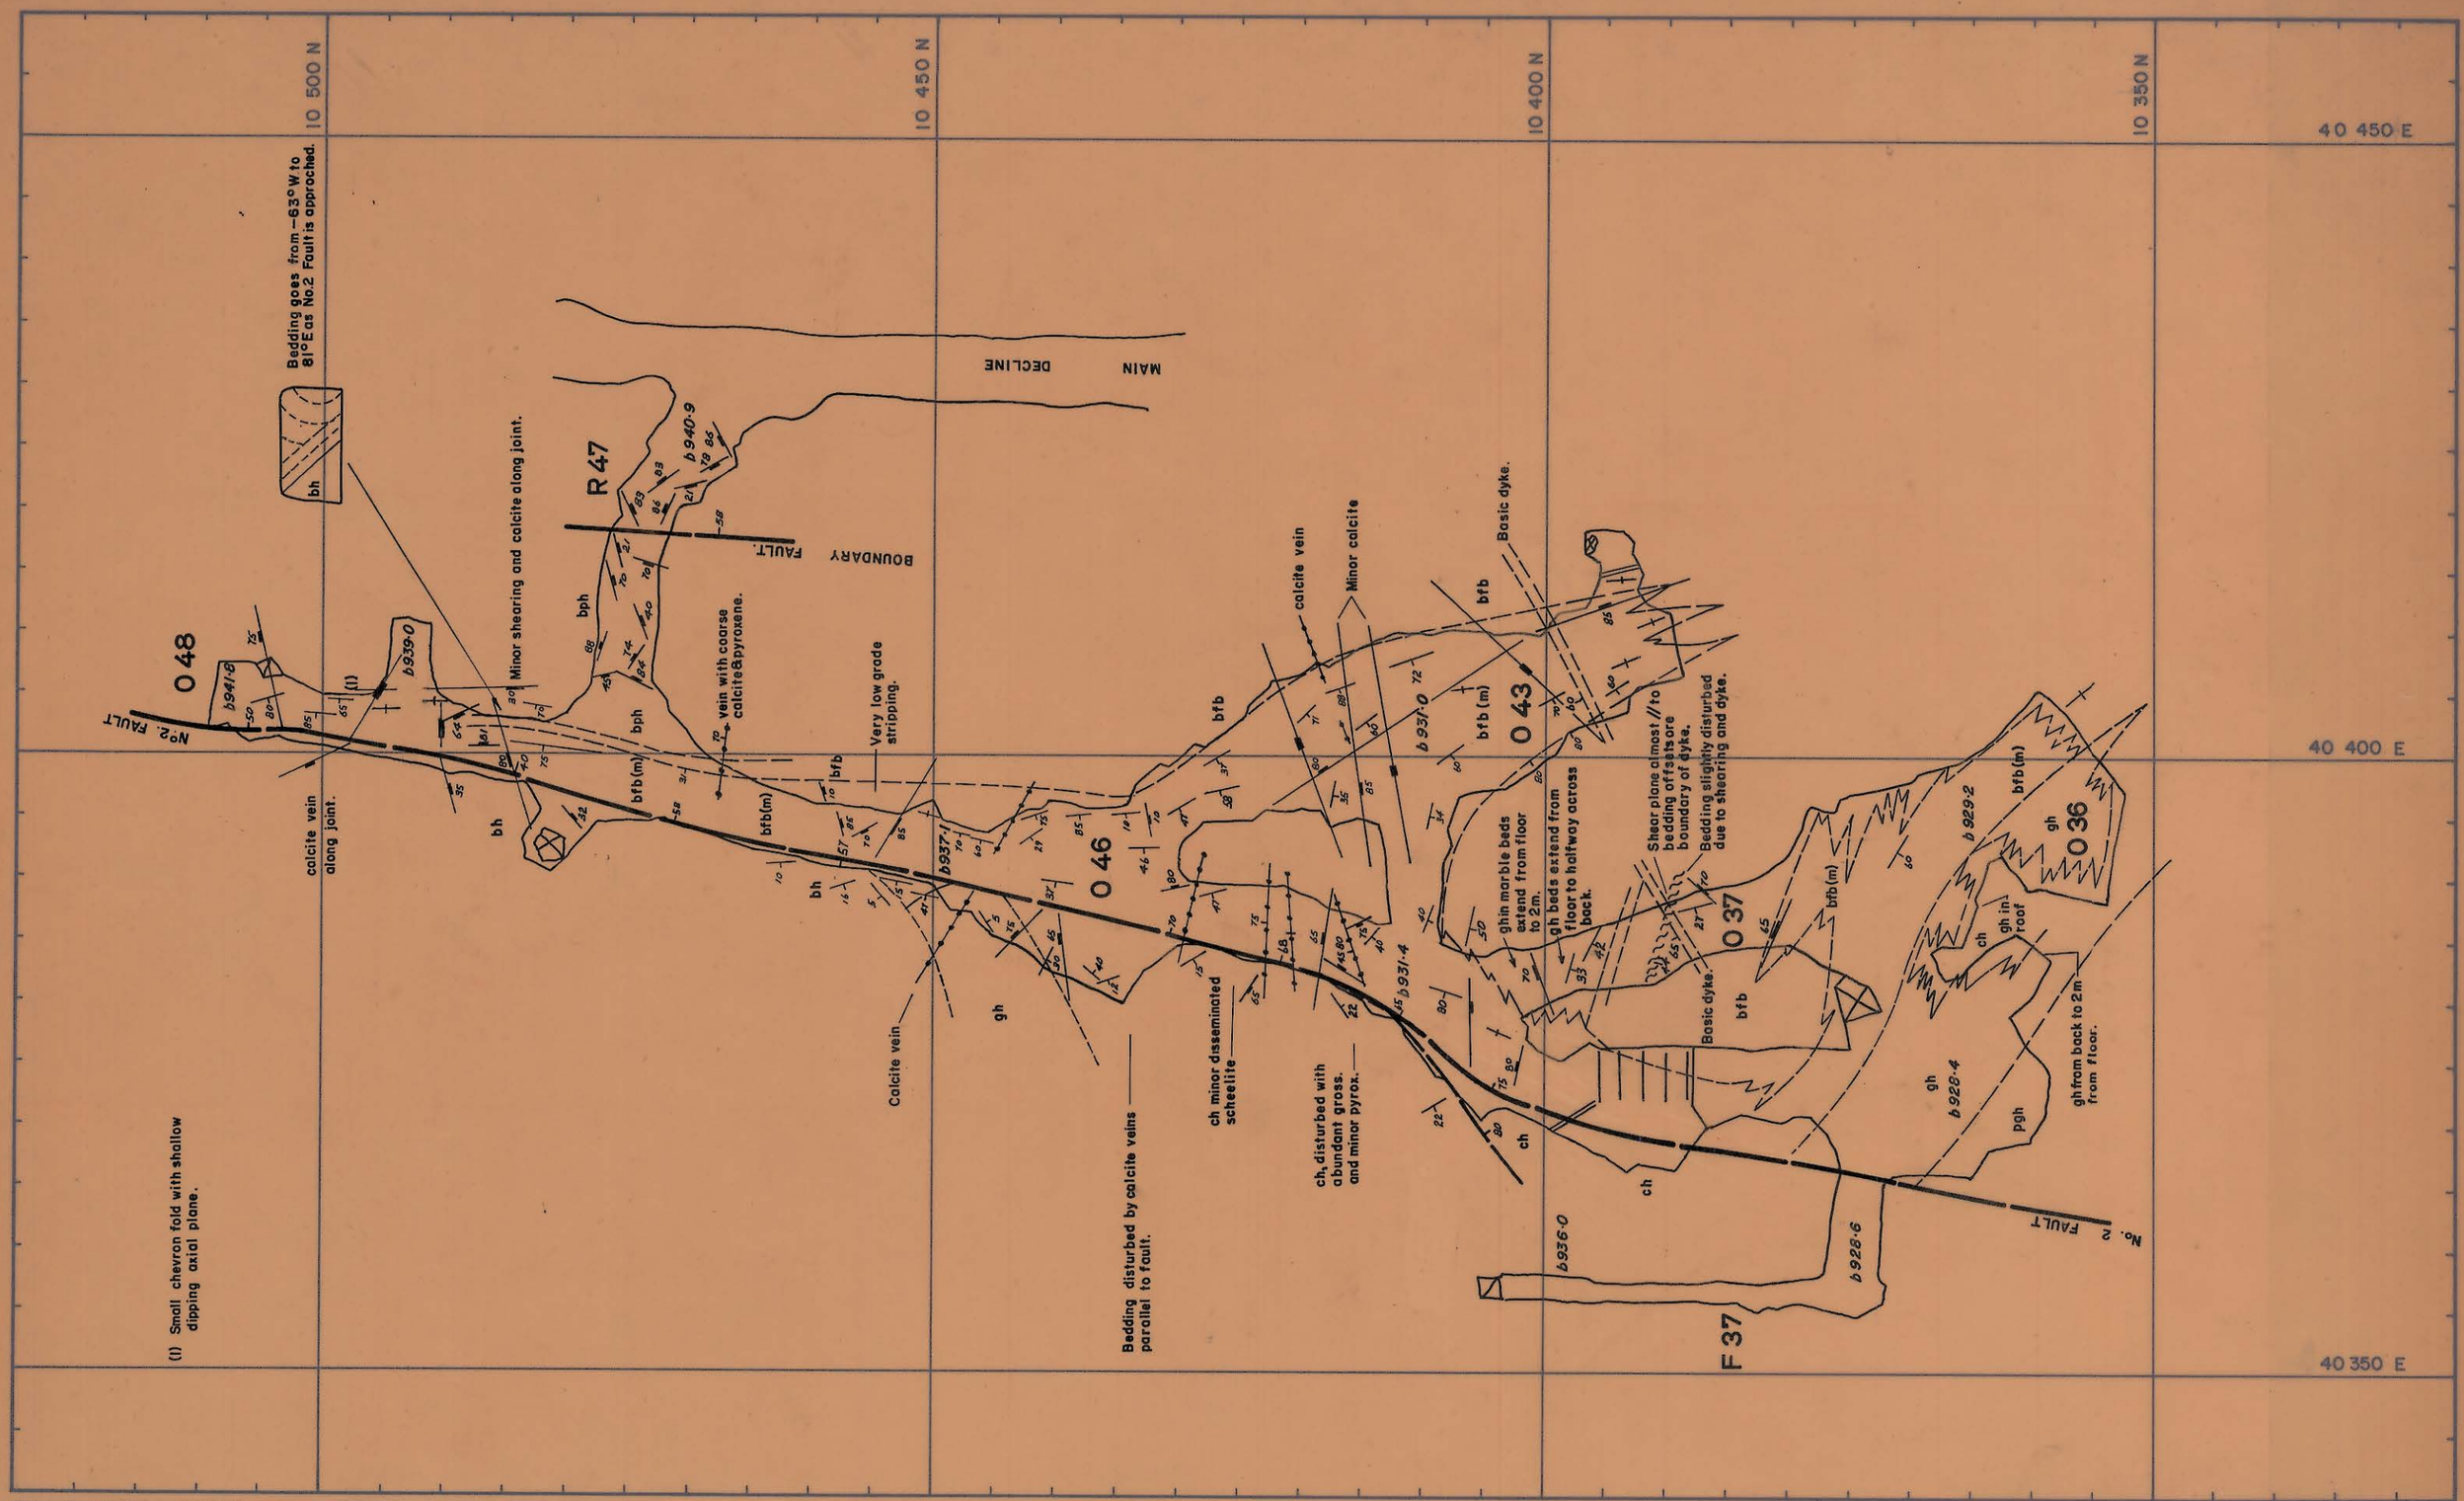

REF. PLAN

Geology from stope mapping and fortnight booklet
R 40, R 47 mapped S.G.B. July '77 stopes mapped J.M.C

GEOLOGY	J.M.C.	July 77
SURVEY		
PLANNING		
ROCK MEC.		
GRADE CON.		
DRAFTING	M.vdS.	
T.S.S.		

SCALE 1:500

KING ISLAND SCHEELITE
GRASSY KING ISLAND

BOLD HEAD MINE

FAULT BLOCK
Lift nº. Under Cut

DRAWING NUMBER