27 JUN 1981

C2 LENS OREBODY
R60 STOPE 4th LIFT

5 cm

0374_4799

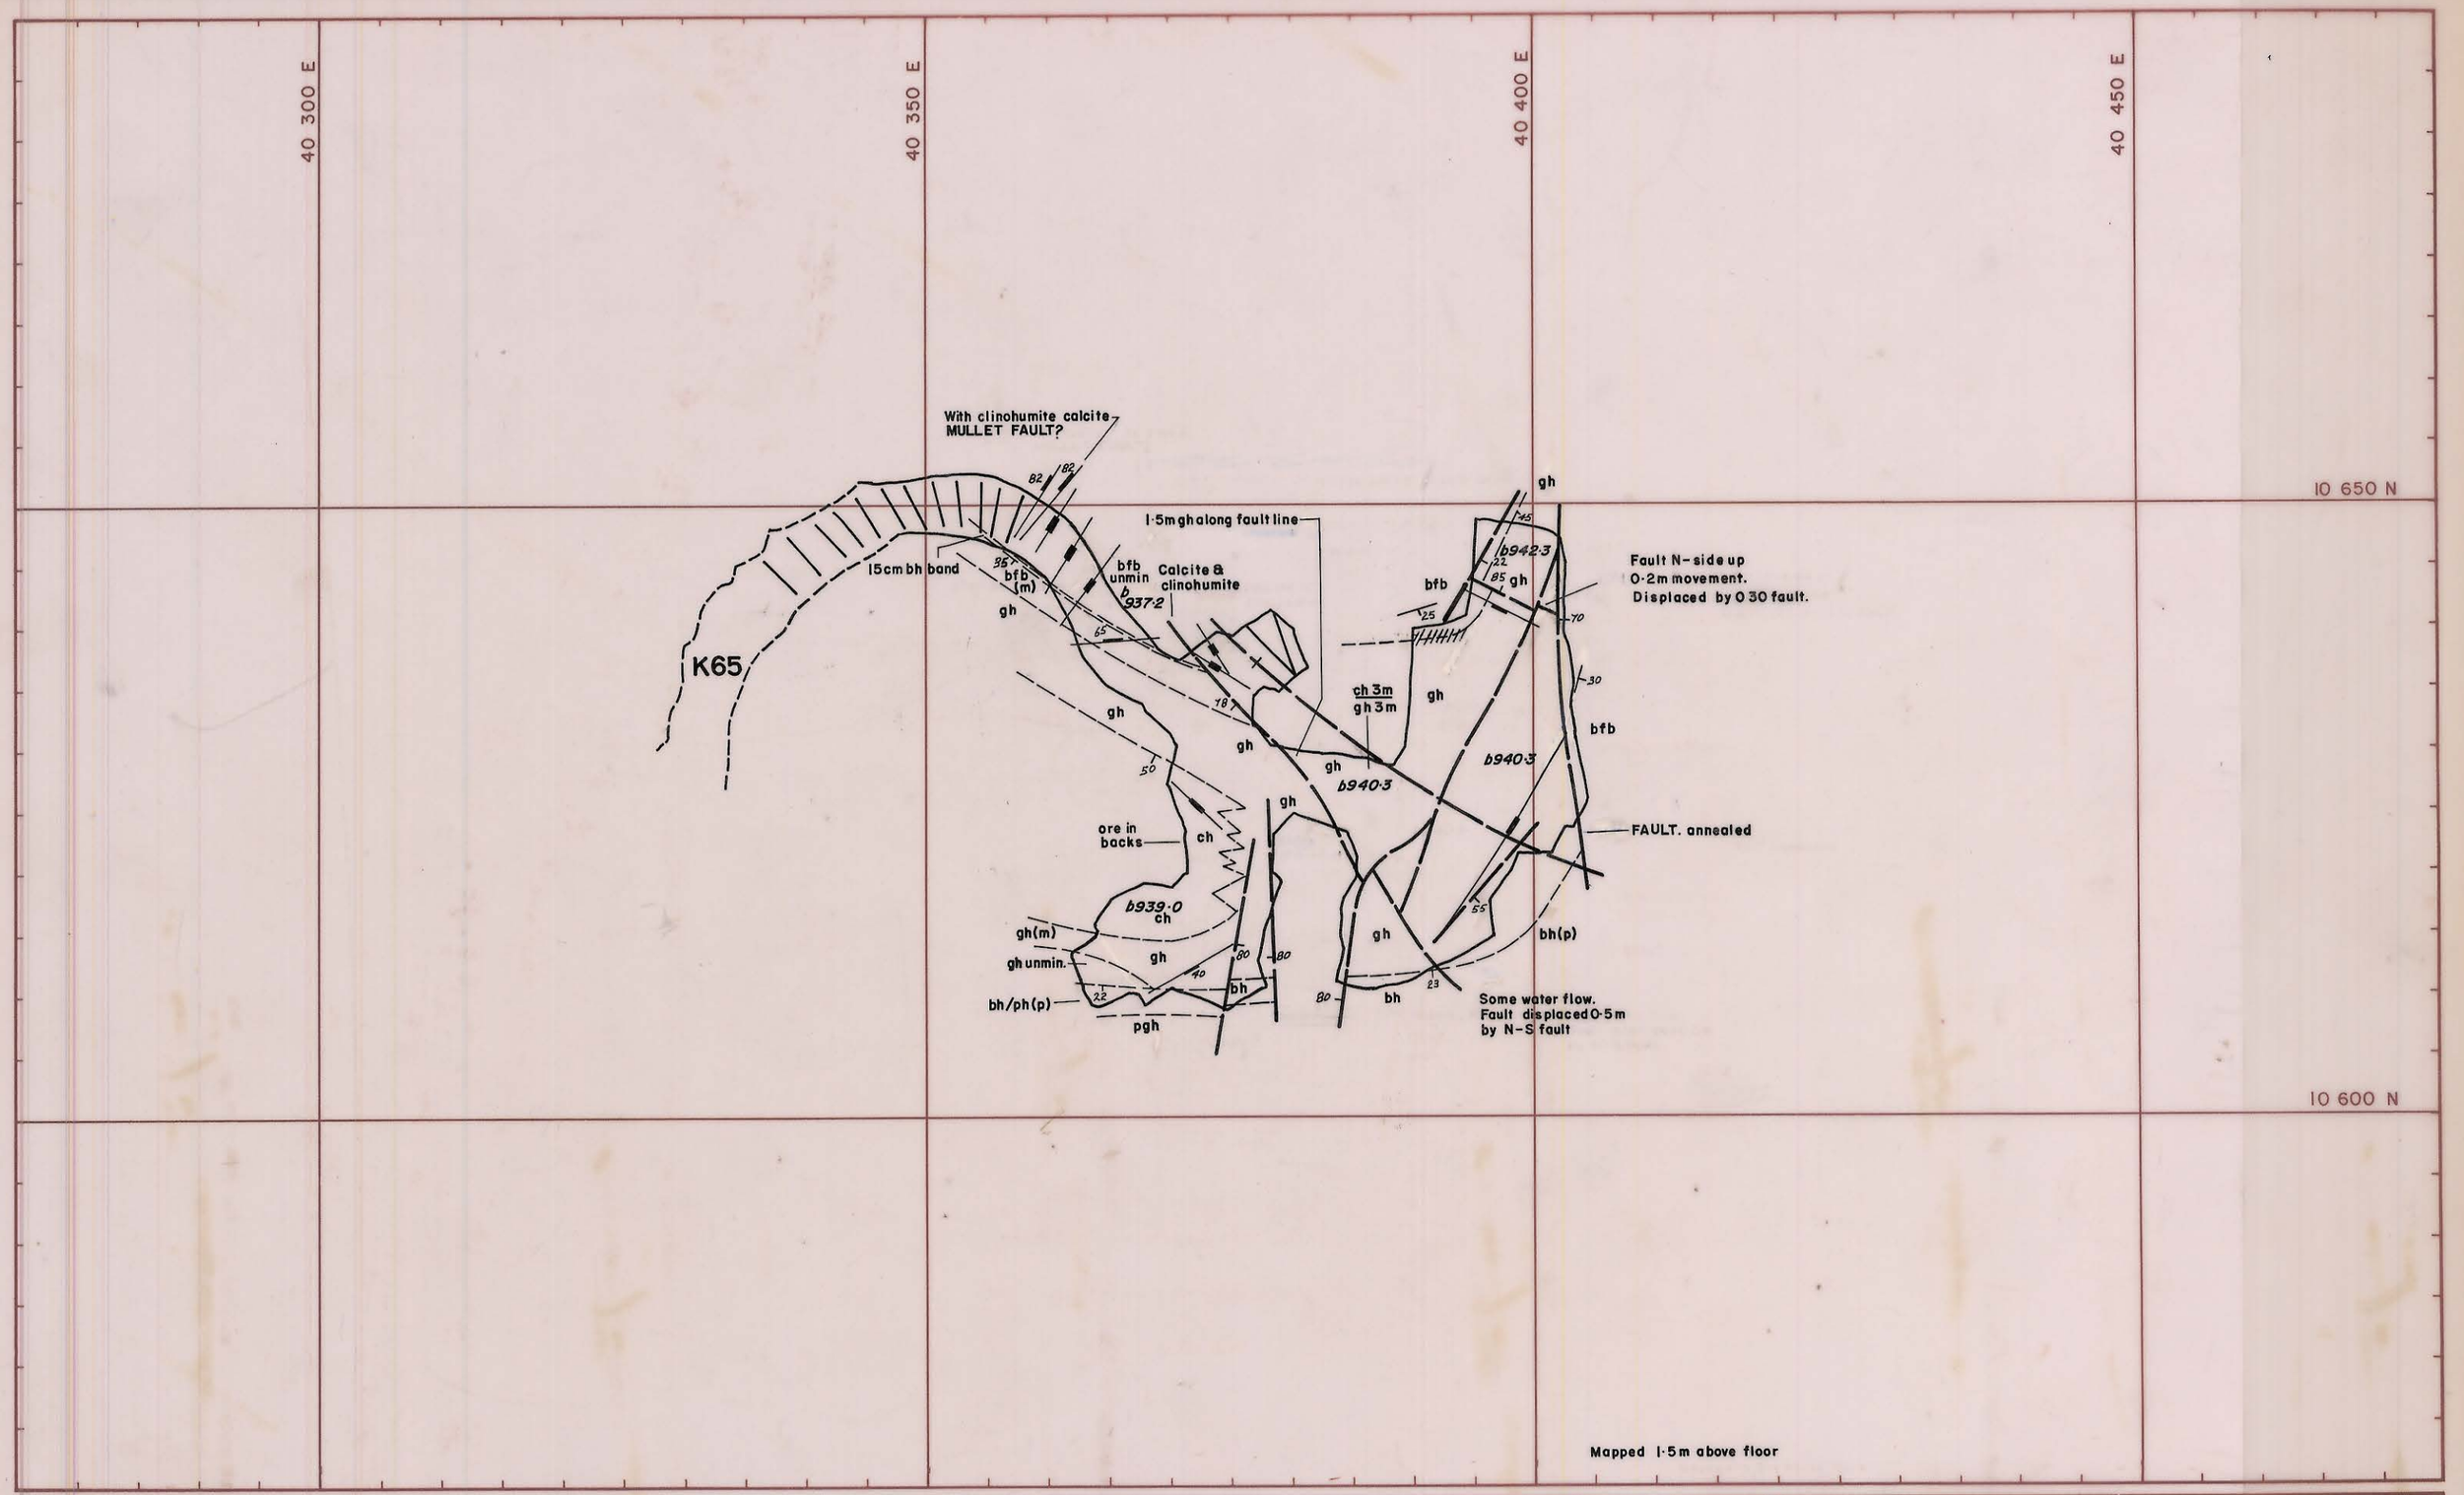

REF. PLAN	GEOLOGY	Terry Flotter MAY '80	SCALE 1:500
	SURVEY		KING ISLAND SCHEELITE GRASSY KING ISLAND
	PLANNING		BOLD HEAD MINE
	ROCK MEC.		C2 Orebody
	GRADE CON.		R60 4th Lift
	DRAFTING	M.vdS.	DRAWING NUMBER
	T.S.S.		