27 JUN 1981

C2 LENS ORE BODY
R60 STOPE 2nd LIFT

5 cm

0374_4801

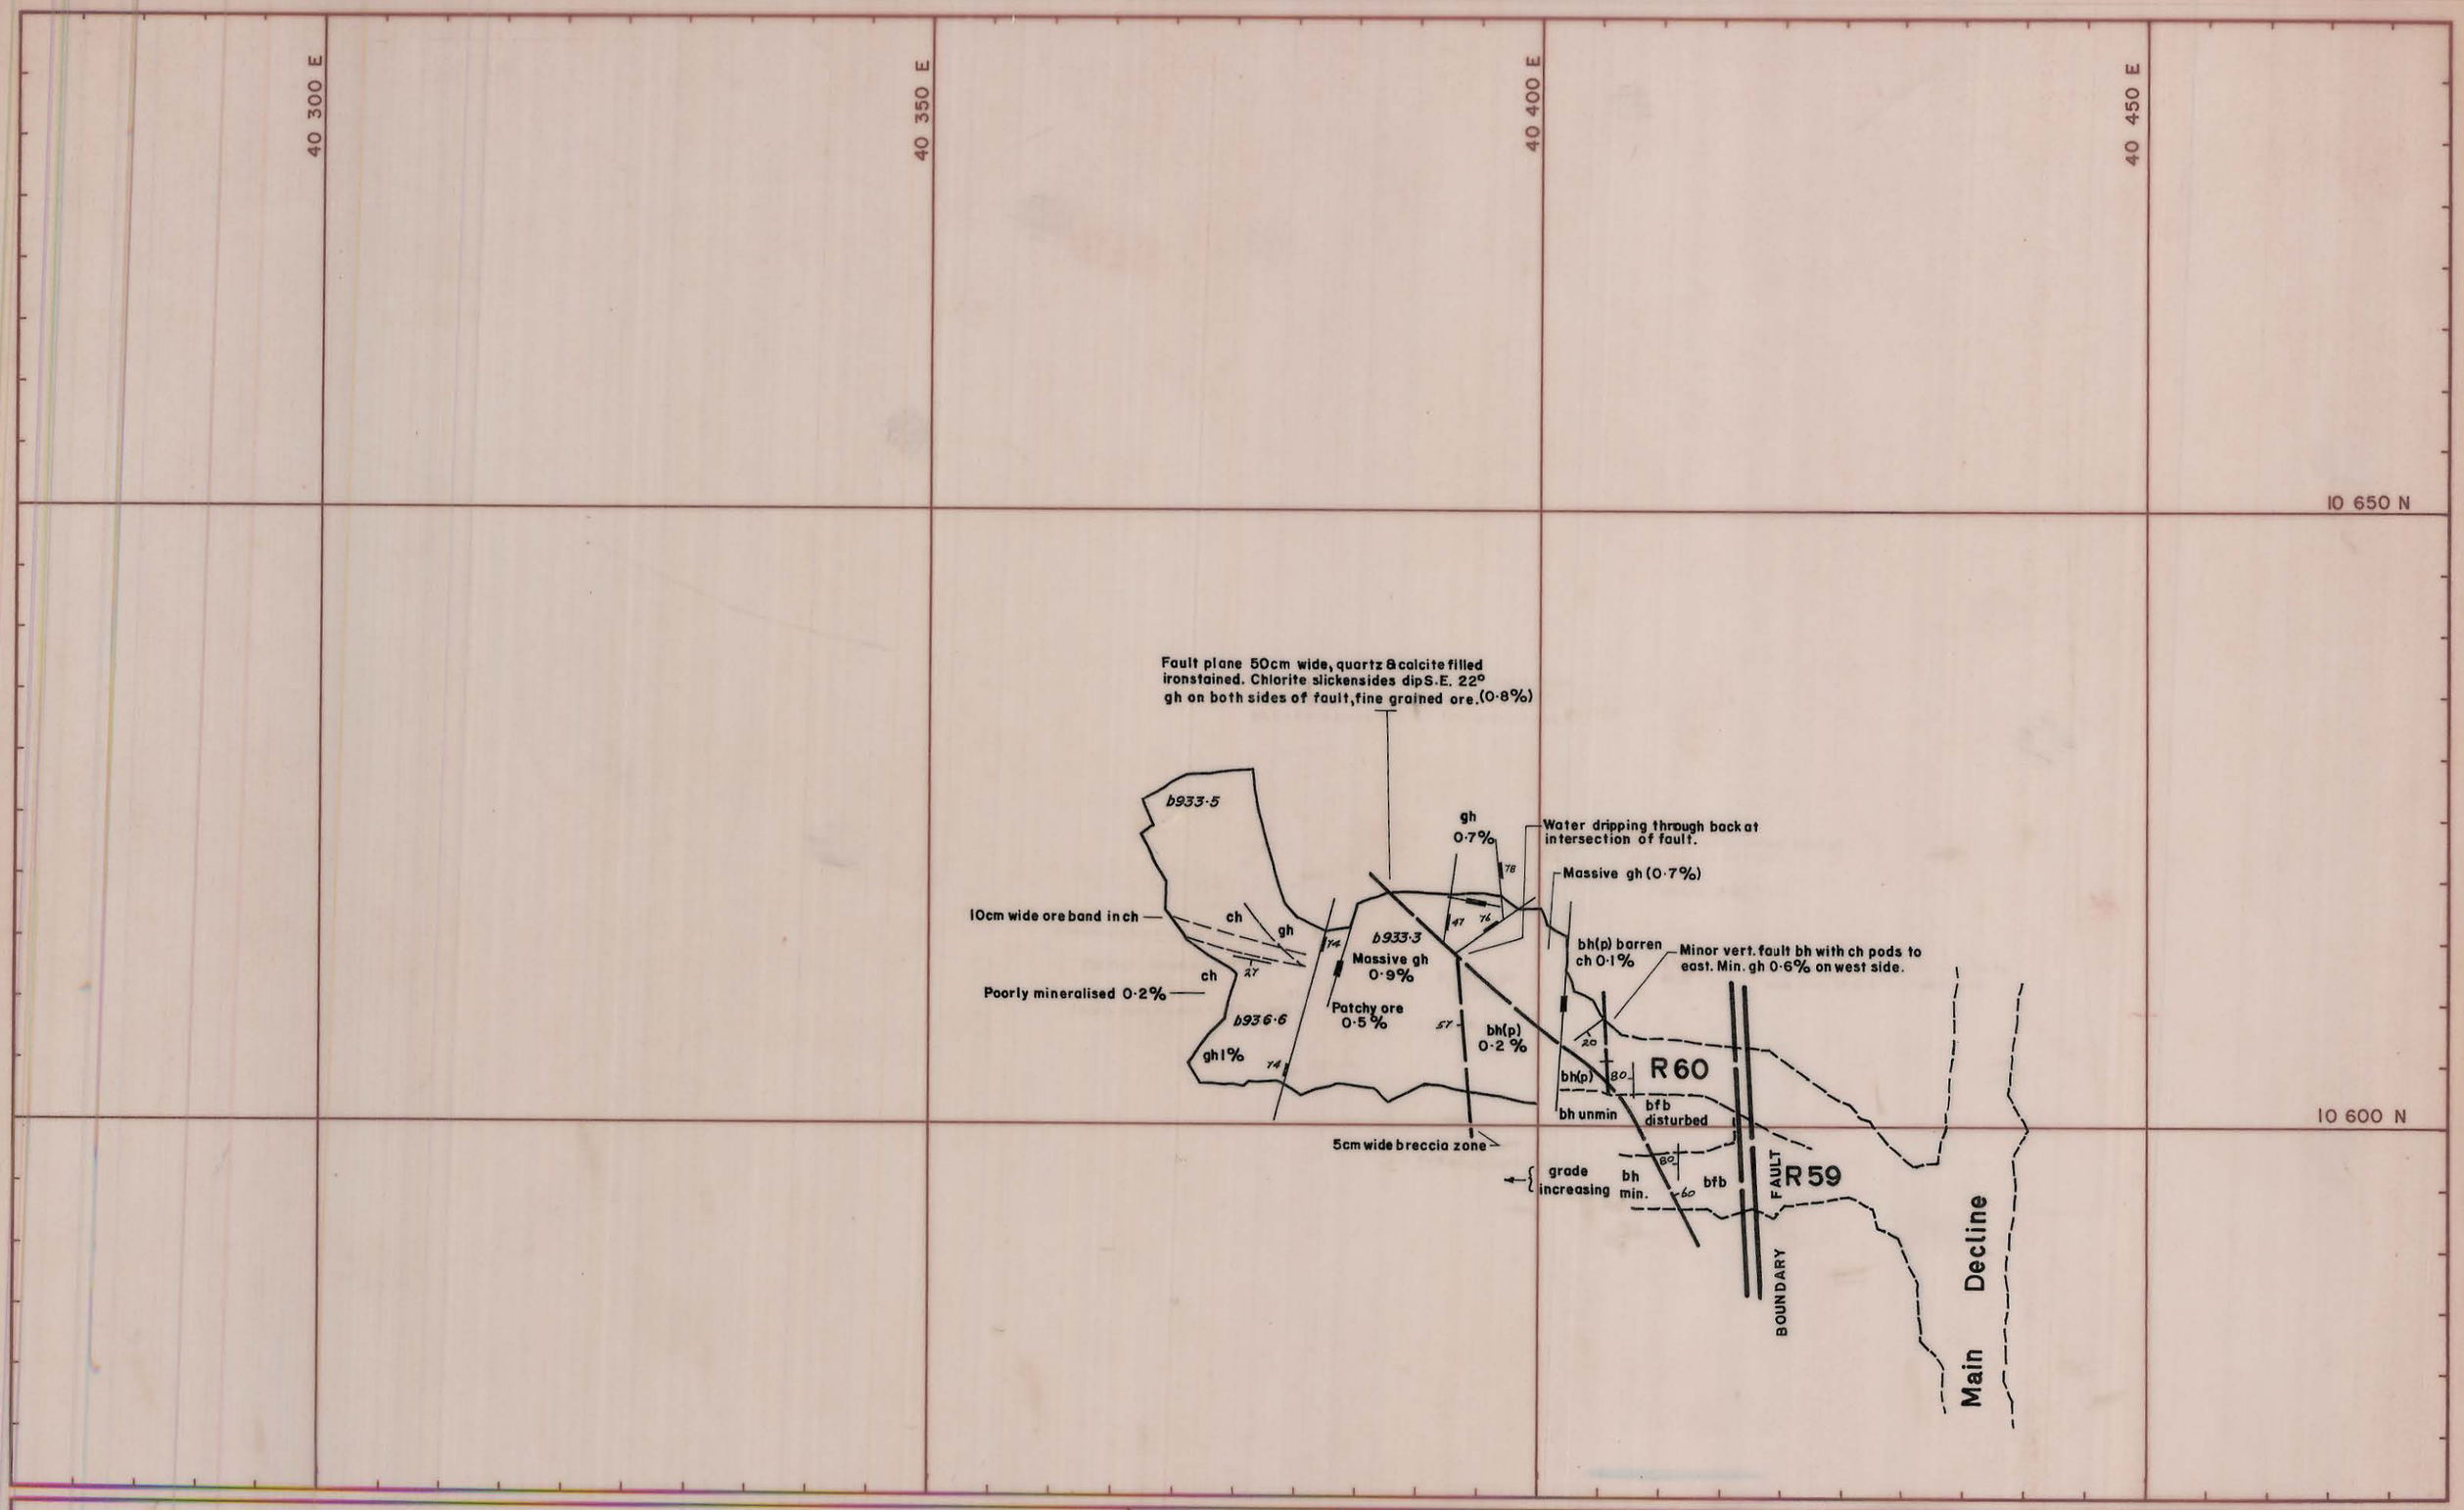

REF. PLAN	GEOLOGY	R.E.S-D	SCALE 1:500	KING ISLAND SCHEELITE GRASSY KING ISLAND
	SURVEY		BOLD HEAD MINE	
	PLANNING		C2 Orebody	
	ROCK MEC.		R60 2nd Lift	
	GRADE CON.			
	DRAFTING	M.vdS.	DRAWING NUMBER	
	T.S.S.			