27 JUN 1981

H50 STOPE
7th LIFT

5 cm

0374_4837

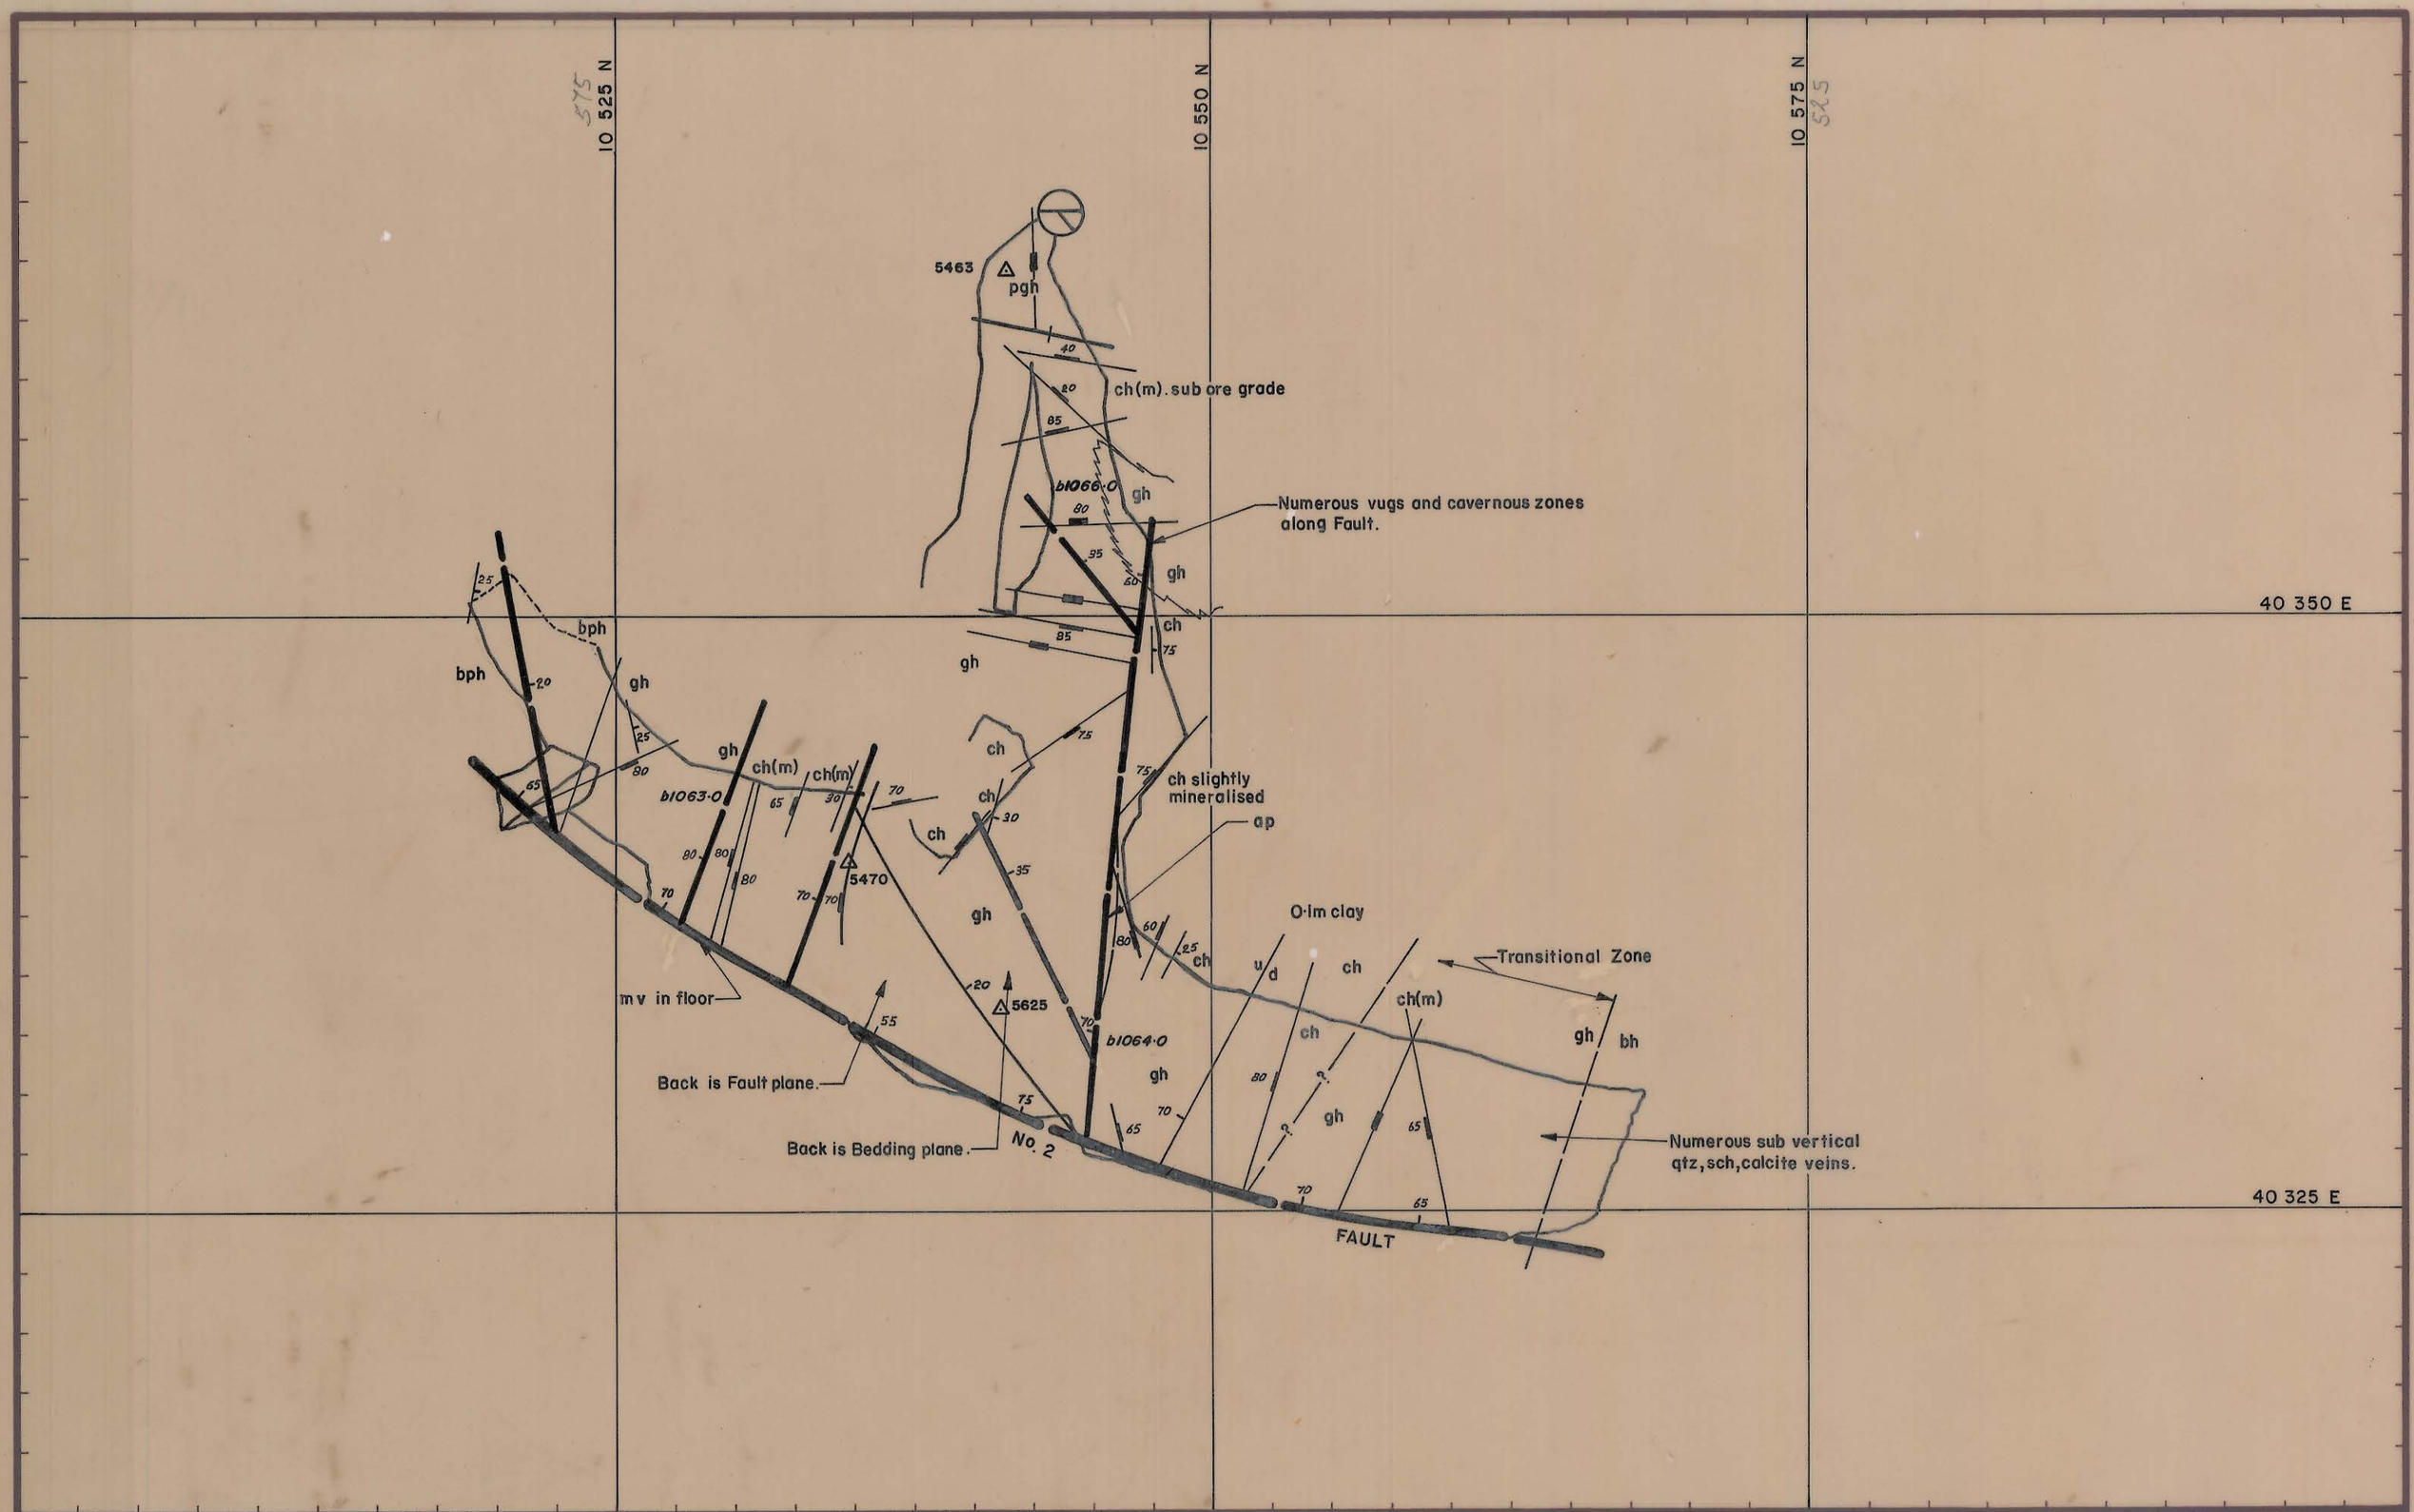

LEGEND:

GEOPEKO LIMITED
KING ISLAND

Scale: 1:250

Nº K

DATE: Dec.78
GEOL: A.Y.
DWN: M.V.
CHKD:

BOLD HEAD OREBODY
H-50 STOPE
7th Lift.