


0374_517

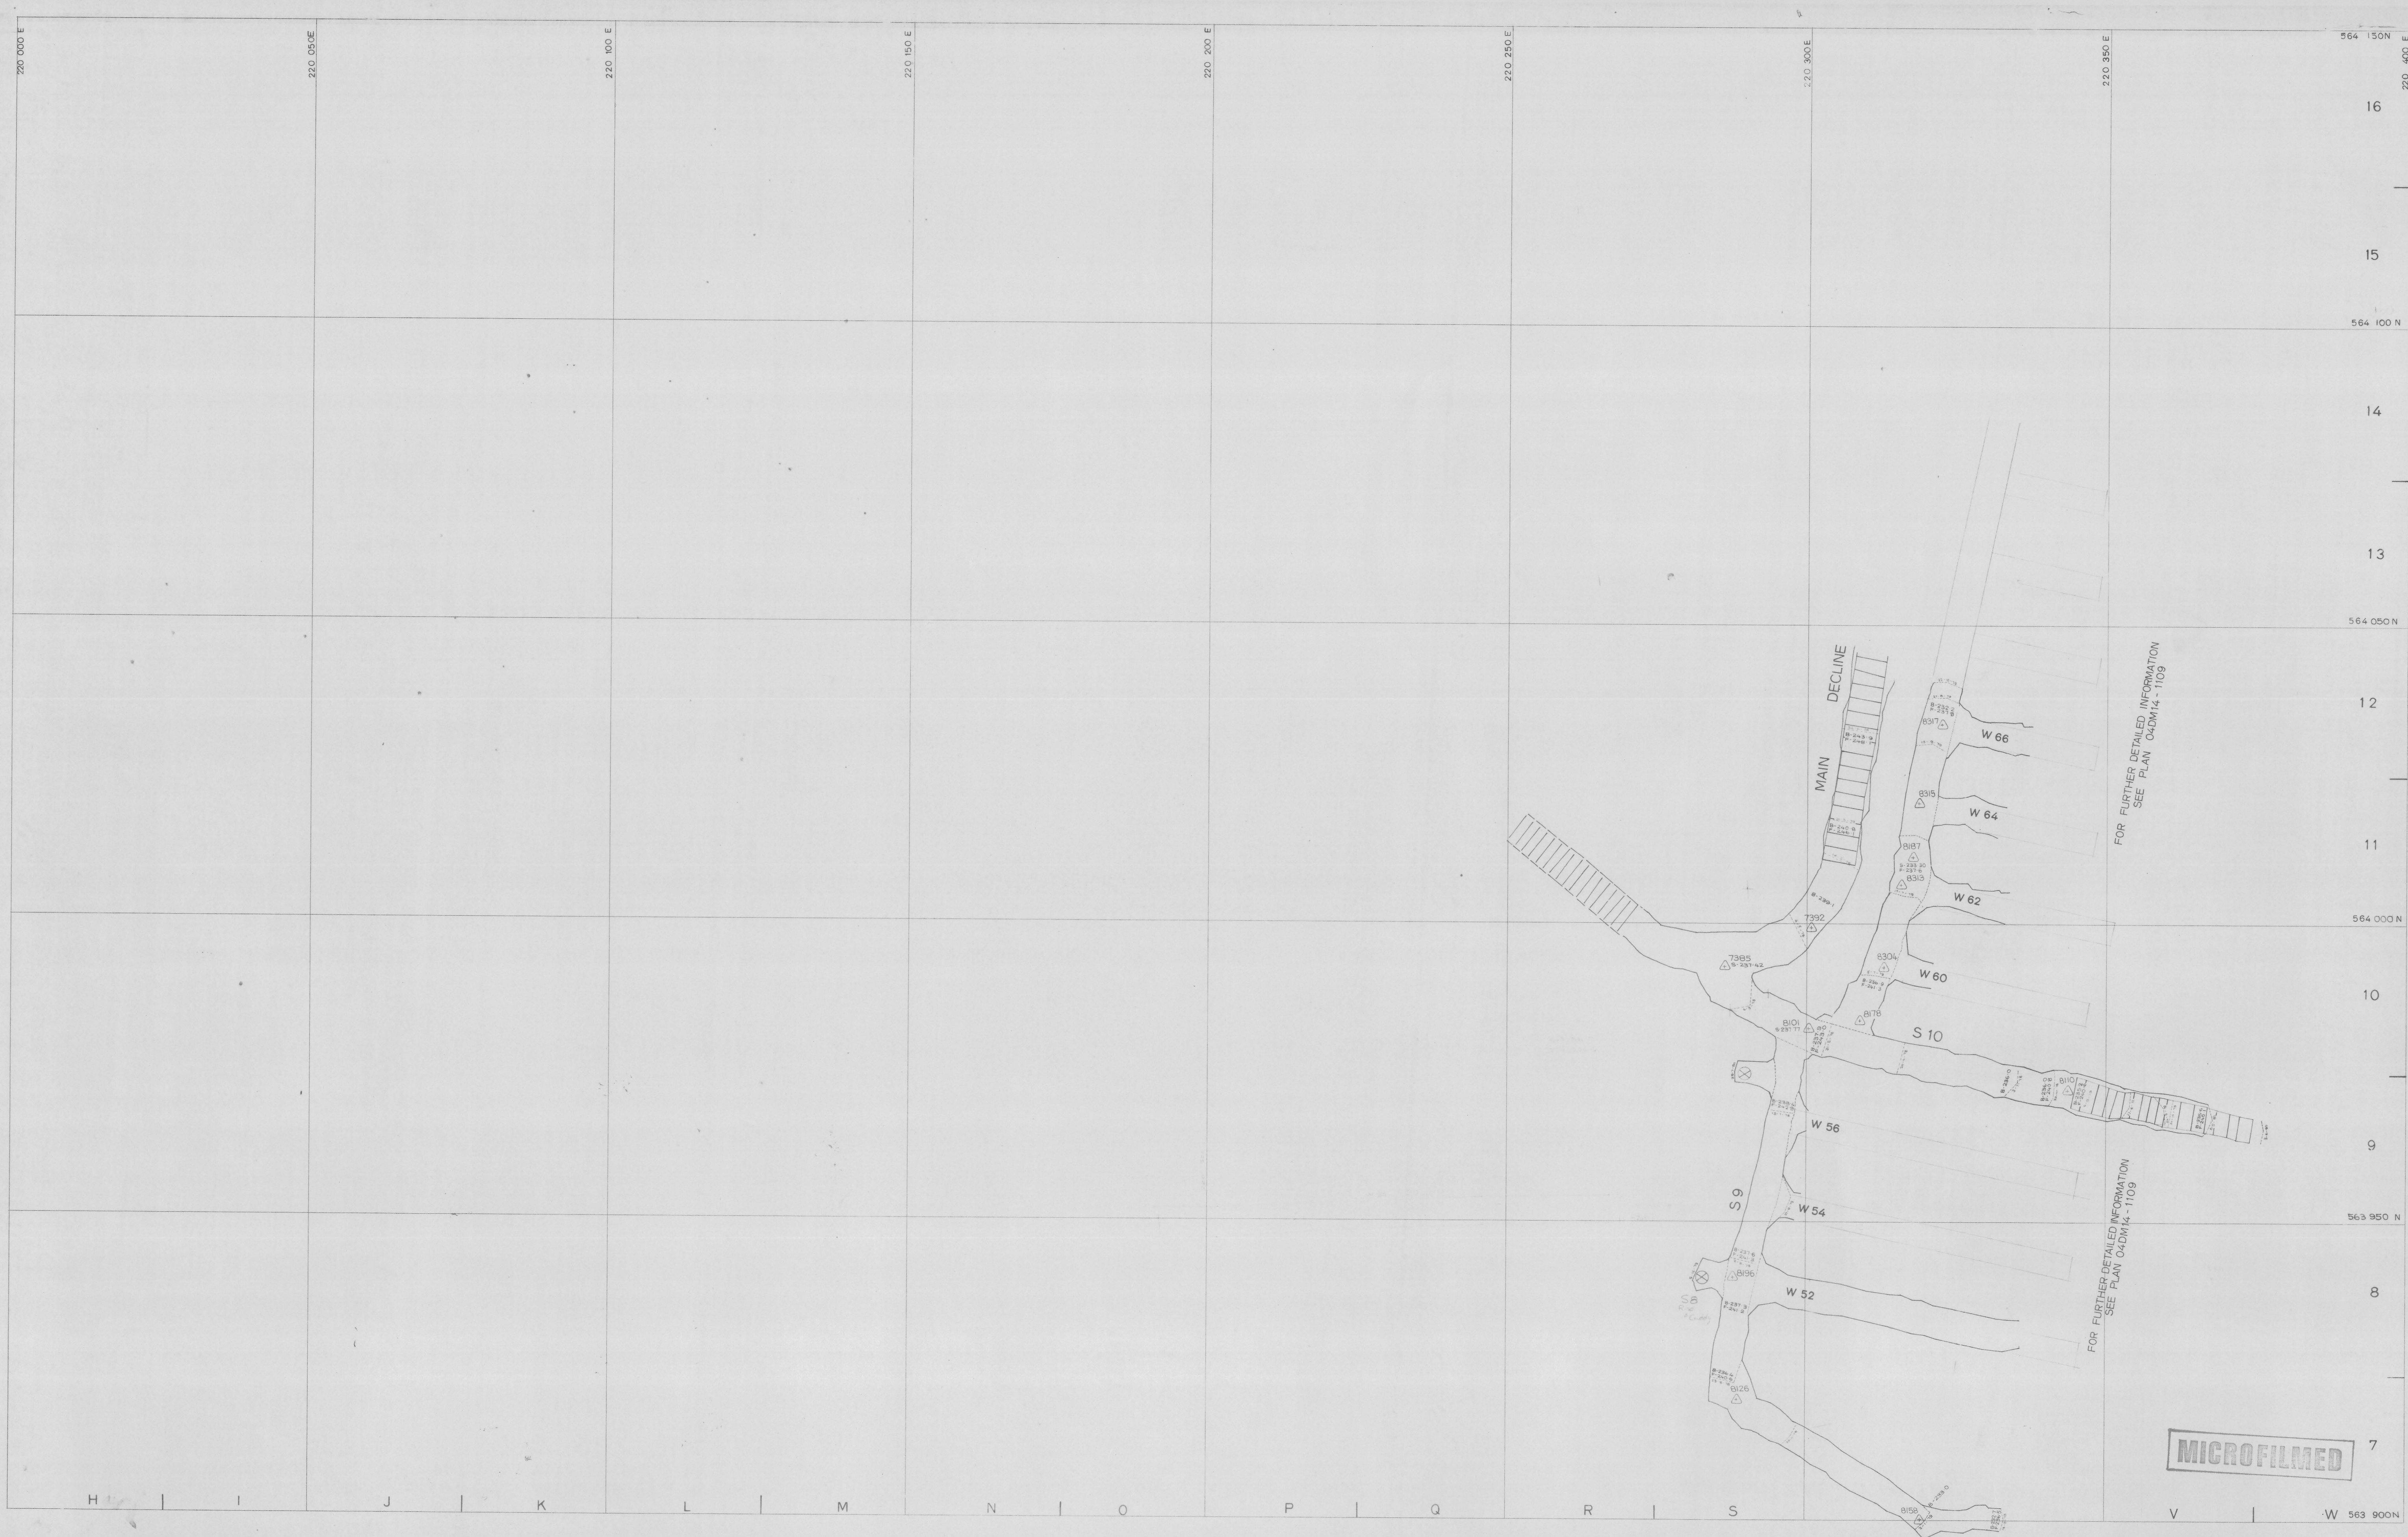

	SCALE 1: 500 5 cm	north	LOCATION DOLPHIN MINE	
	SUBJECT - 240m ZONE		PLAN NUMBER O4DM14 - 1009	
			8111	