


0374_550

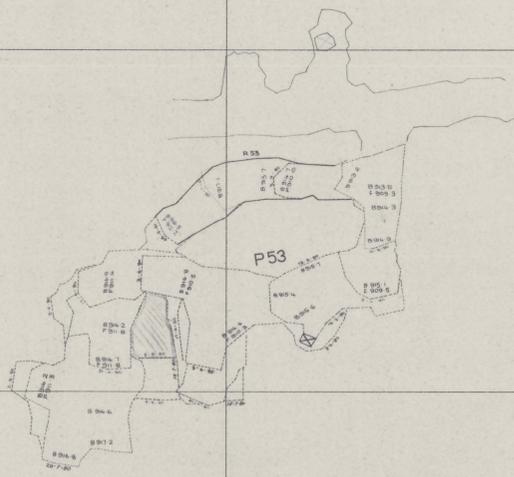

MICROFILMED

SCALE 1:	LOCATION	
	SUBJECT	
north	P 53 2nd LIFT.	GRASSY KING ISLAND
		PLAN NUMBER 04/24/15 - 10/24/15 (P) 8/100