

0374_558

10 650 N

10 600 N

10 550 N

10 500 N

10 450 N



10 400 N

40 450 E

40 400 E

40 350 E

40 300 E

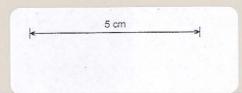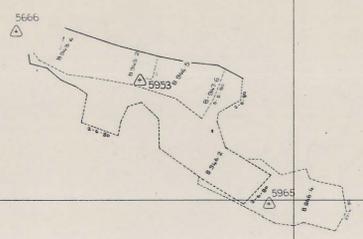

MICROFILMED

SCALE 1: 500

LOCATION BOLD HEAD MINE

SUBJECT

H 59 - 2nd lift

north



PLAN NUMBER 04BH15 - 1069 81097