


0374_569

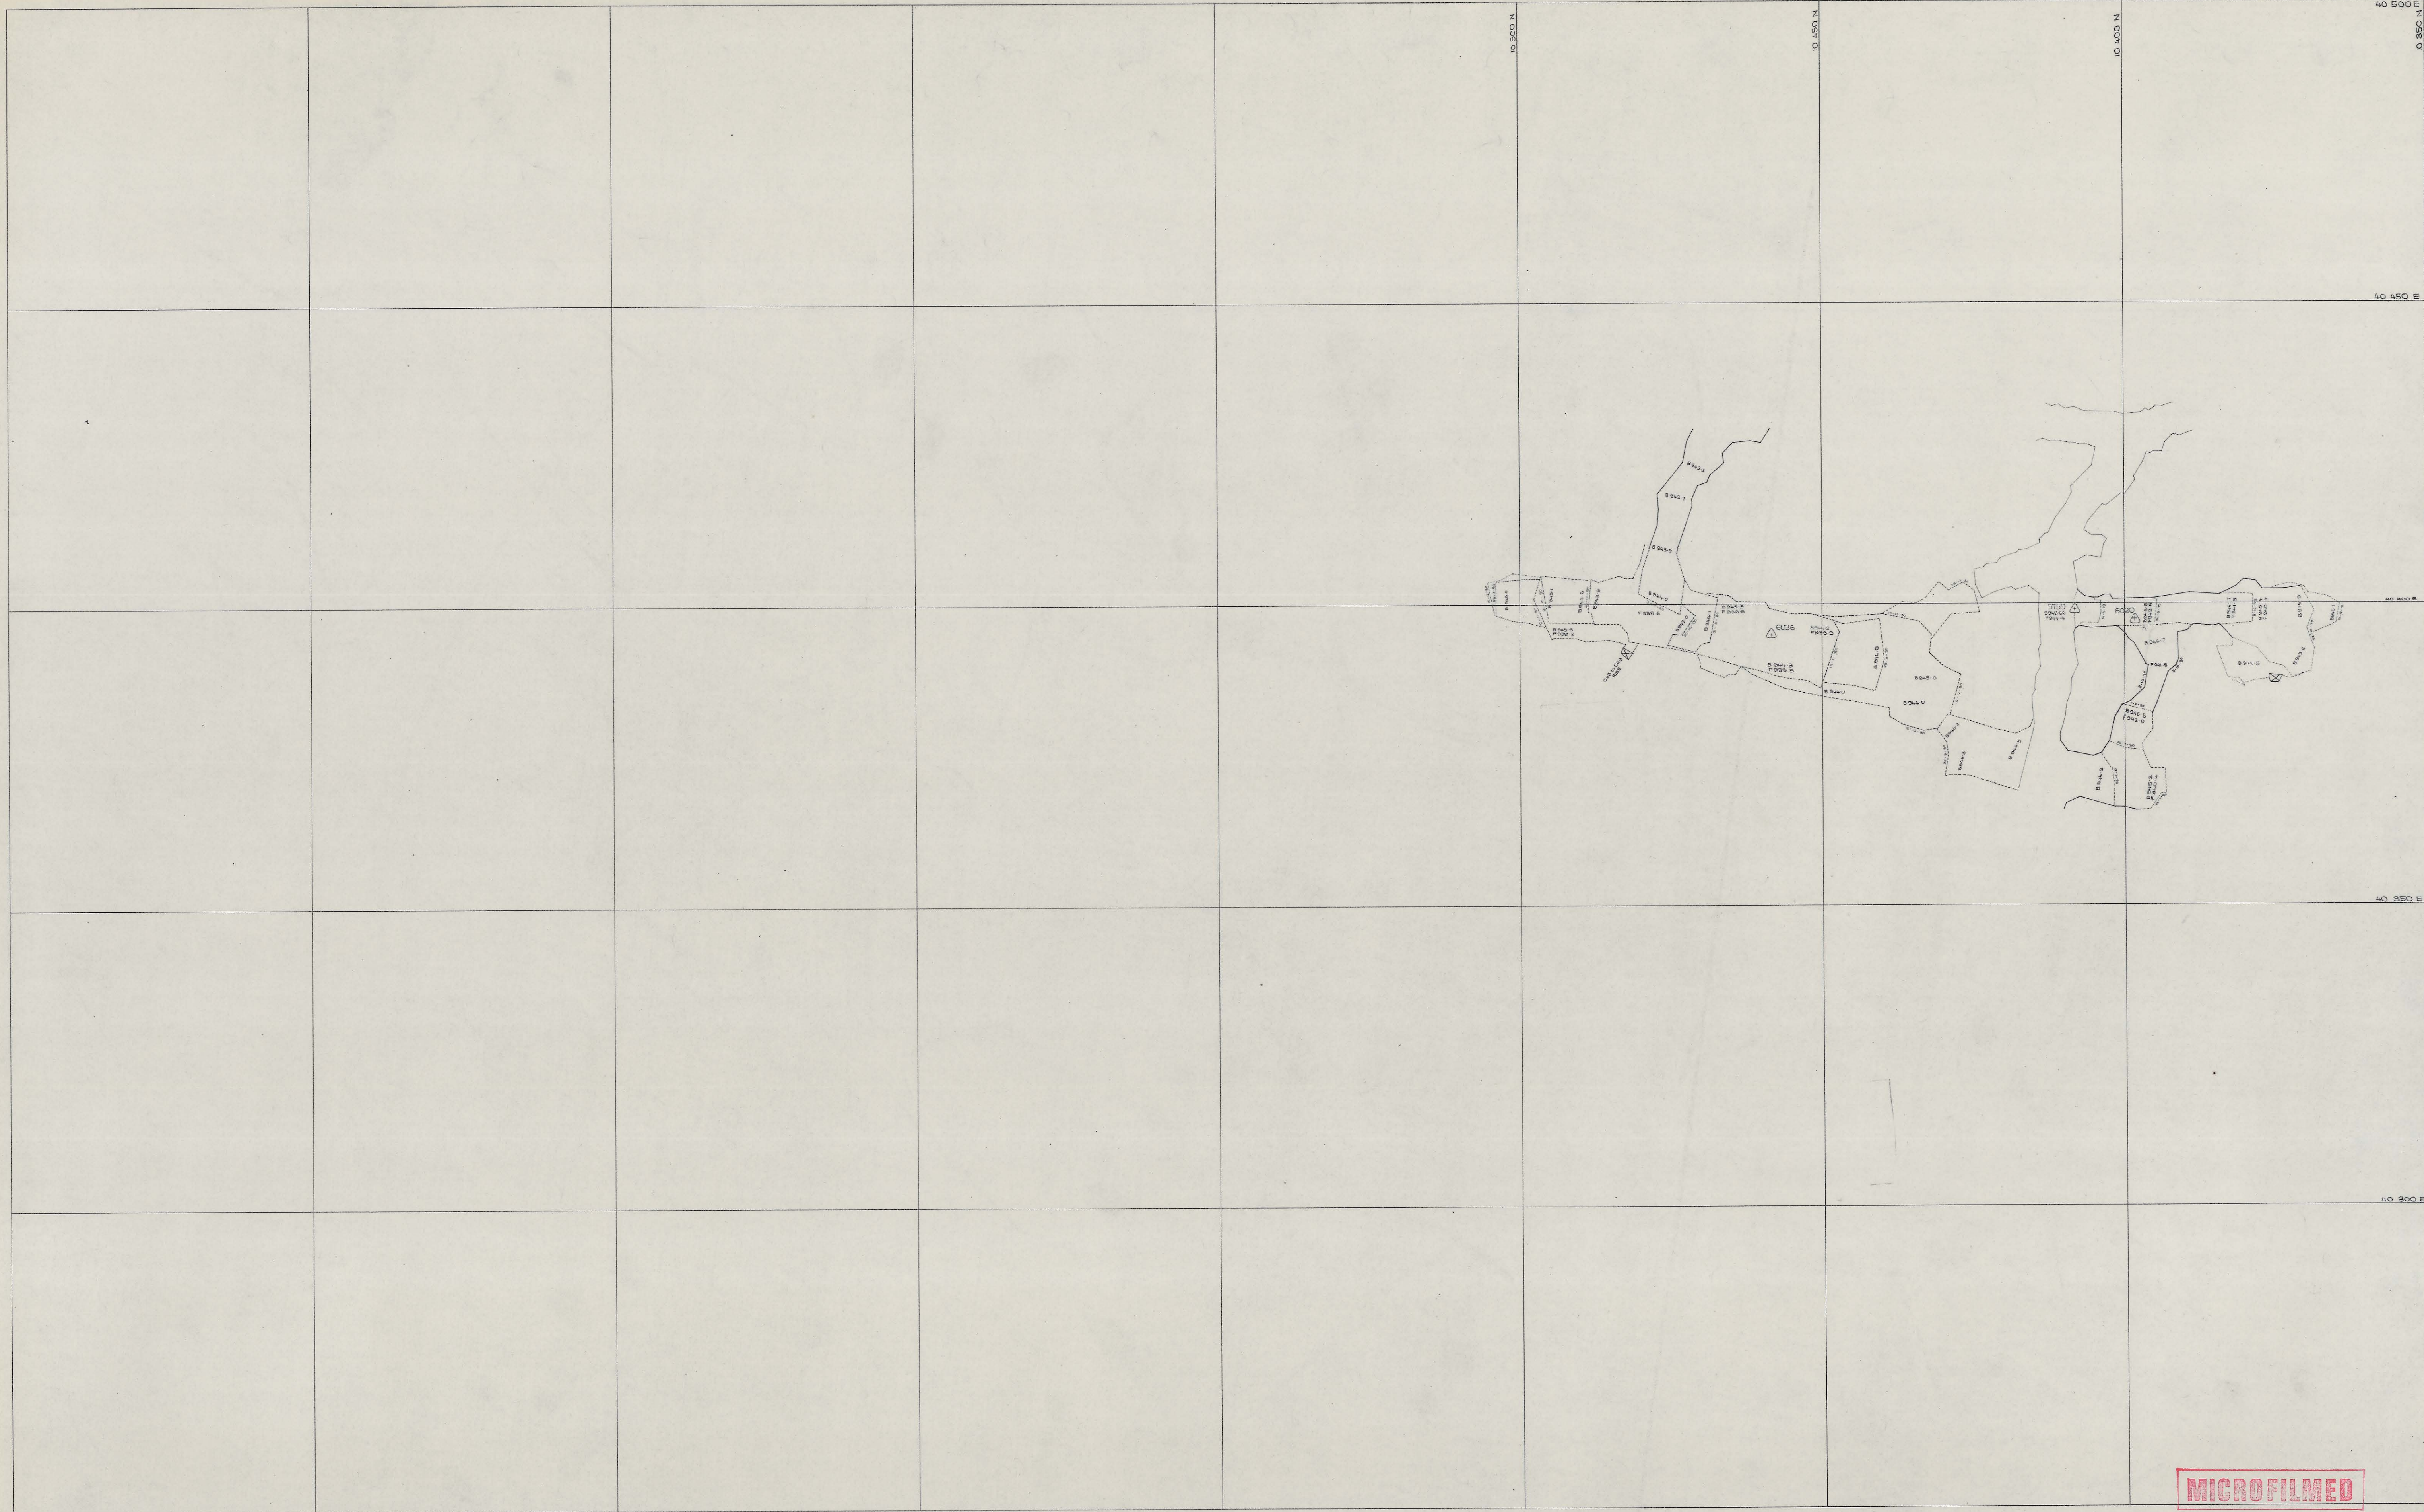

MICROFILMED

SCALE 1:500 5 cm	north	LOCATION BOLD HEAD MINE	KIS KING ISLAND SCHEELITE A DIVISION OF HARMAN INTERNATIONAL GRASSY KING ISLAND PLAN NUMBER 04BH15 - 1053 81085
		SUBJECT 037 & 043 STOPES 6th lift	