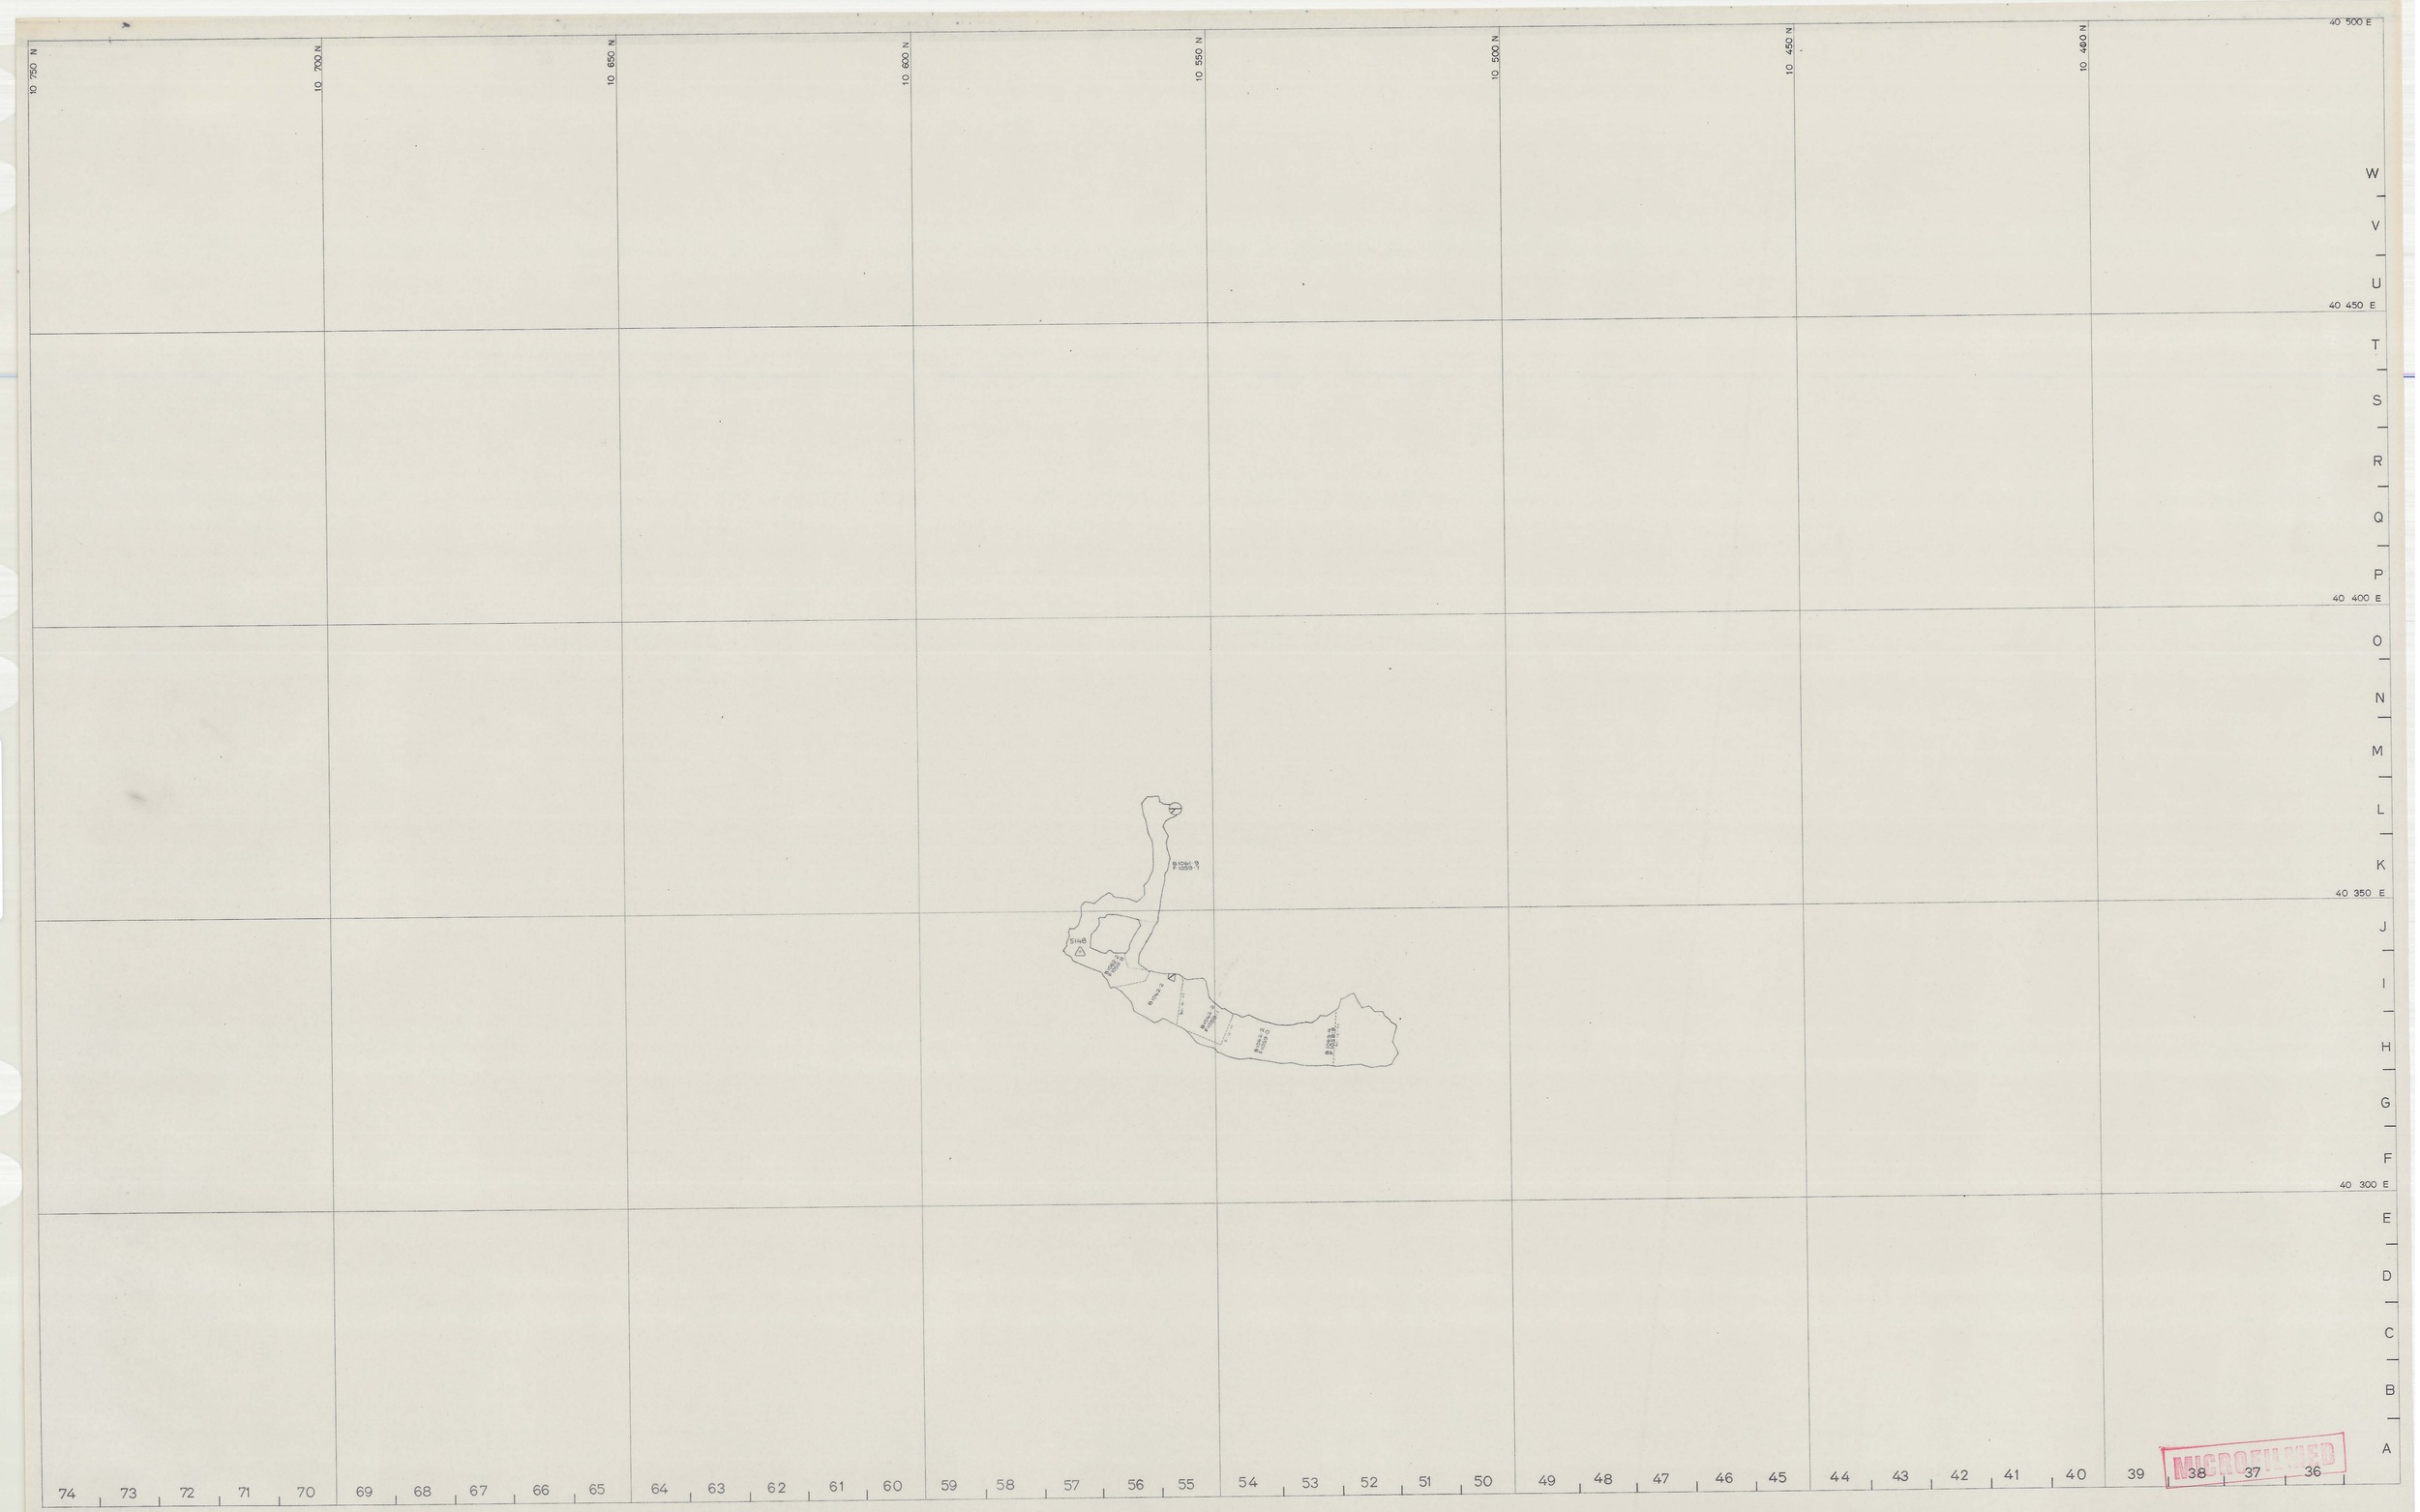

SCALE 1 500

5 cm

north

LOCATION
BOLD HEAD MINE

SUBJECT
H 50
A LENS CAVO STOPE
[6th Lift]

KING ISLAND SCHEELITE
A DIVISION OF WARMAN INTERNATIONAL
GRASSY KING ISLAND

PLAN NUMBER
04BH15-1025

81070

0374_579