
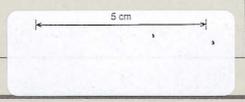


0374\_601

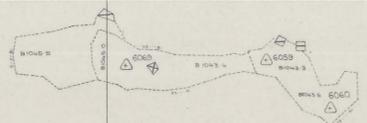

MICROFILMED

	SCALE 1:	north	LOCATION SUBJECT P 57 LIFT 6	 GRASSY KING ISLAND PLAN NUMBER 81077
--	----------	-------	---------------------------------------	---