


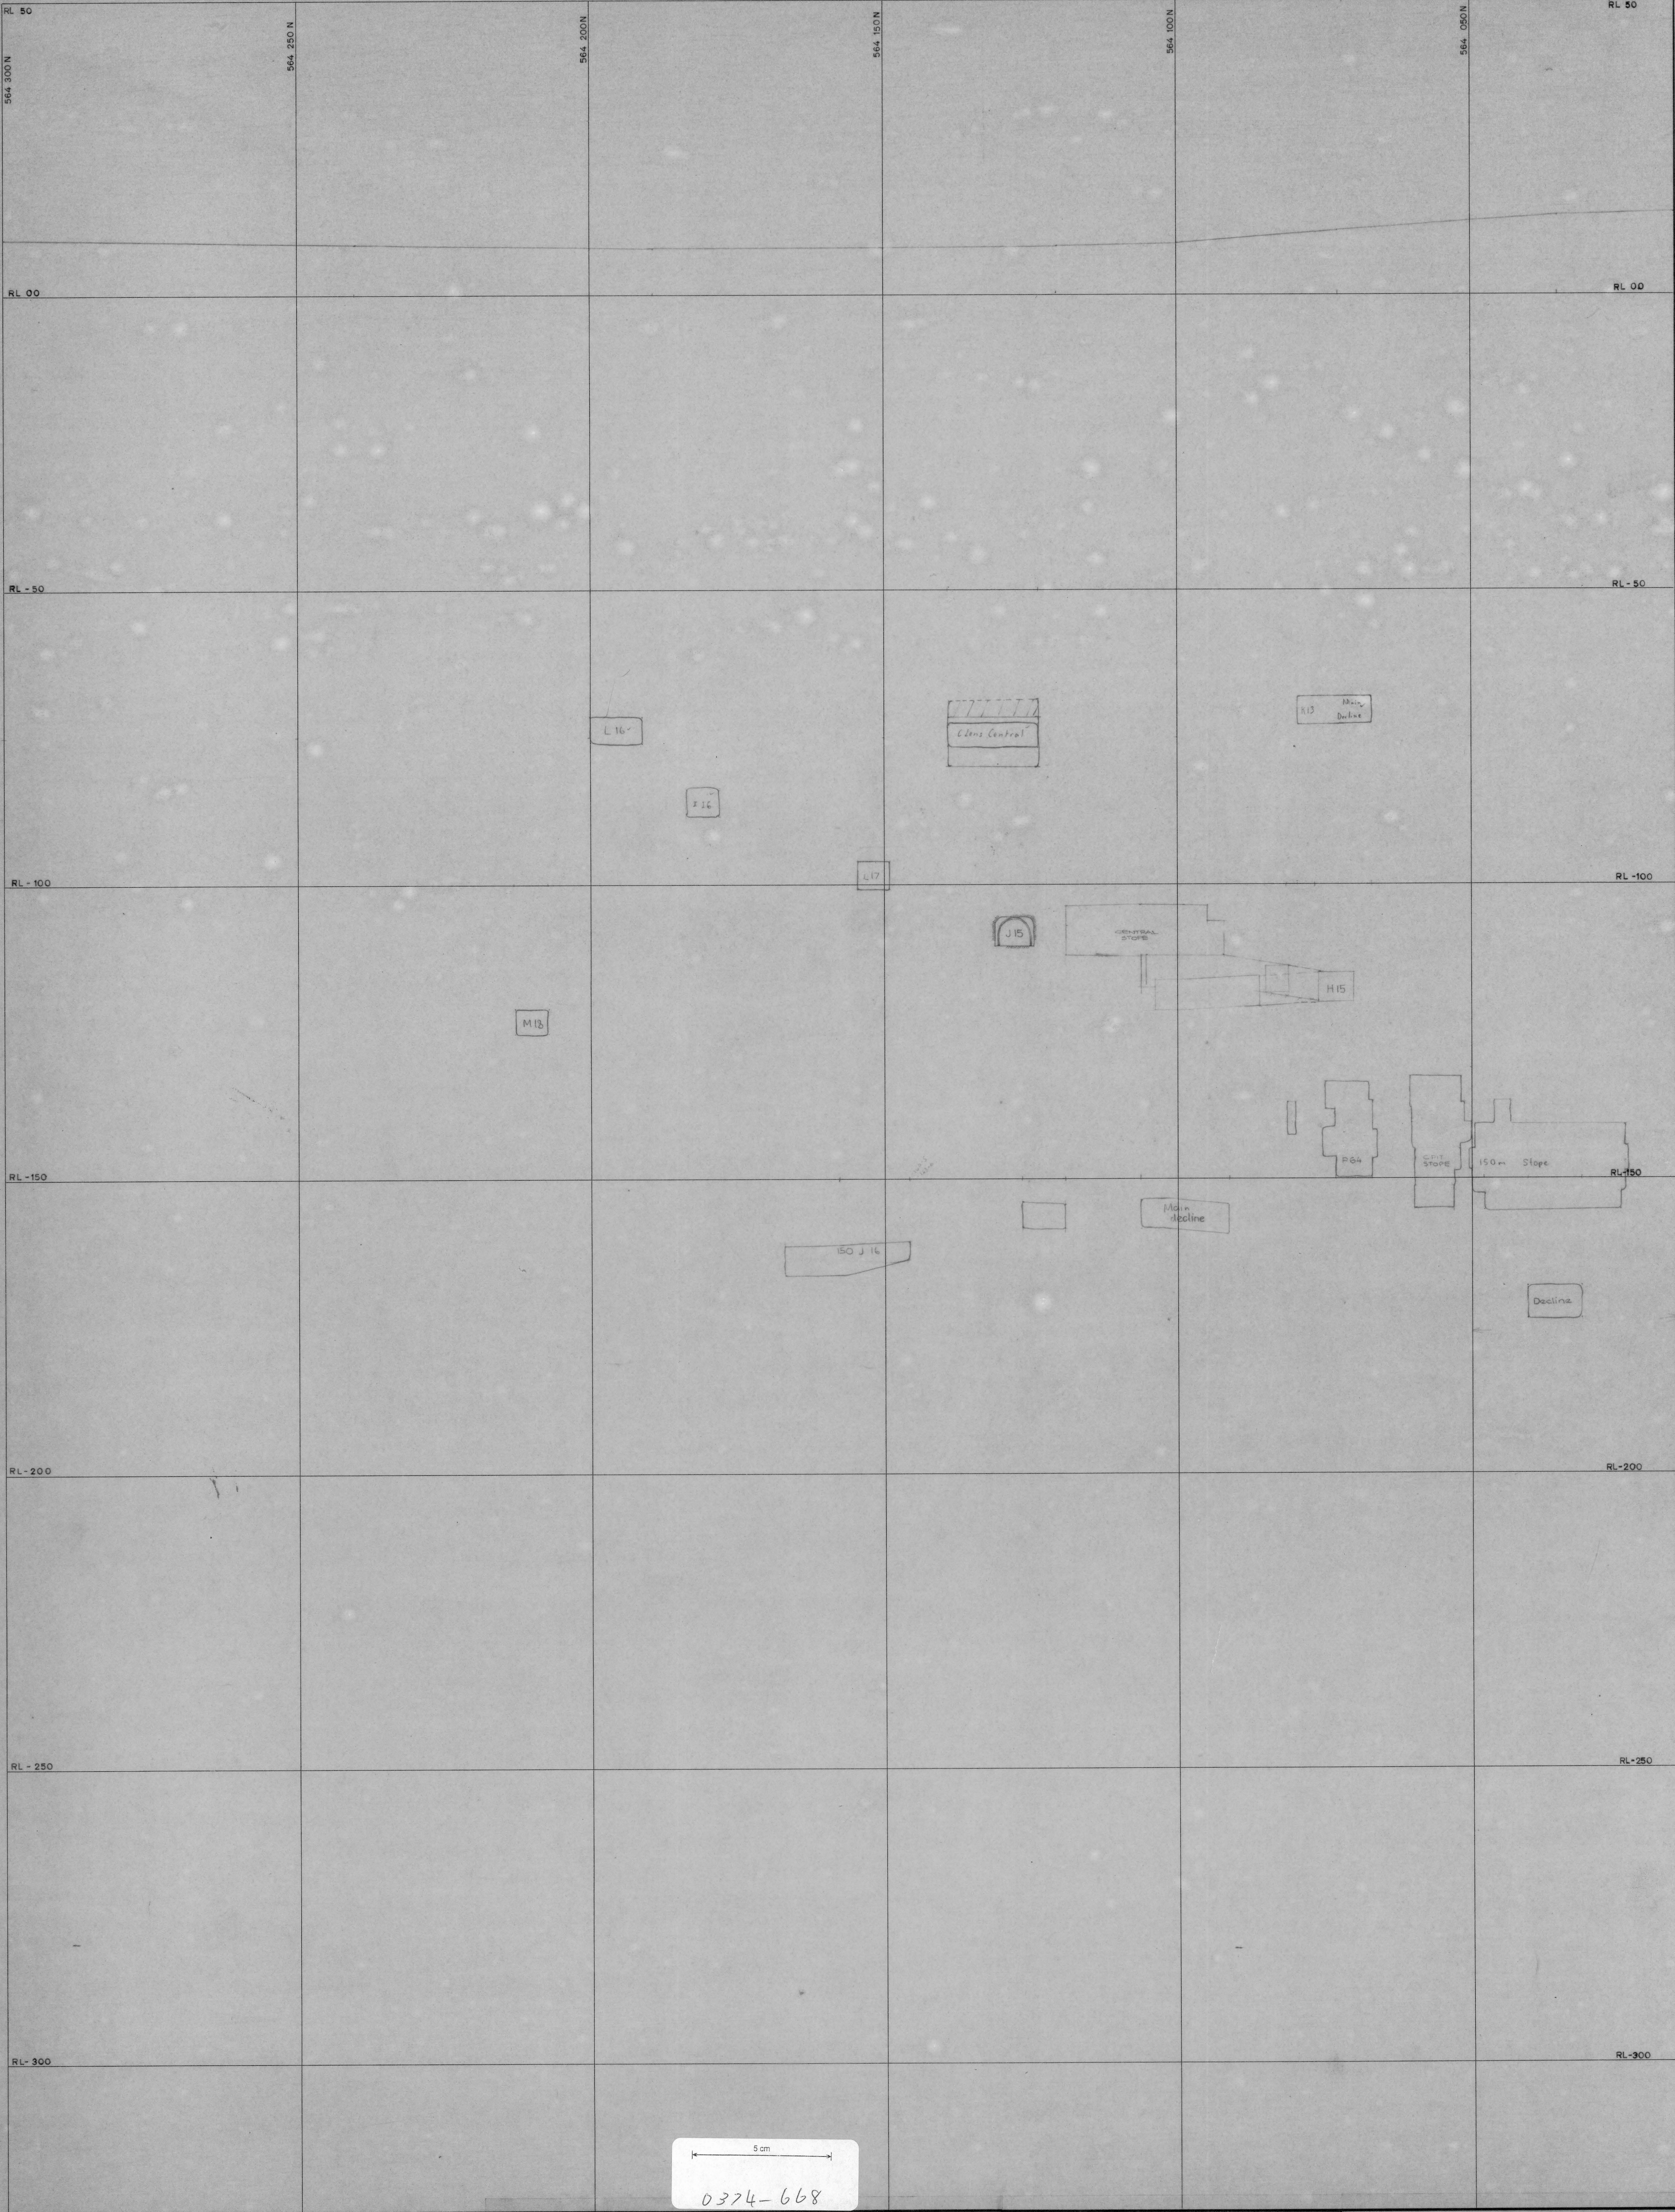

SCALE 1:500	LOCATION DOLPHIN MINE	KIS KING ISLAND SCHEELITE A DIVISION OF WARMAN INTERNATIONAL
	SUBJECT CROSSECTION 220 080 E	

82428

looking east

MA-23-1-77
4/1/82