


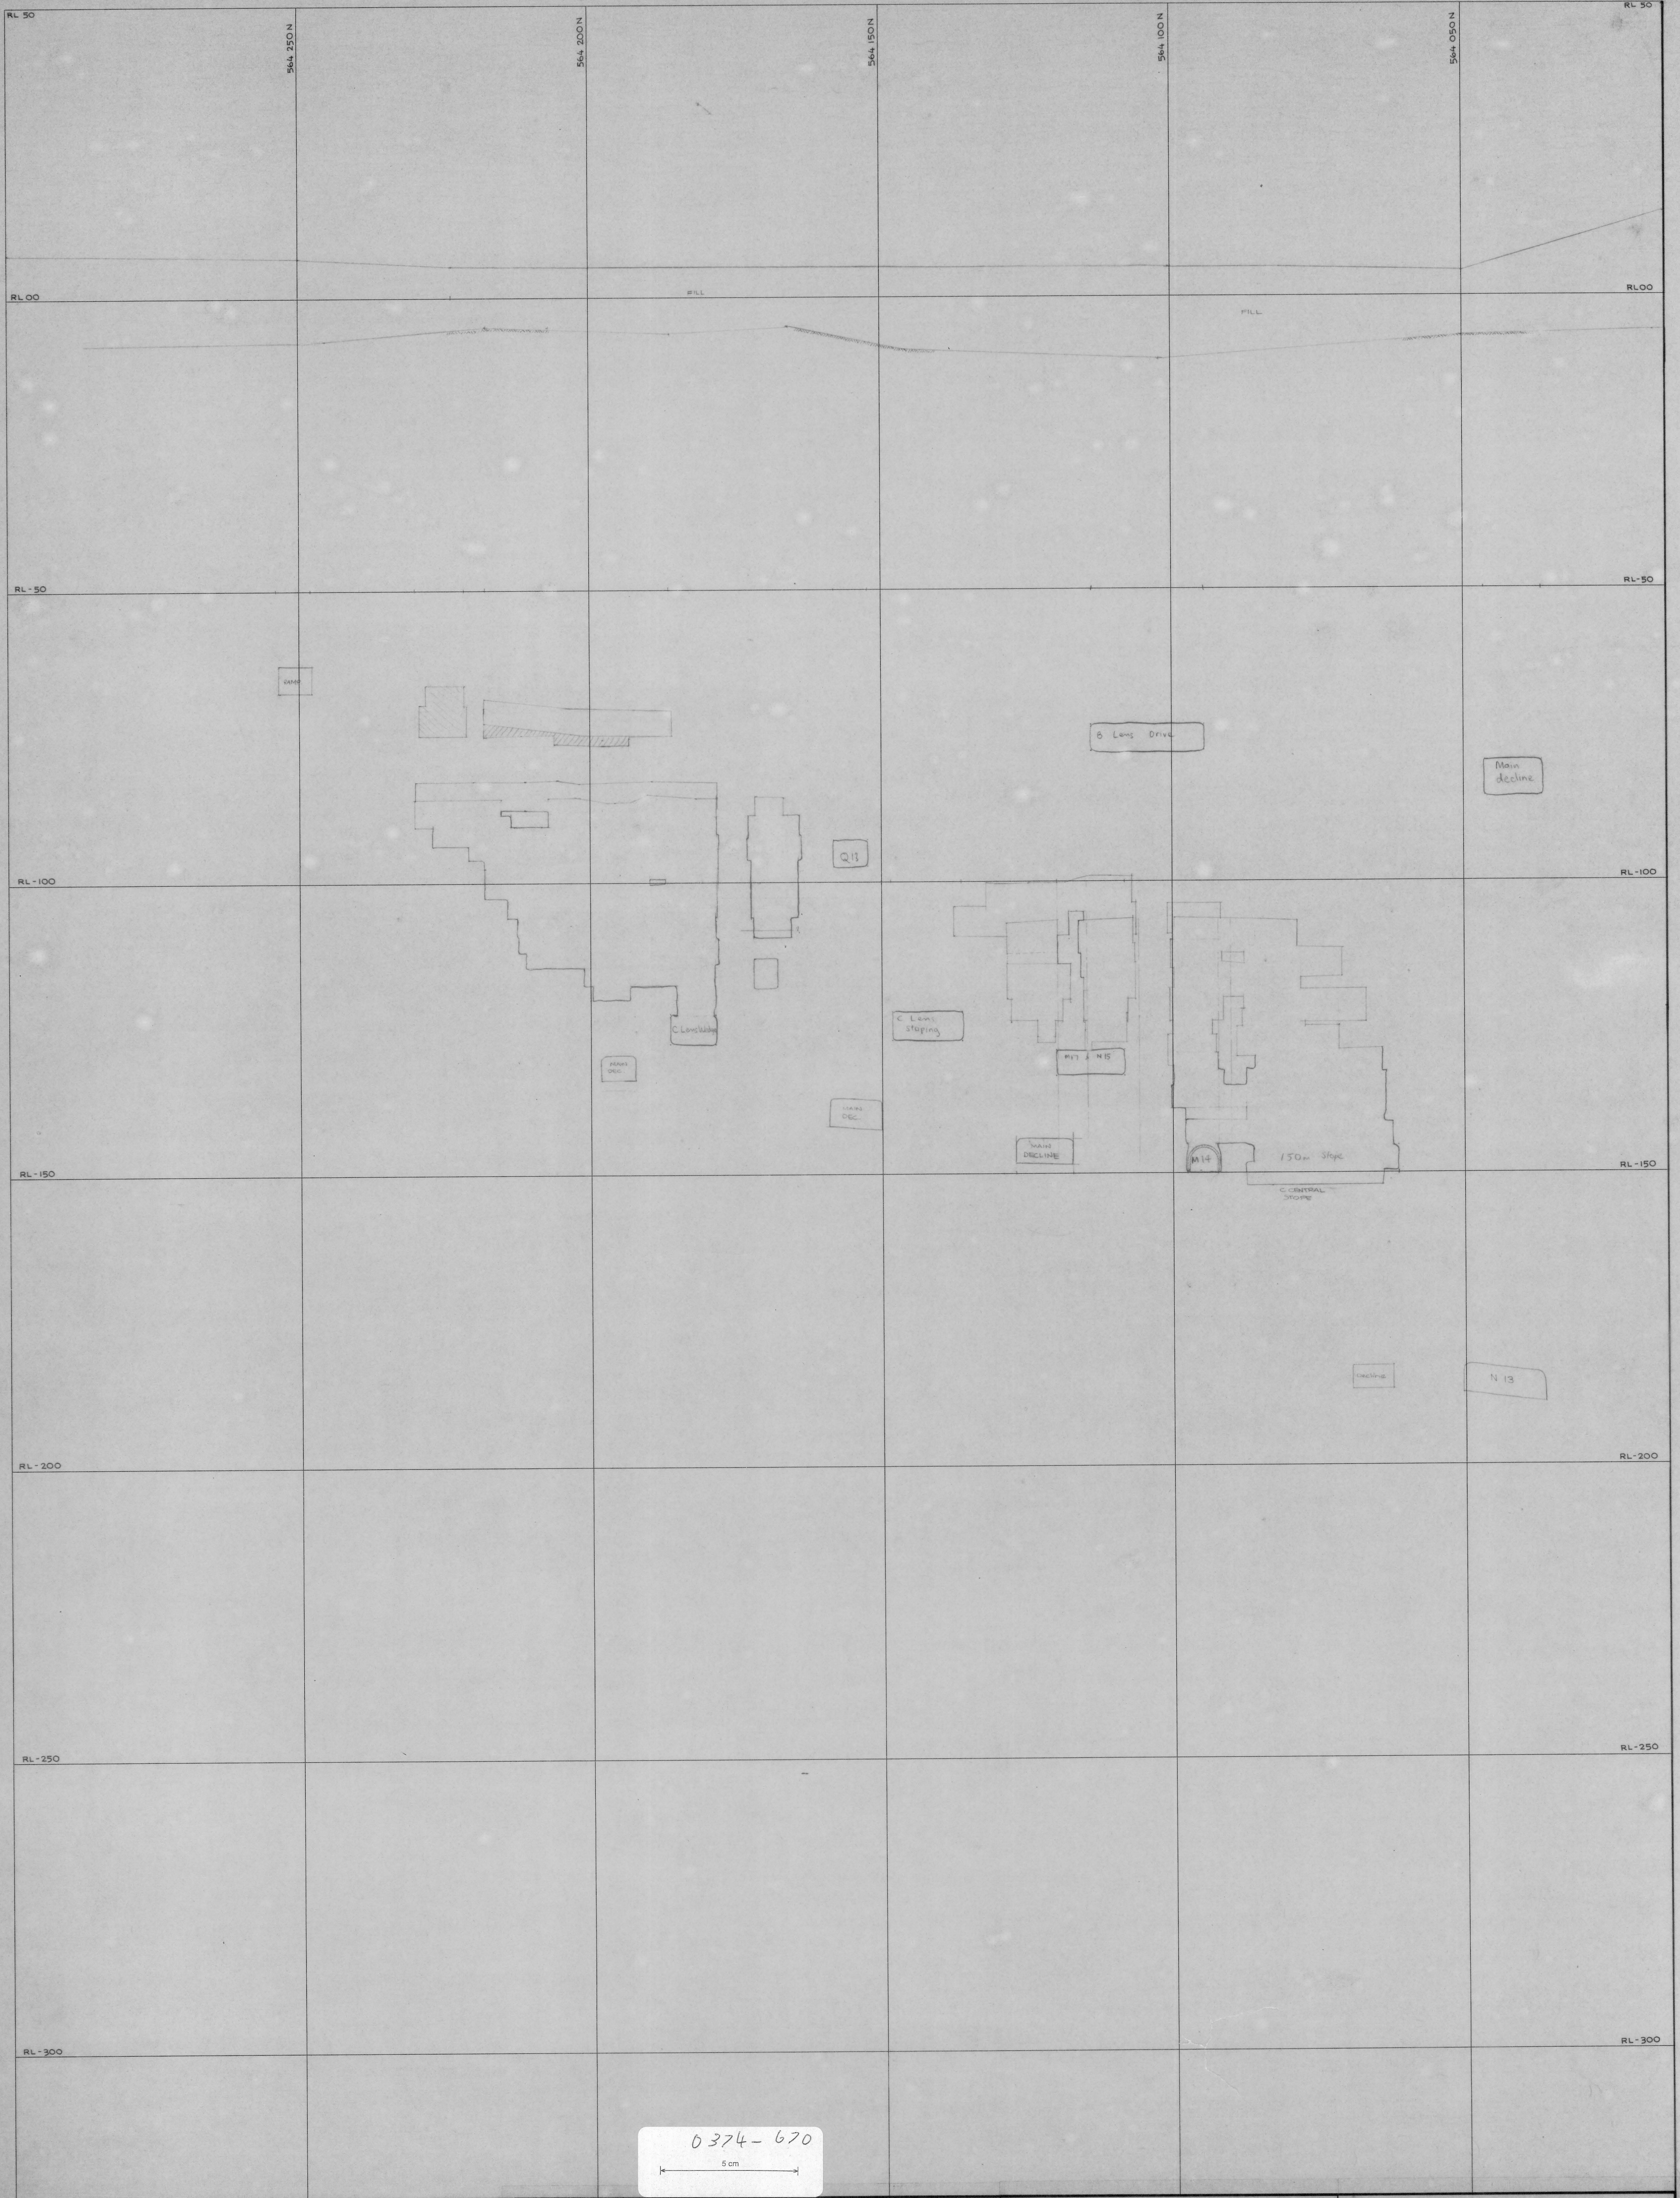

0374-670
5 cm

SCALE 1:500

looking east

LOCATION DOLPHIN MINE
SUBJECT CROSSECTION
220 160 E
PLAN NUMBER 04DM22 - 1023

KIS KING ISLAND SCHEELITE
A DIVISION OF WARMAN INTERNATIONAL
GRASSY KING ISLAND
PLAN NUMBER 04DM22 - 1023

11-22-3-77
[Signature]

82430