


0374-678

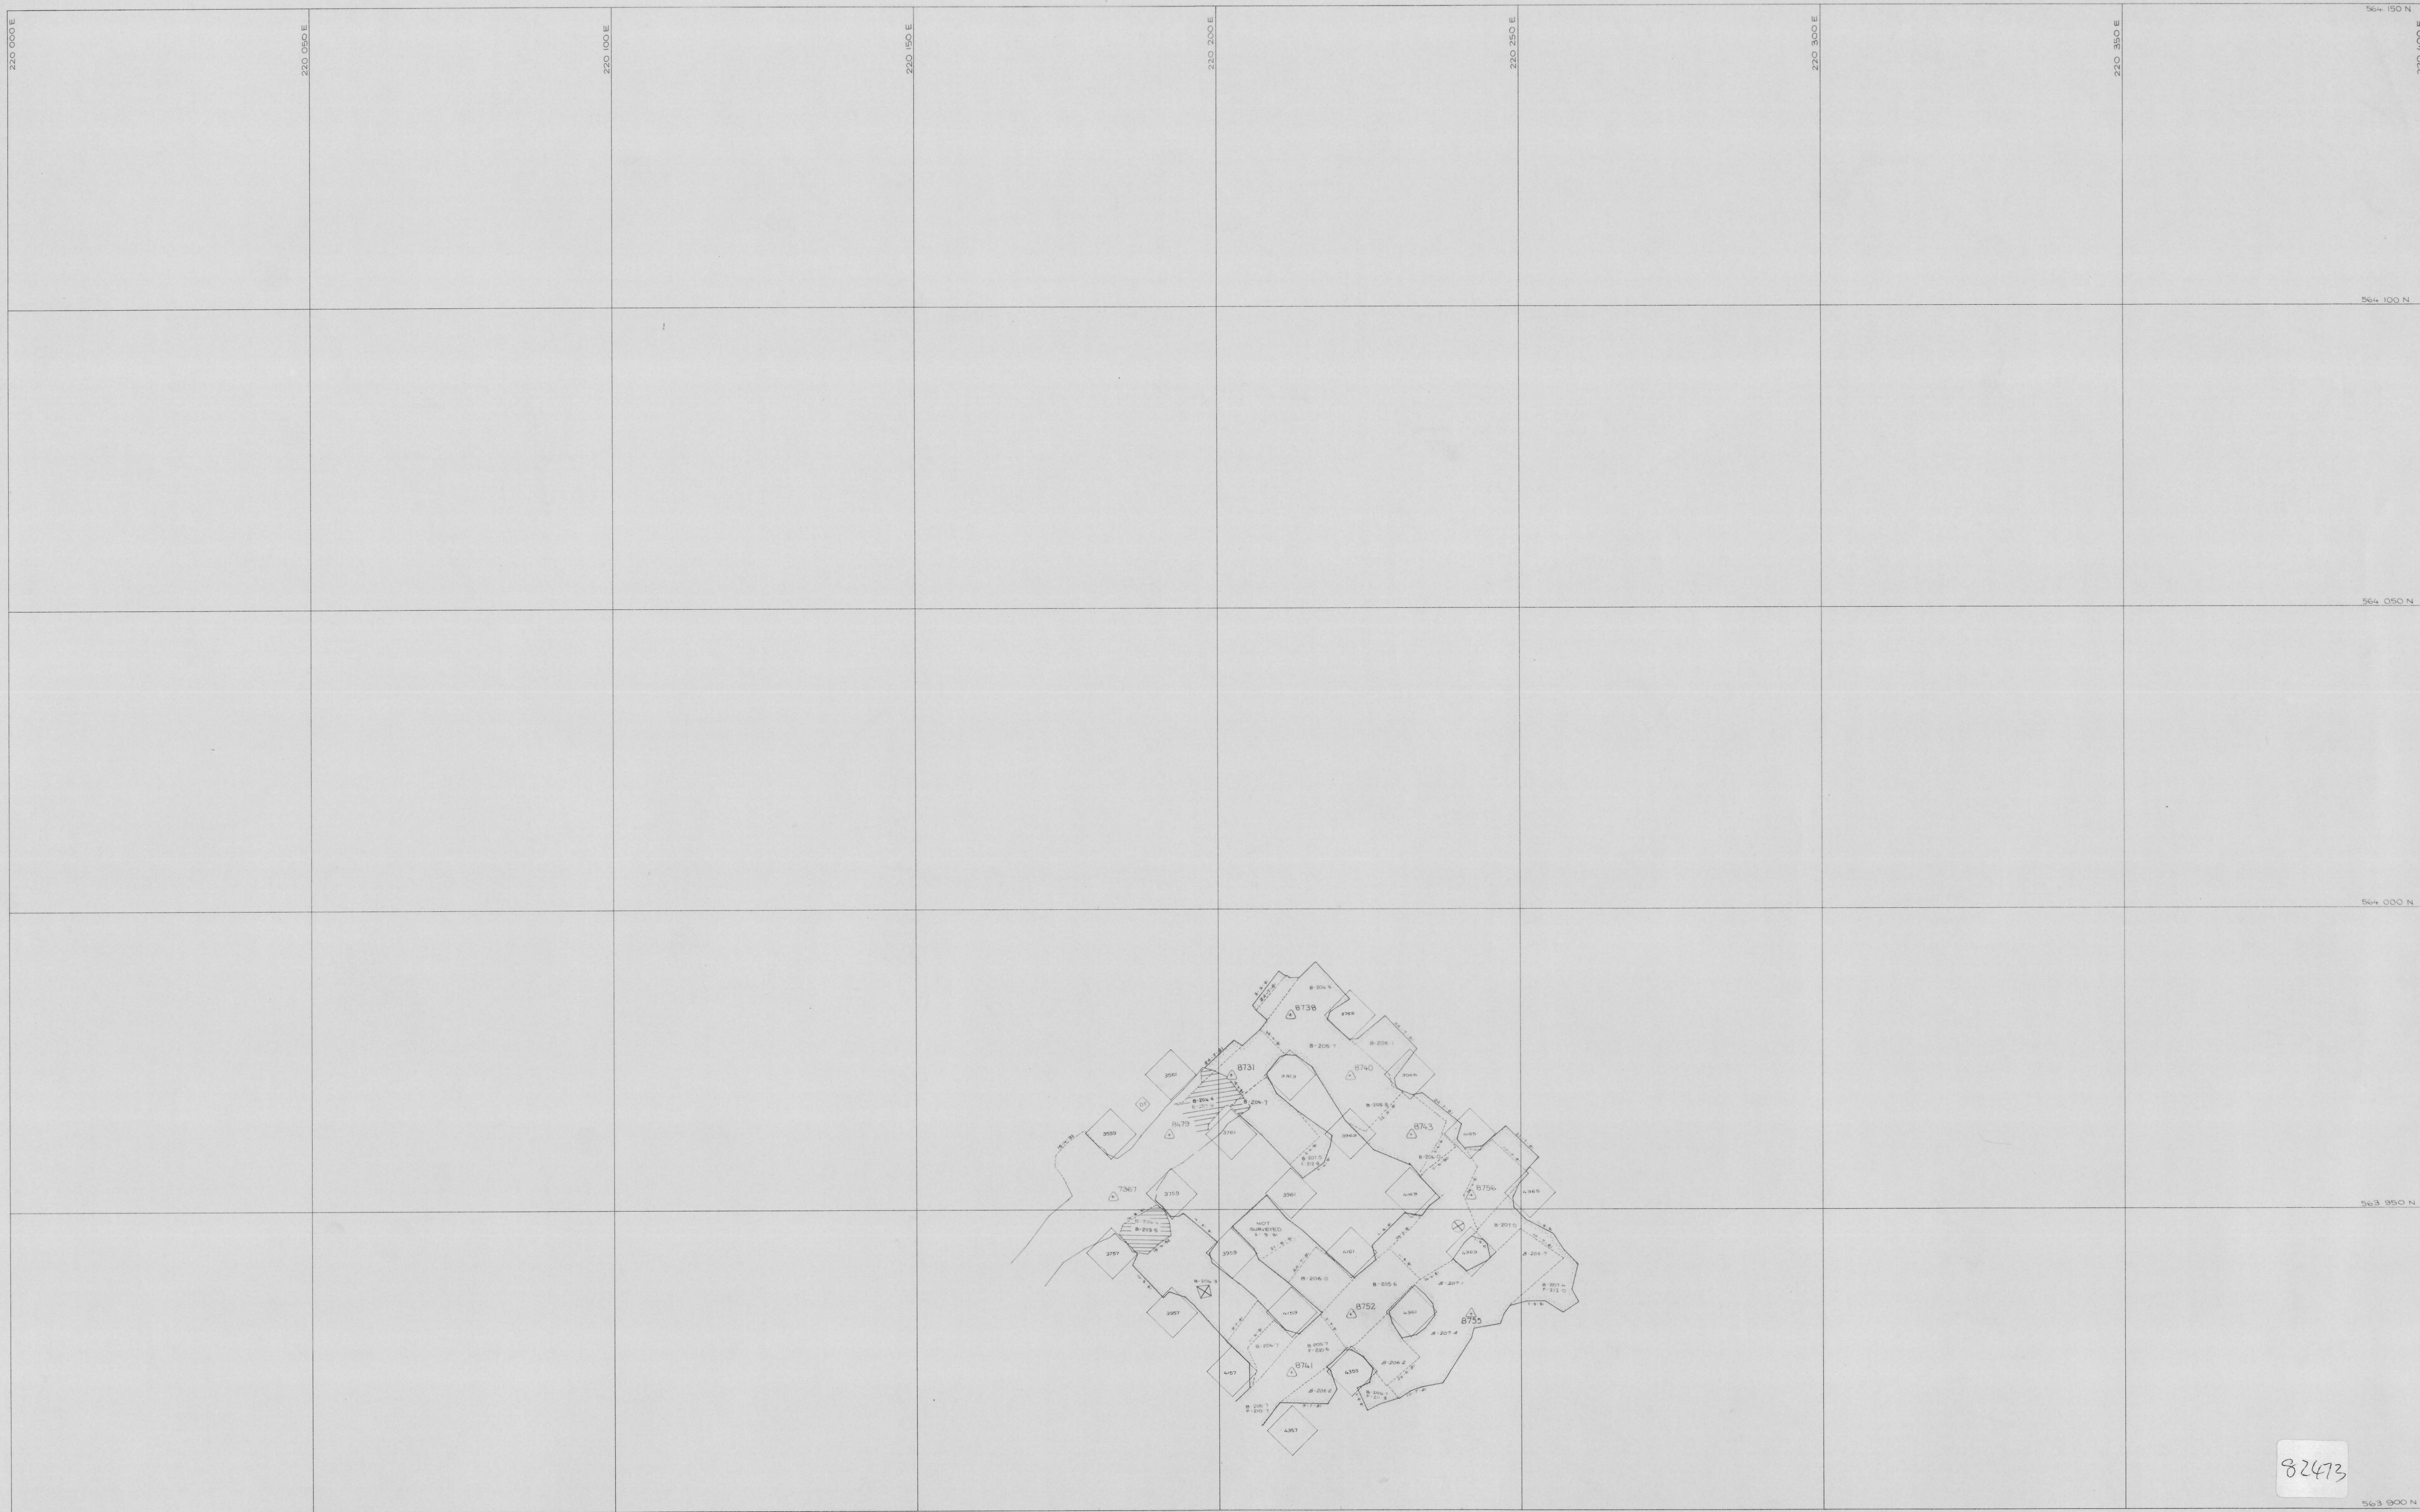

82473

	SCALE 1:500	north	LOCATION DOLPHIN MINE	KIS KING ISLAND SCHEELITE A DIVISION OF WARMAN INTERNATIONAL GRASSY KING ISLAND PLAN NUMBER 04DM15 - 1054
	SUBJECT LOWER PIT STOPE - 209.5m CONTOUR			

5 cm

0374-678

9/4/82