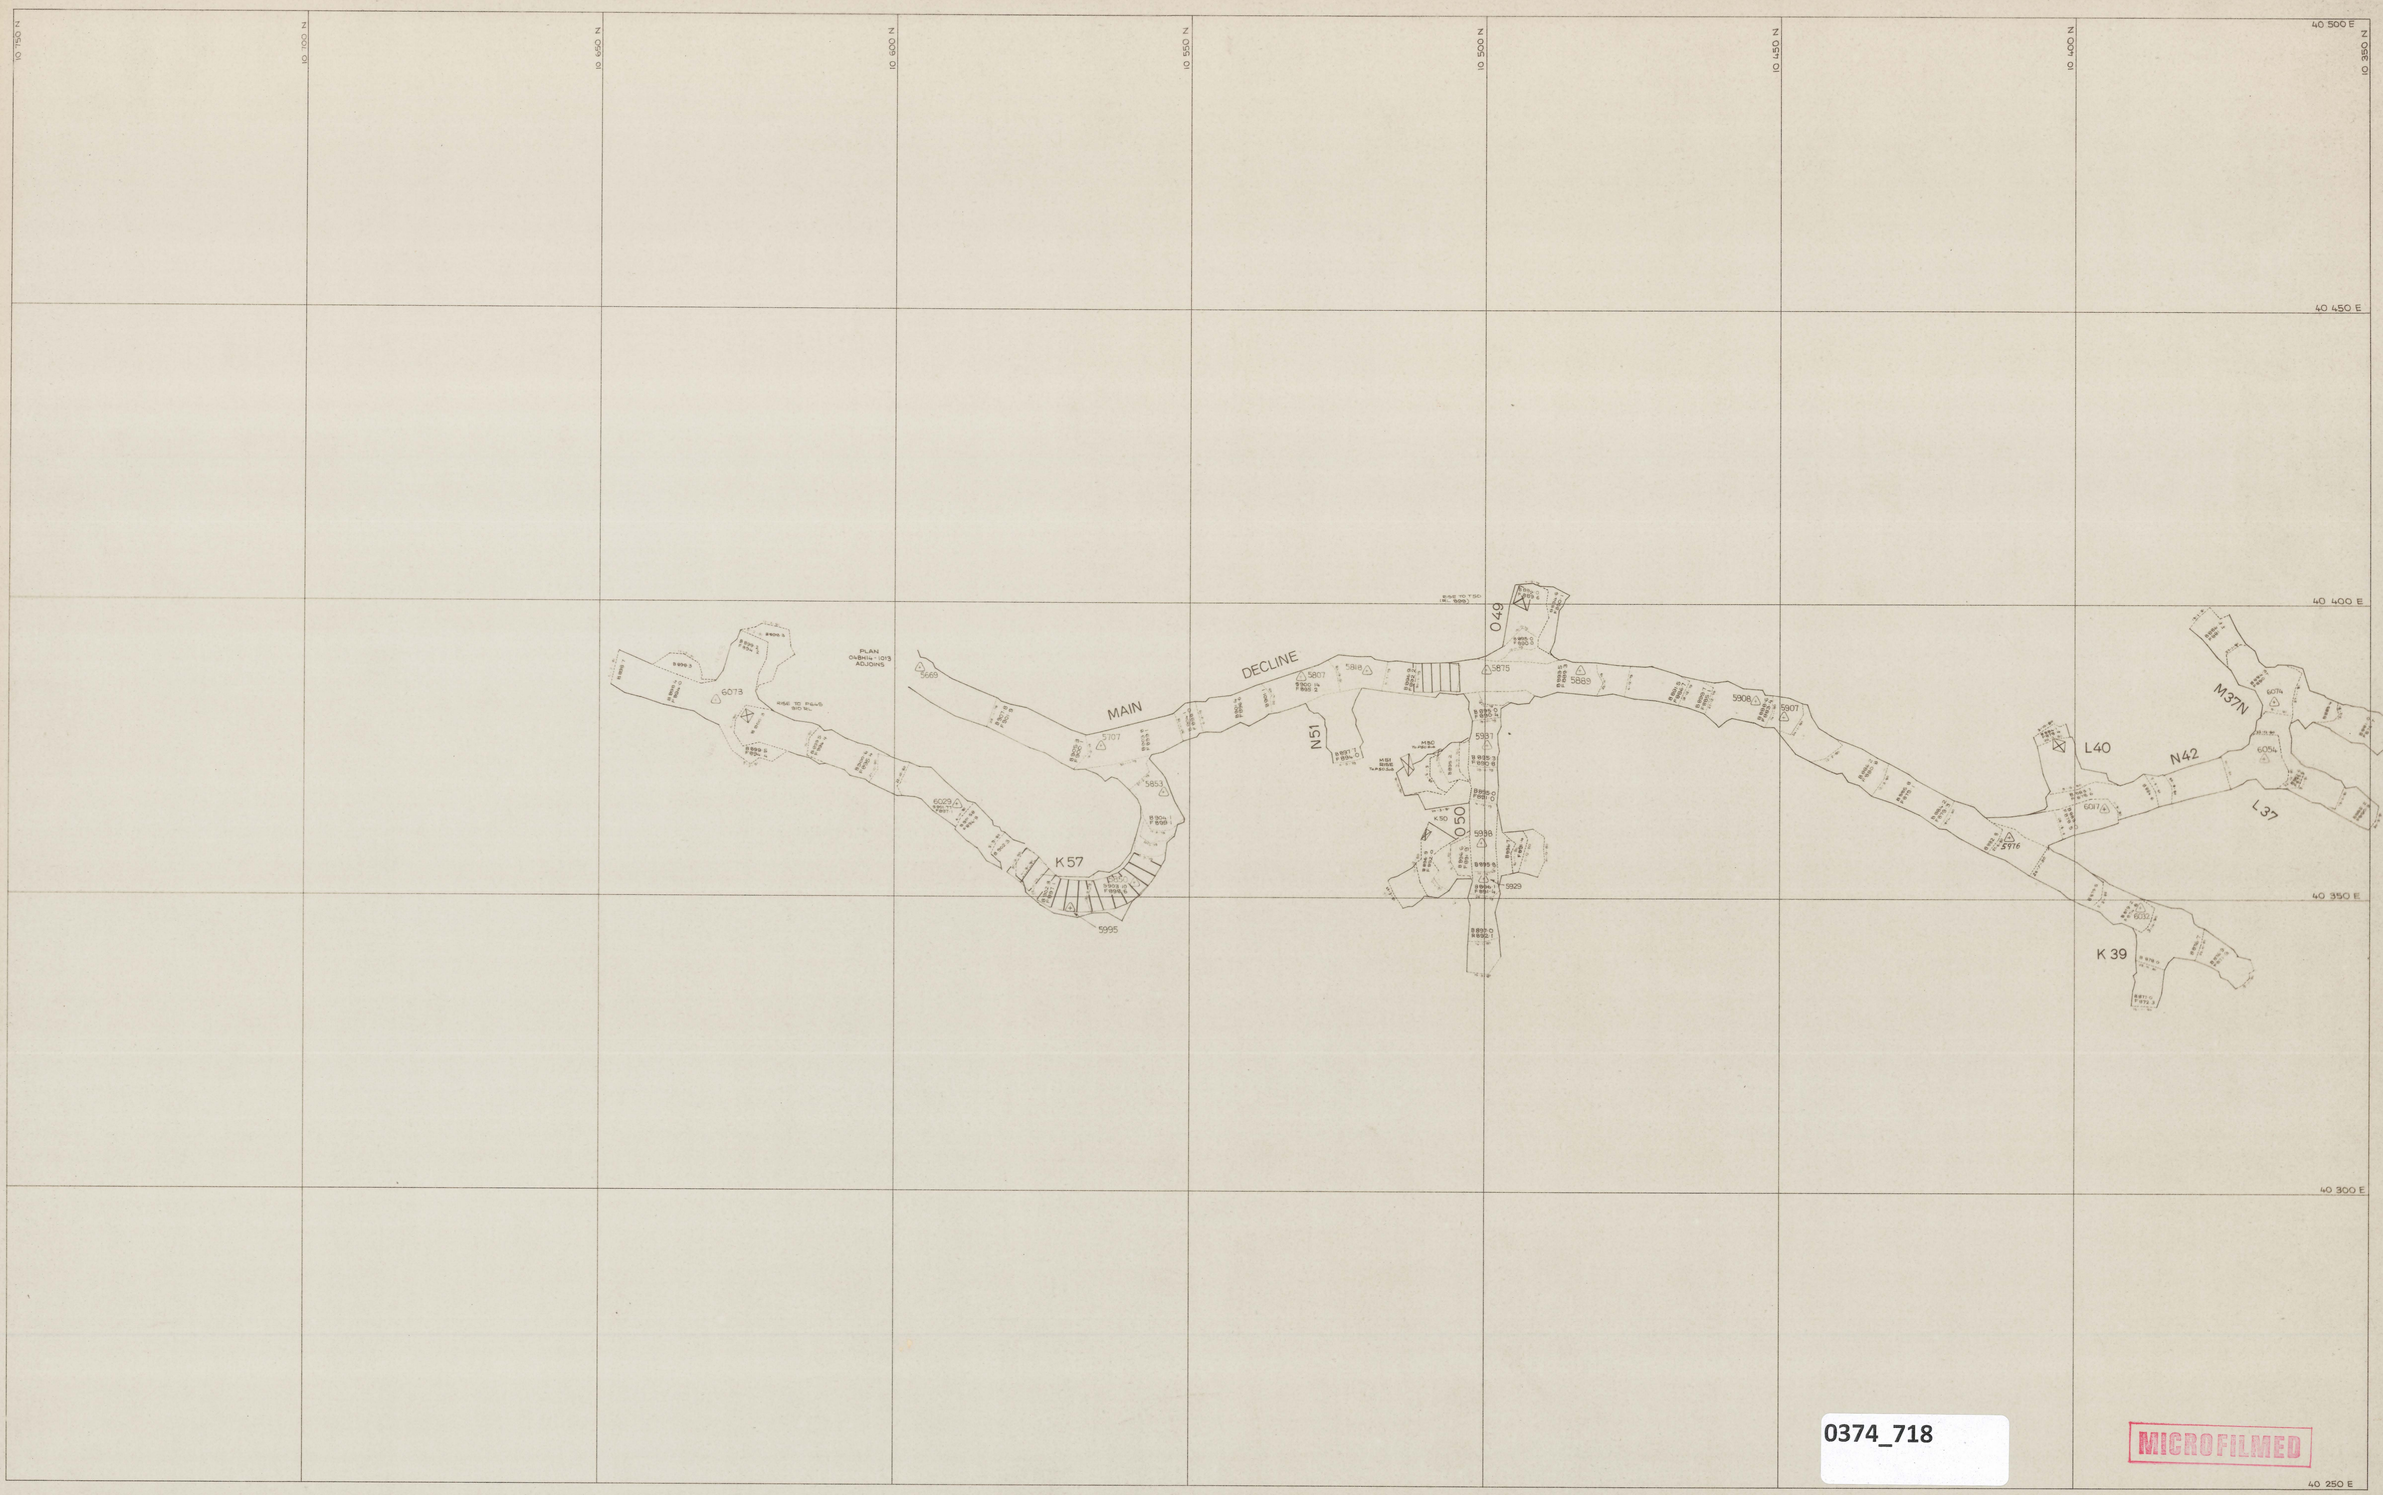

0374_718

MICROFILMED

SCALE 1: 500	north	LOCATION: BOLD HEAD MINE	KING ISLAND SCHEELITE — A DIVISION OF WARMAN INTERNATIONAL
5 cm		SUBJECT: DECLINE DEVELOPMENT	GRASSY KING ISLAND
			PLAN NUMBER: 04BH14 - 1014

0374_718

81048