

10700N

10650N

10600N

10550N

10500N

10450N

10400N


40450E

40400E

40350E

40300E



40250E

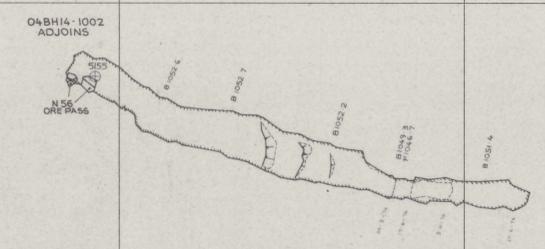

MICROFILMED

0374_719

SCALE 1:500

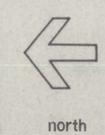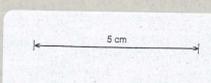

LOCATION	BOLD HEAD MINE
SUBJECT	A LENS H 50 STOPE, 1052m CONTOUR
PLAN NUMBER	04BH15 - 1001

KIS KING ISLAND SCHEELITE
A DIVISION OF WARMAN INTERNATIONAL

GRASSY KING ISLAND

0374_719