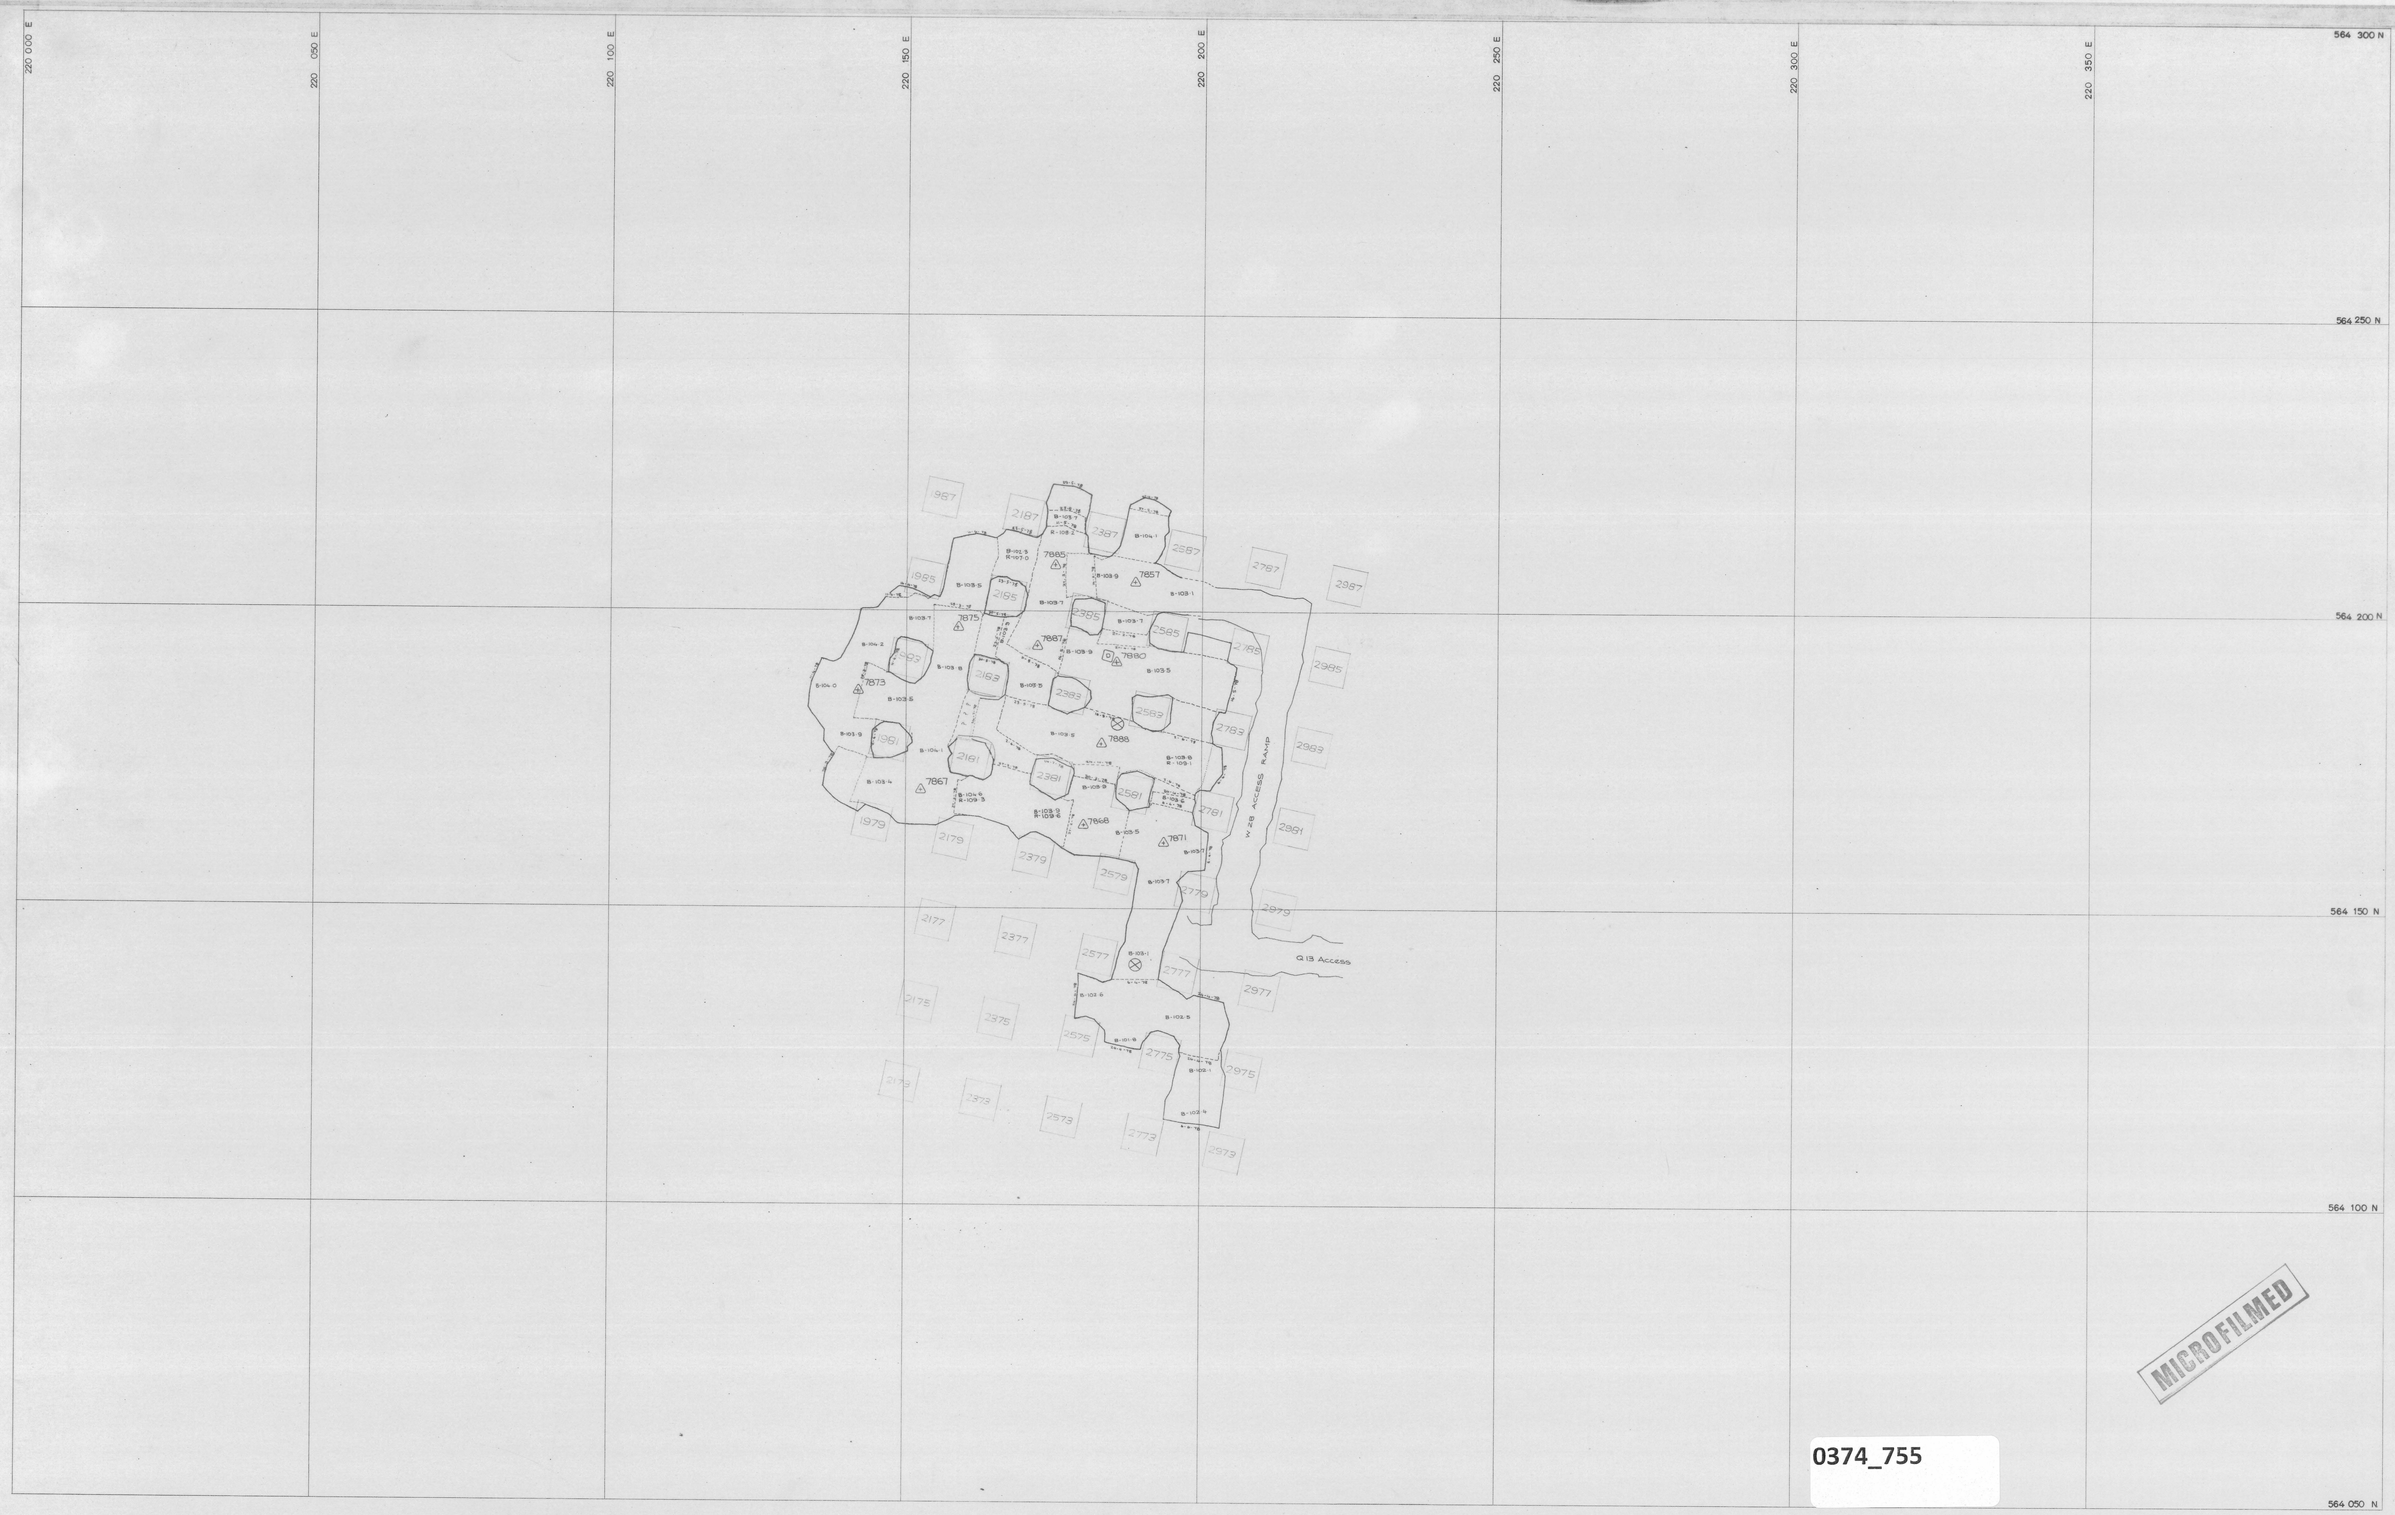

MICROFILMED

0374_755

0374_755

SCALE 1 500		LOCATION DOLPHIN MINE	KING ISLAND SCHEELITE A DIVISION OF WARMAN INTERNATIONAL
5 cm	north	SUBJECT C' LENS WEDGE -107m CONTOUR	GRASSY KING ISLAND
			PLAN NUMBER 04DM15-1016 79058