

10700N

10650N

10600N

10550N

10500N

10450N

10400N


40450E

40400E

40350E

40300E


40250E

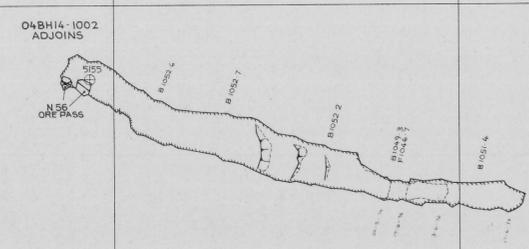

MICROFILMED

0374_800

SCALE 1:500

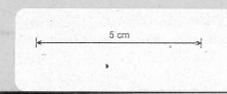

LOCATION BOLD HEAD MINE

SUBJECT
A LENS
 H 50 STOPE, 1052m CONTOUR

KIS KING ISLAND SCHEELITE
 A DIVISION OF WARMAN INTERNATIONAL
 GRASSY KING ISLAND

PLAN NUMBER
 04BH15 - 1001 *xx049*

0374_800