220 000 E
220 050 E
220 100 E
220 150 E
220 200 E
220 250 E
220 300 E
220 350 E
220 400 E
564 200 N
564 150 N
564 100 N
564 050 N
564 000 N
563 950 N

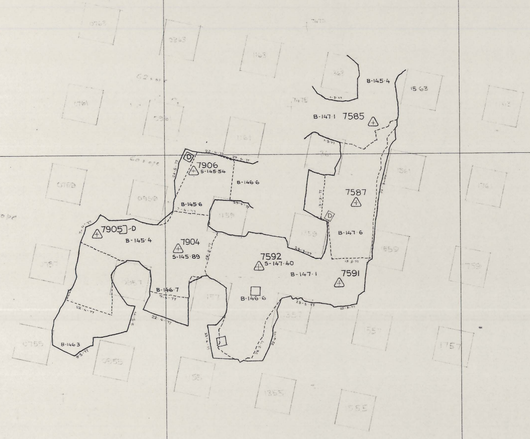

0374_810

MICROFILMED

SCALE 1 : 500	north	LOCATION DOLPHIN MINE	KING ISLAND SCHEELITE A DIVISION OF WARMAN INTERNATIONAL	
5 cm		SUBJECT C PIT - 150·5m CONTOUR	GRASSY	KING ISLAND
			PLAN NUMBER 04DM15 -	XX039

M-23-2-77

0374_810