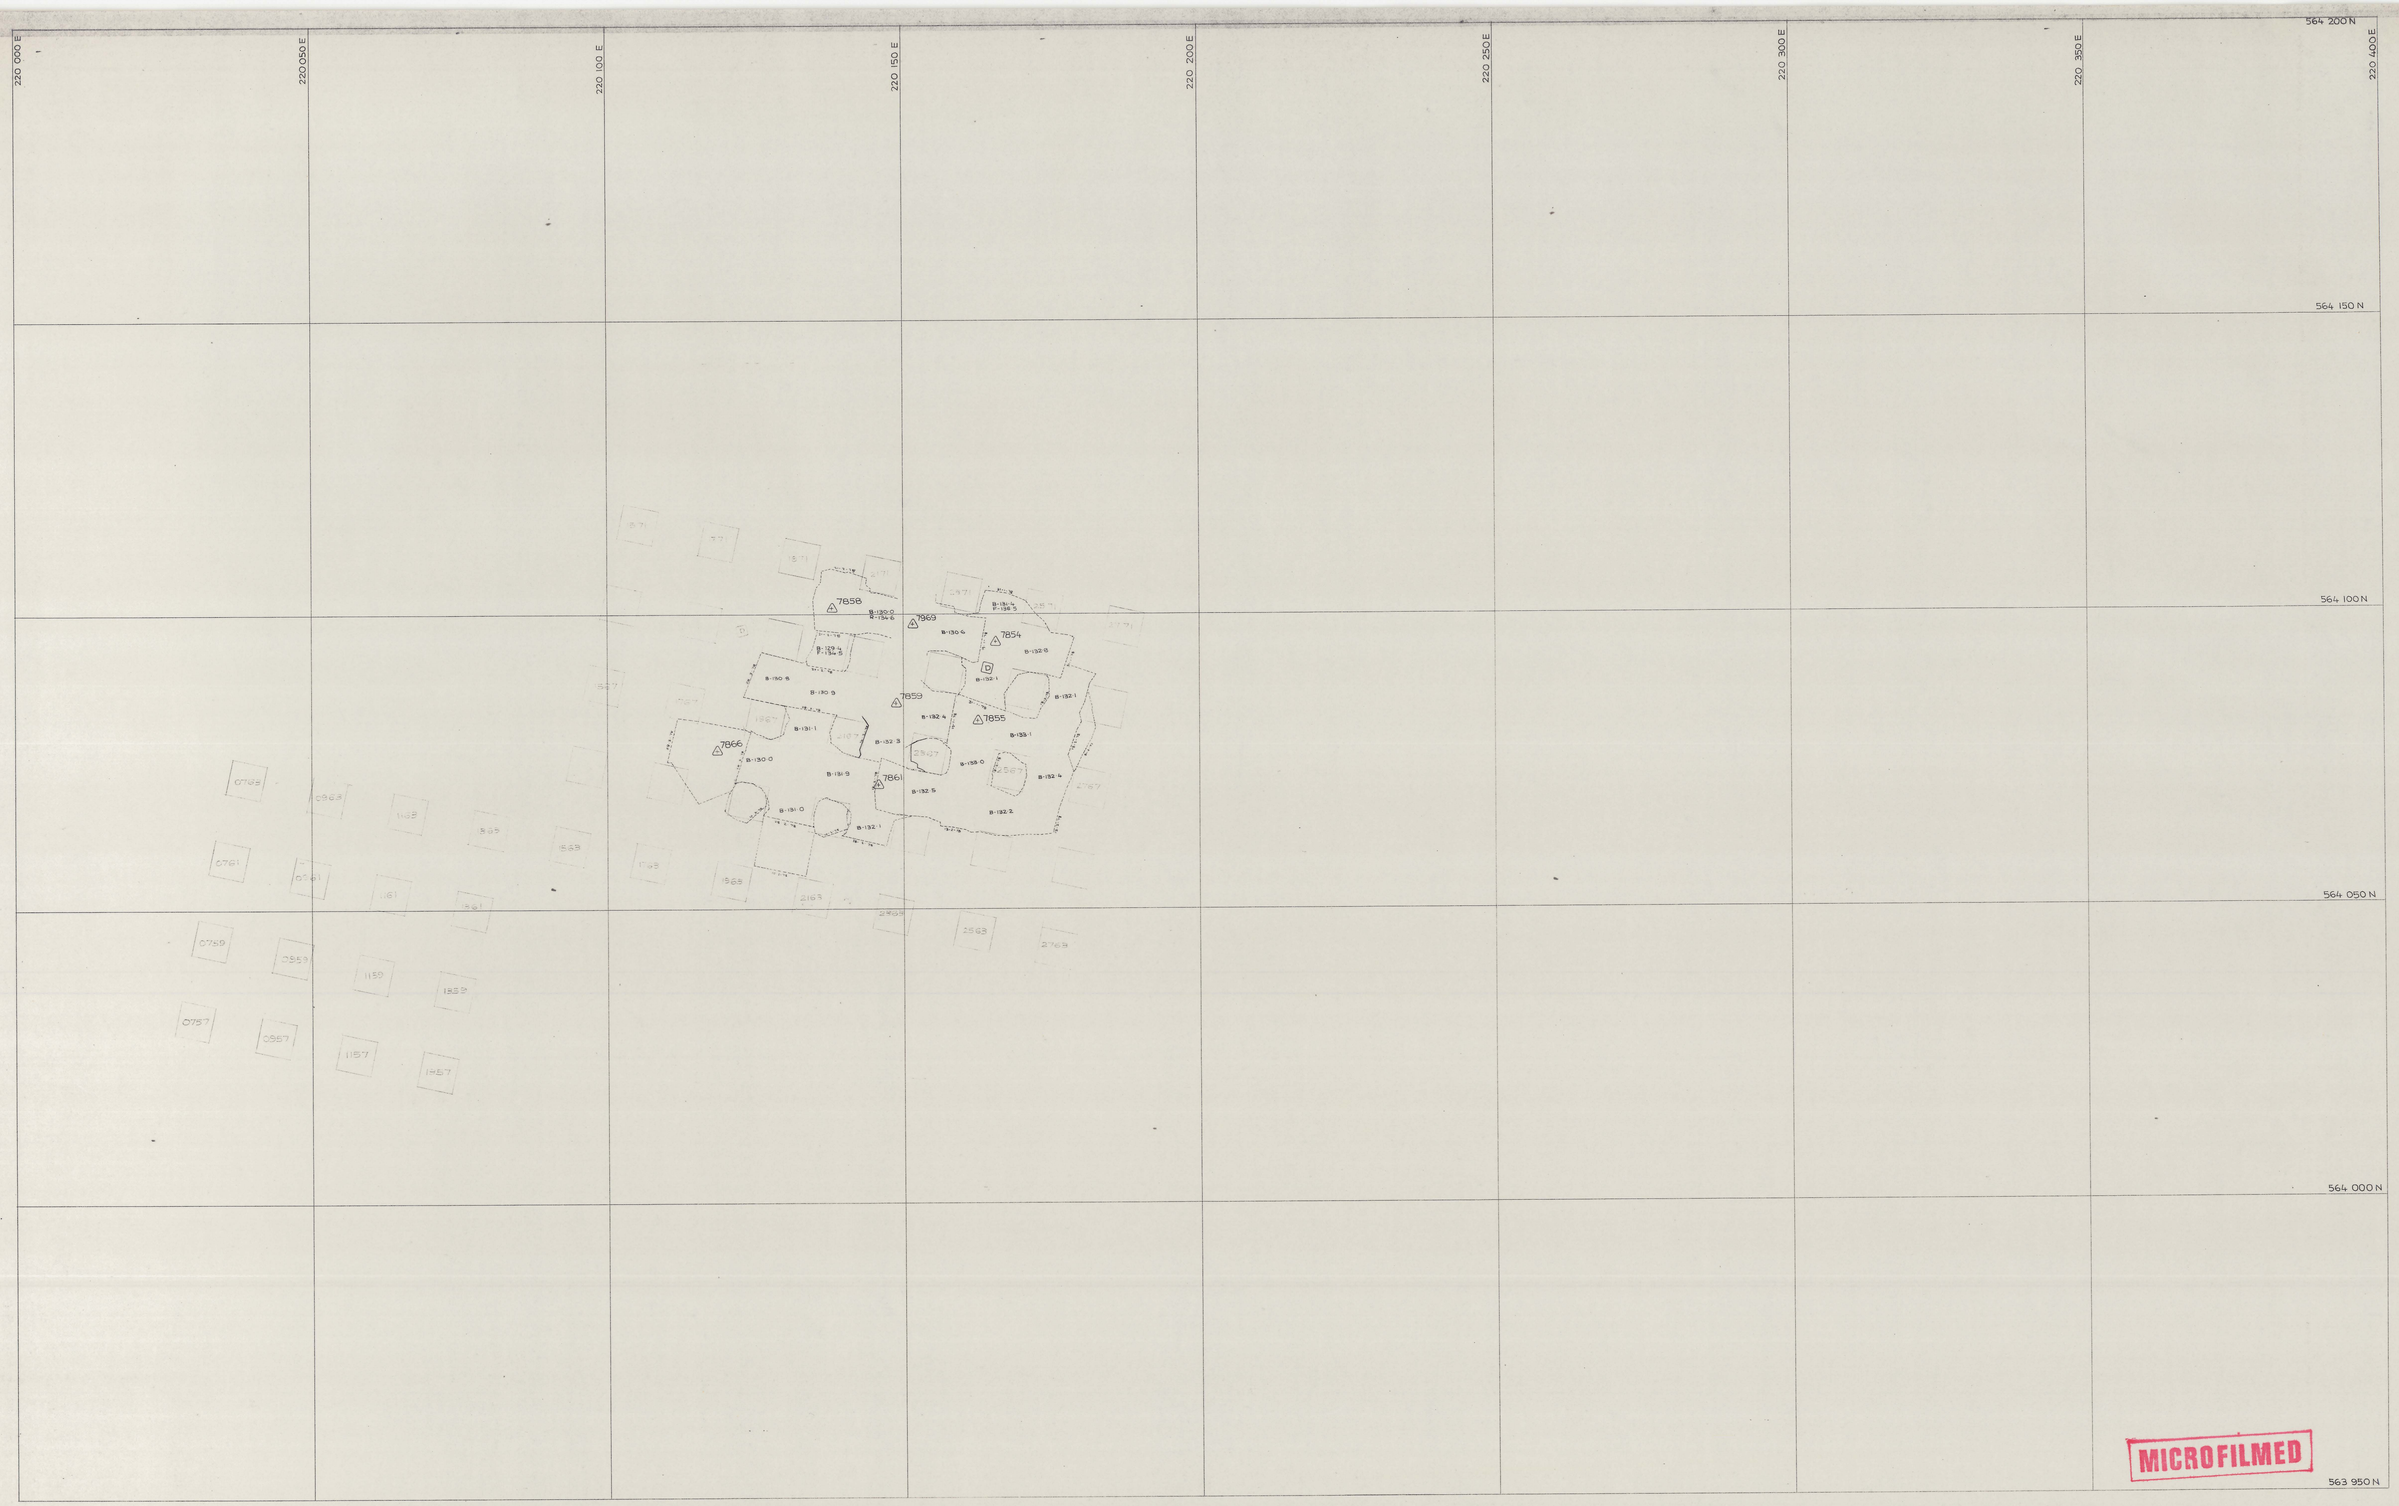

SCALE 1:500

5 cm

north

LOCATION

DOLPHIN MINE

SUBJECT

- 135 m CONTOUR

C CENTRAL & C PIT STOPES

KING ISLAND SCHEELITE
A DIVISION OF WARMAN INTERNATIONAL

GRASSY KING ISLAND

PLAN NUMBER

04DM15 - 1046

XX033

0374_816

0374_816