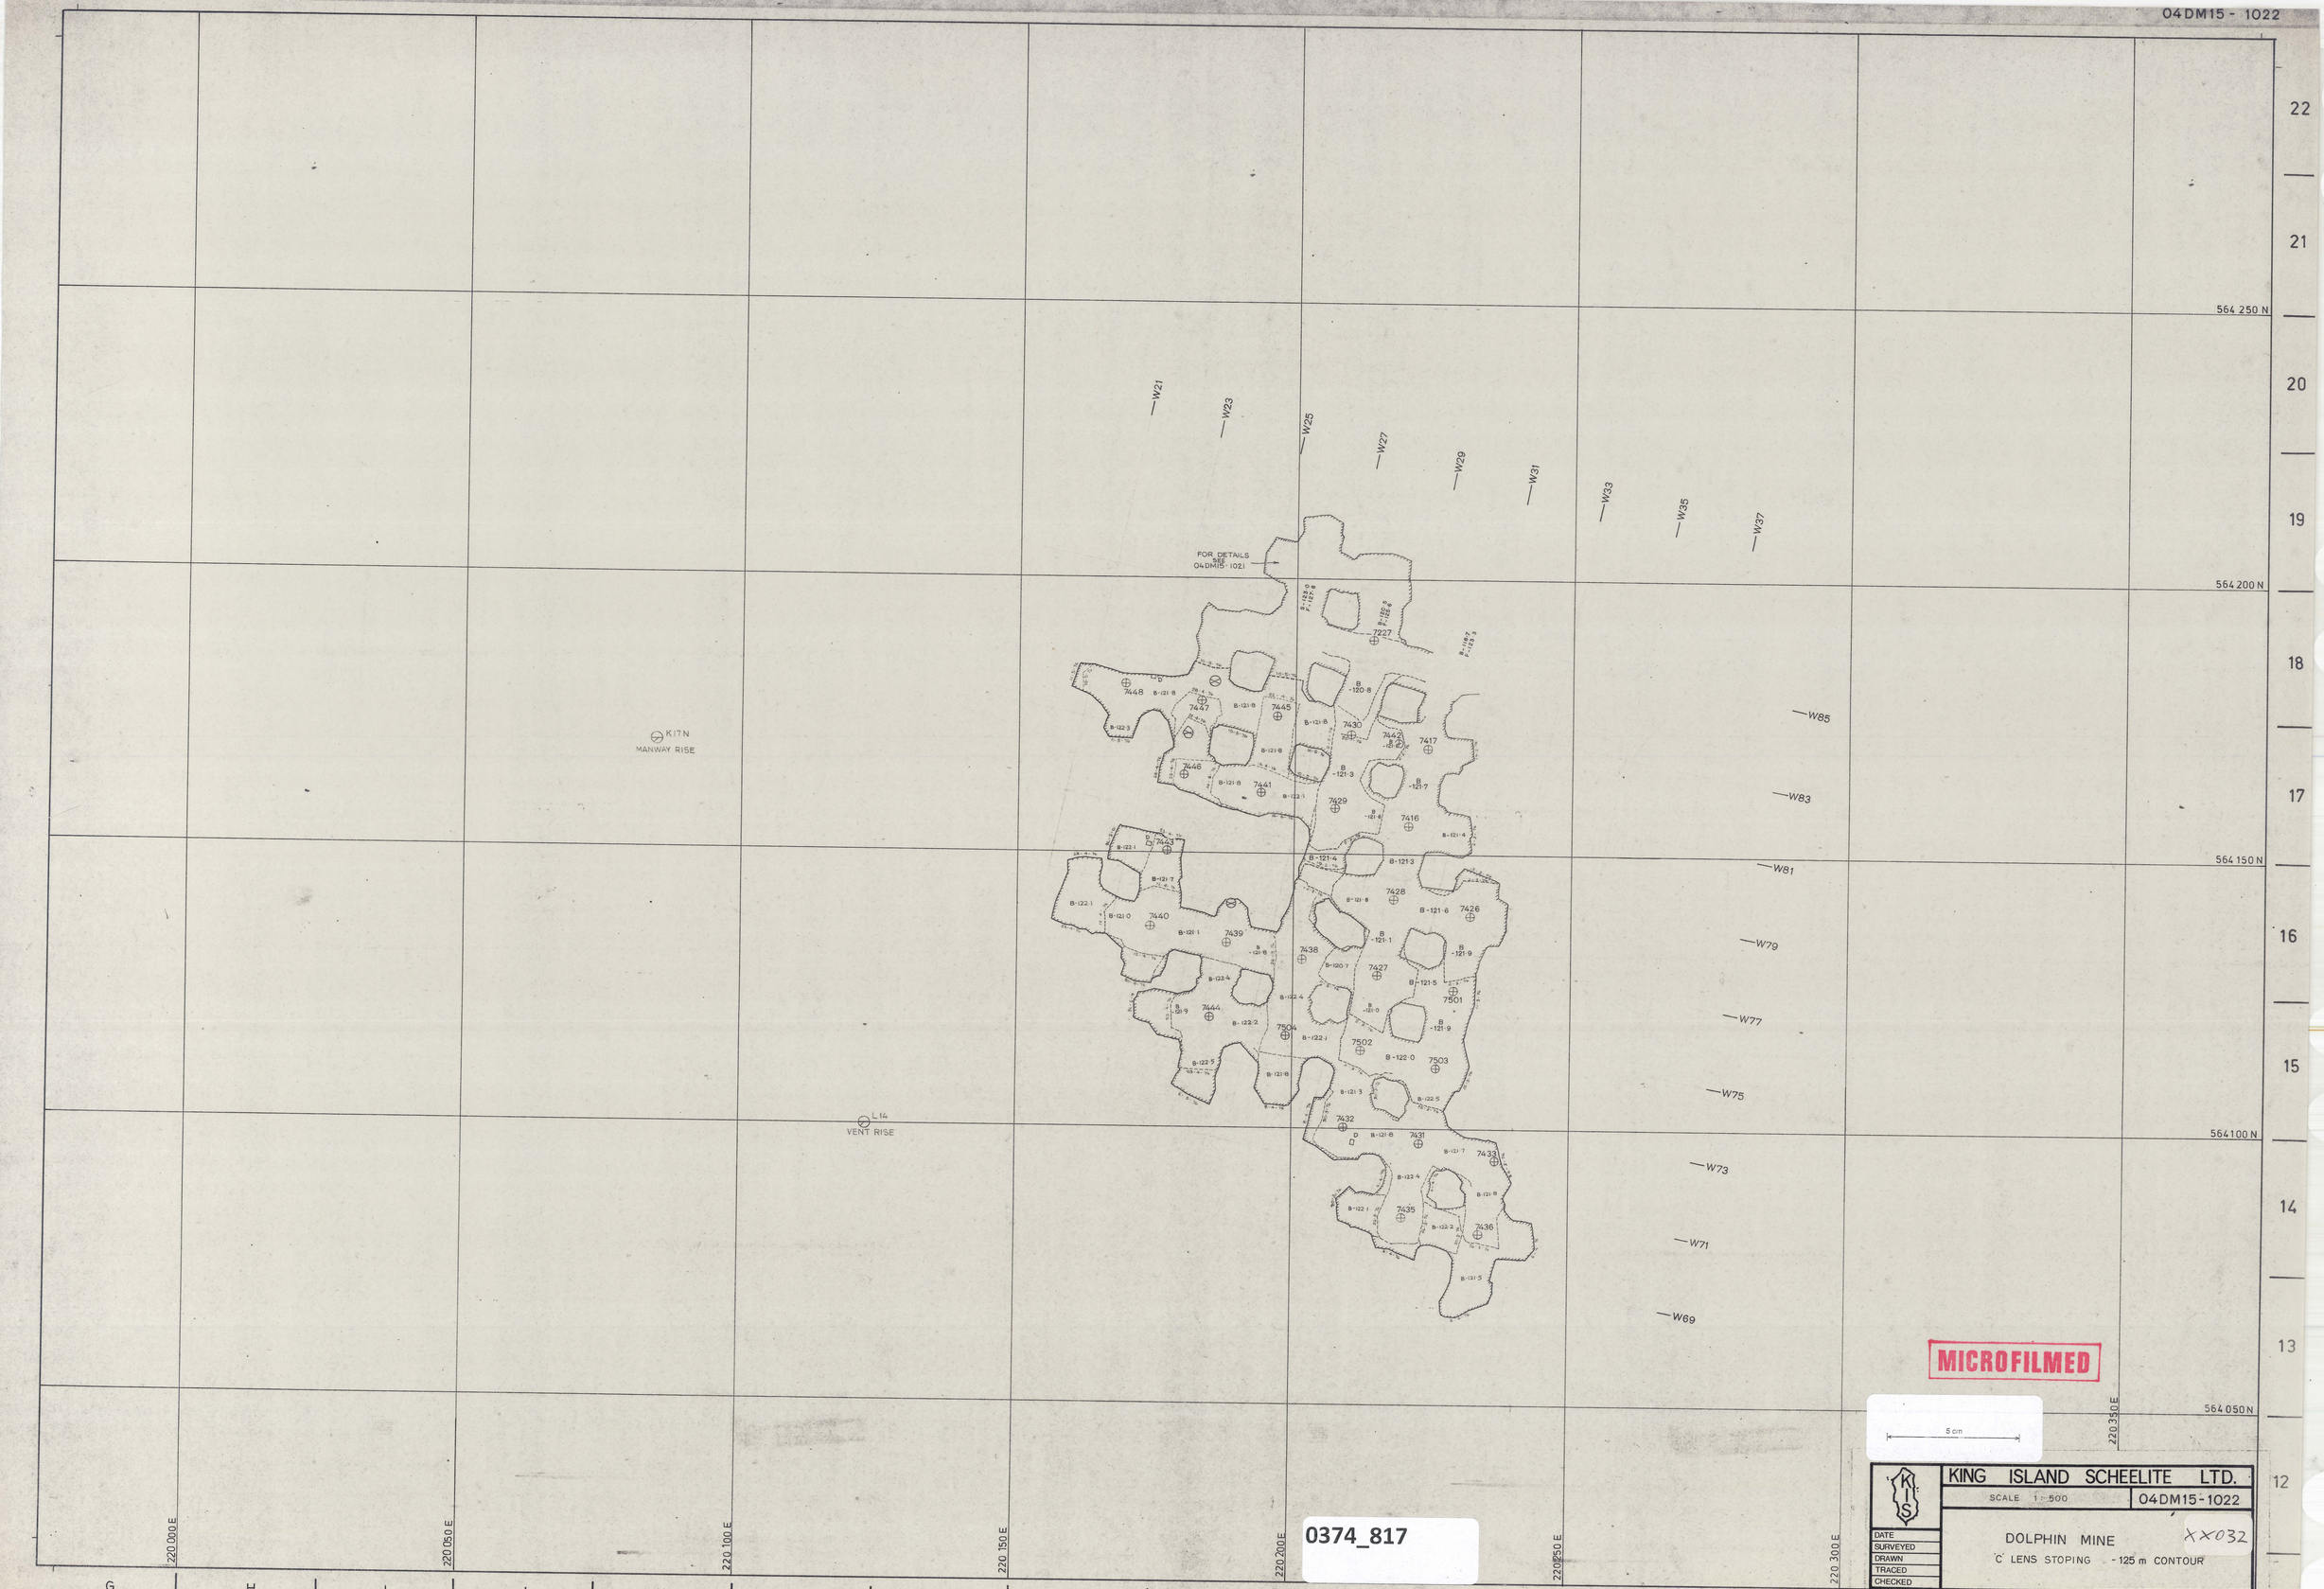
22
21
20
19
18
17
16
15
14
13
12
11
564 250 N
564 200 N
564 150 N
564 100 N
564 050 N
220 000 E
220 050 E
220 100 E
220 150 E
220 200 E
220 250 E
220 300 E
220 350 E
G
H
I
J
K
L
M
N
O
P
Q
R
S
T
U
V
W21
W23
W25
W27
W29
W31
W33
W35
W37
W85
W83
W81
W79
W77
W75
W73
W71
W69
FOR DETAILS SEE 04DM15-1021
K17N
MANWAY RISE
L14
VENT RISE
7448
7447
7445
7446
7441
7443
7440
7439
7444
7504
7438
7429
7430
7442
7417
7416
7428
7426
7427
7501
7502
7503
7432
7431
7433
7435
7436
7227
B-121·8
B-122·3
B-121·3
B-121·7
B-121·6
B-121·4
B-122·1
B-121·0
B-121·1
B-121·9
B-122·4
B-122·2
B-122·5
B-120·8
B-120·7
B-121·5
B-122·0
B-122·6
B-121·8
B-122·4
B-121·7
B-121·5
MICROFILMED
5 cm
KING ISLAND SCHEELITE LTD.
SCALE 1:500
04DM15-1022
DATE
SURVEYED
DRAWN
TRACED
CHECKED
DOLPHIN MINE
'C' LENS STOPING - 125 m CONTOUR
XX032
0374_817
0374_817