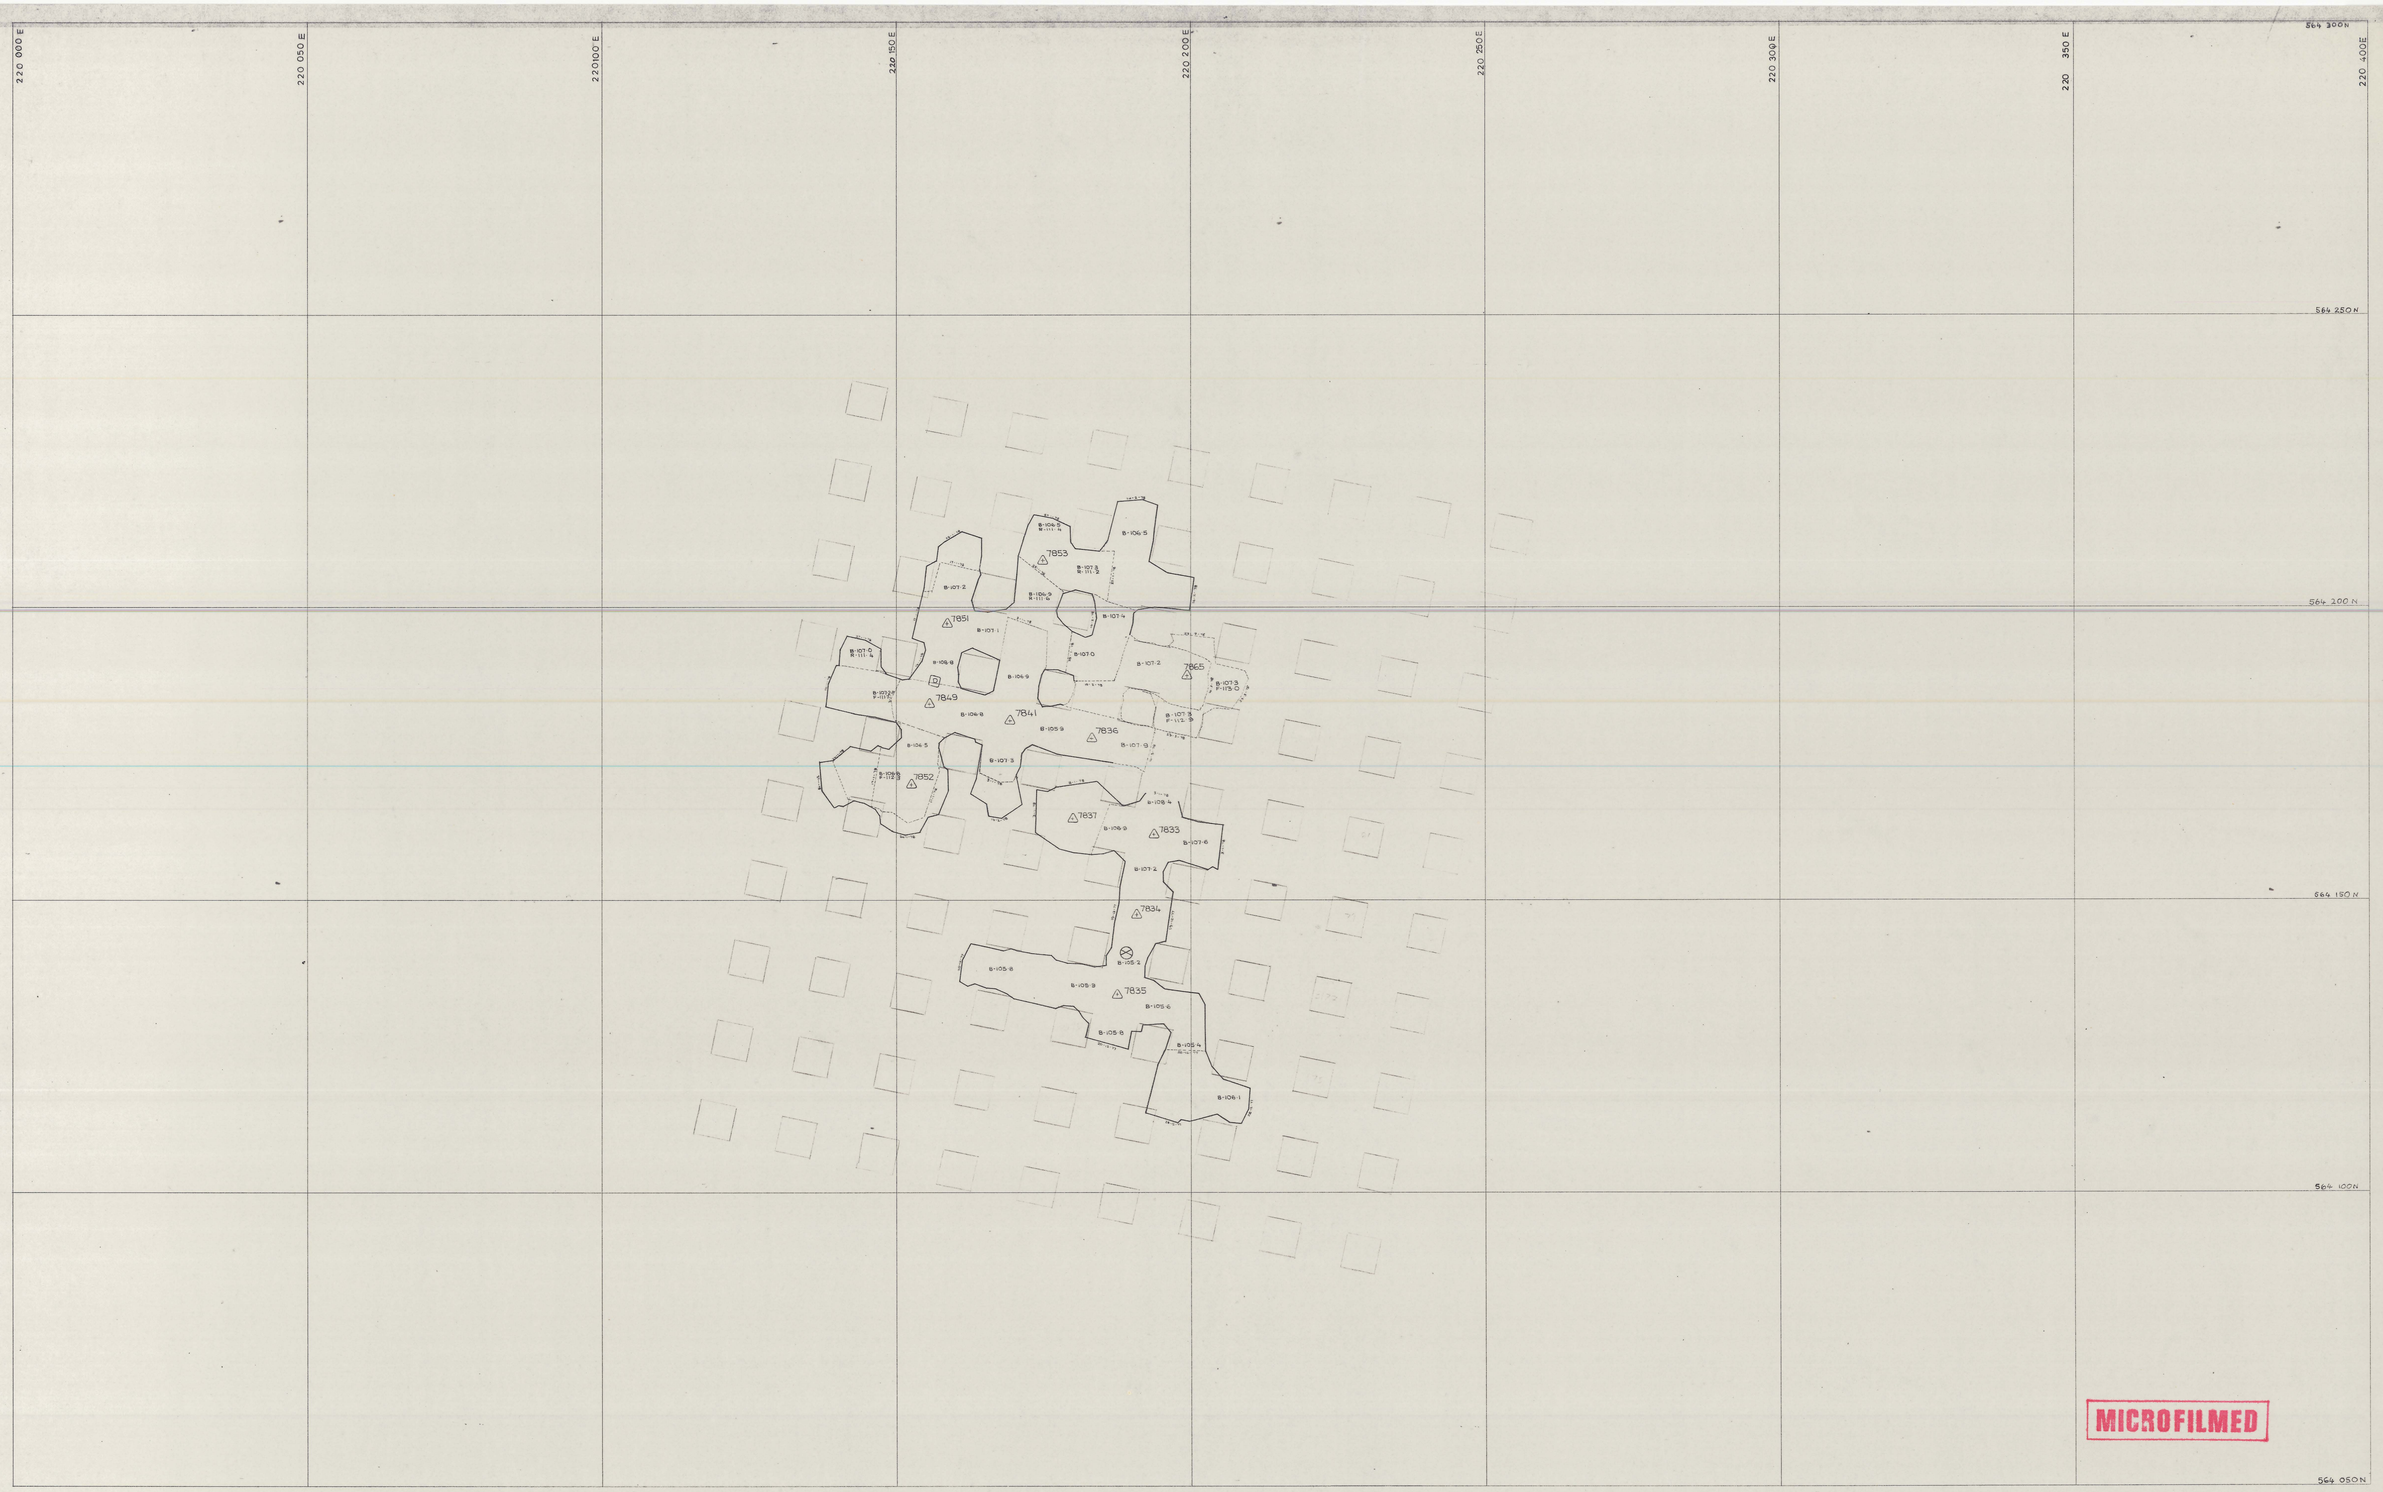

MICROFILMED

0374_822

0374_822	SCALE 1 : 500	north	LOCATION DOLPHIN MINE
	5 cm		SUBJECT C LENS WEDGE 110 m - CONTOUR
			KING ISLAND SCHEELITE A DIVISION OF WARMAN INTERNATIONAL
			GRASSY KING ISLAND
			PLAN NUMBER 04DM15-1017 (?)

XX027