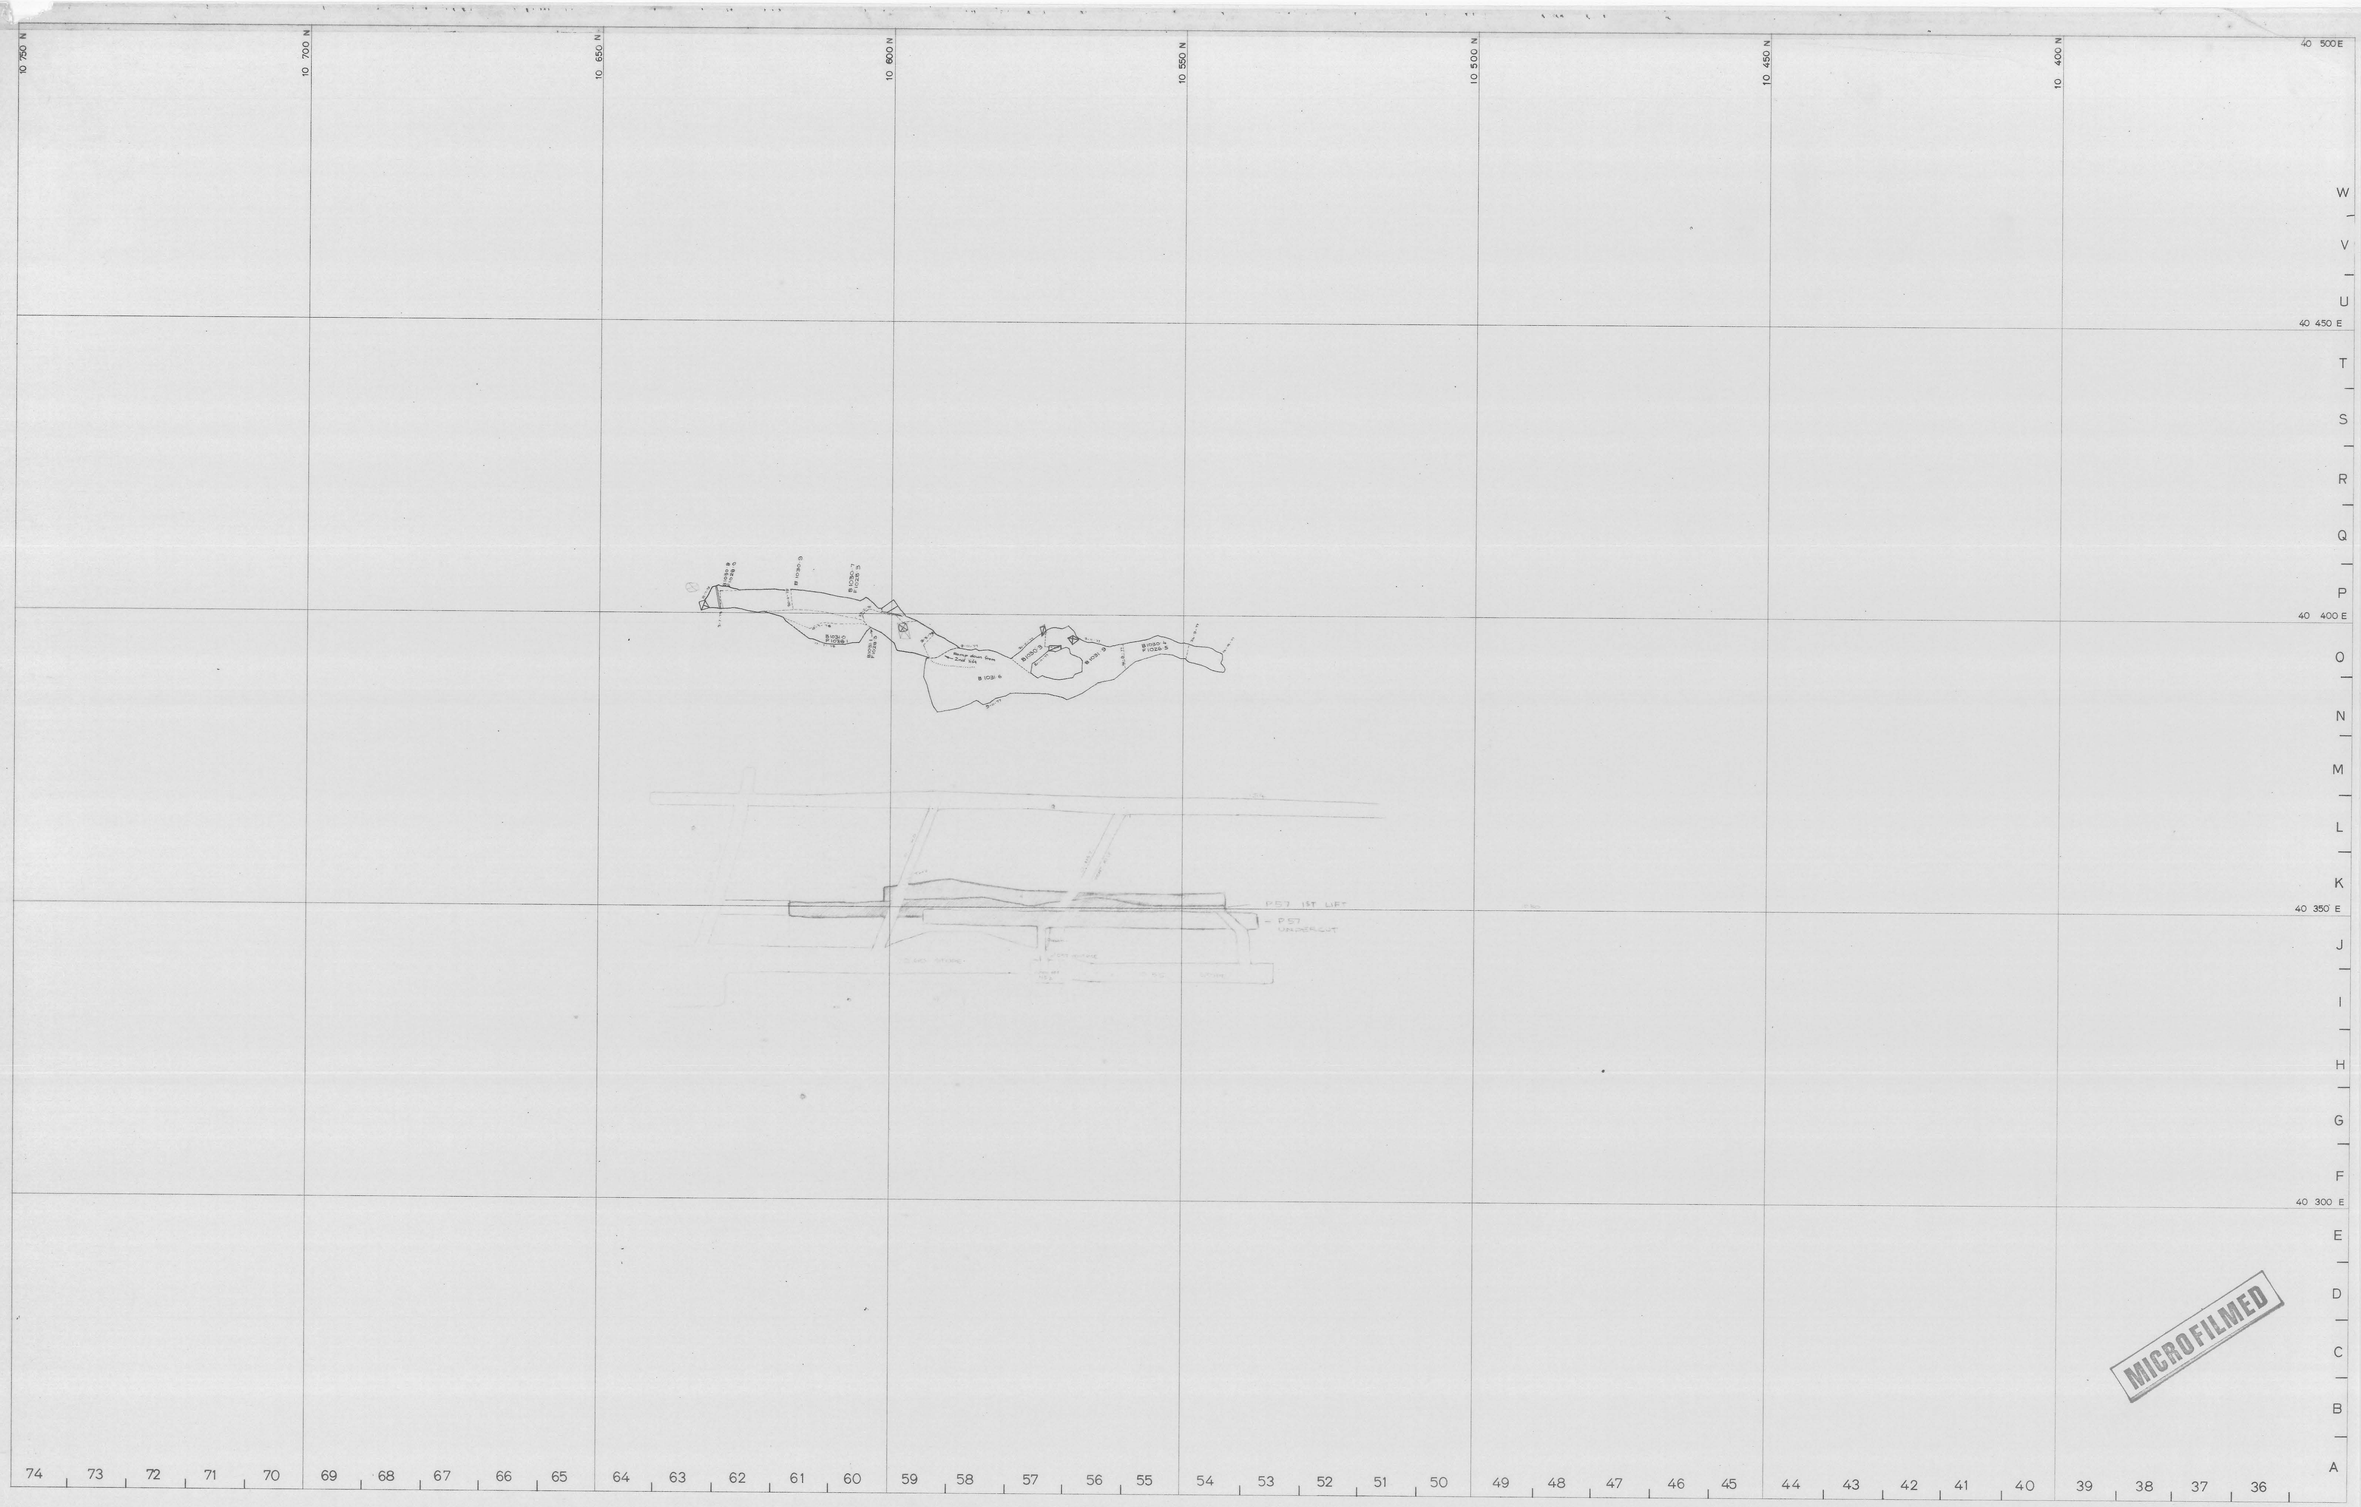

MICROFILMED

0374_834

0374_834

SCALE 1:500

5 cm

north

LOCATION
BOLD HEAD MINE

SUBJECT
P 57 STOPE
[1st Lift]

KING ISLAND SCHEELITE
A DIVISION OF WARMAN INTERNATIONAL
GRASSY KING ISLAND

PLAN NUMBER
04BH15-1041

79136