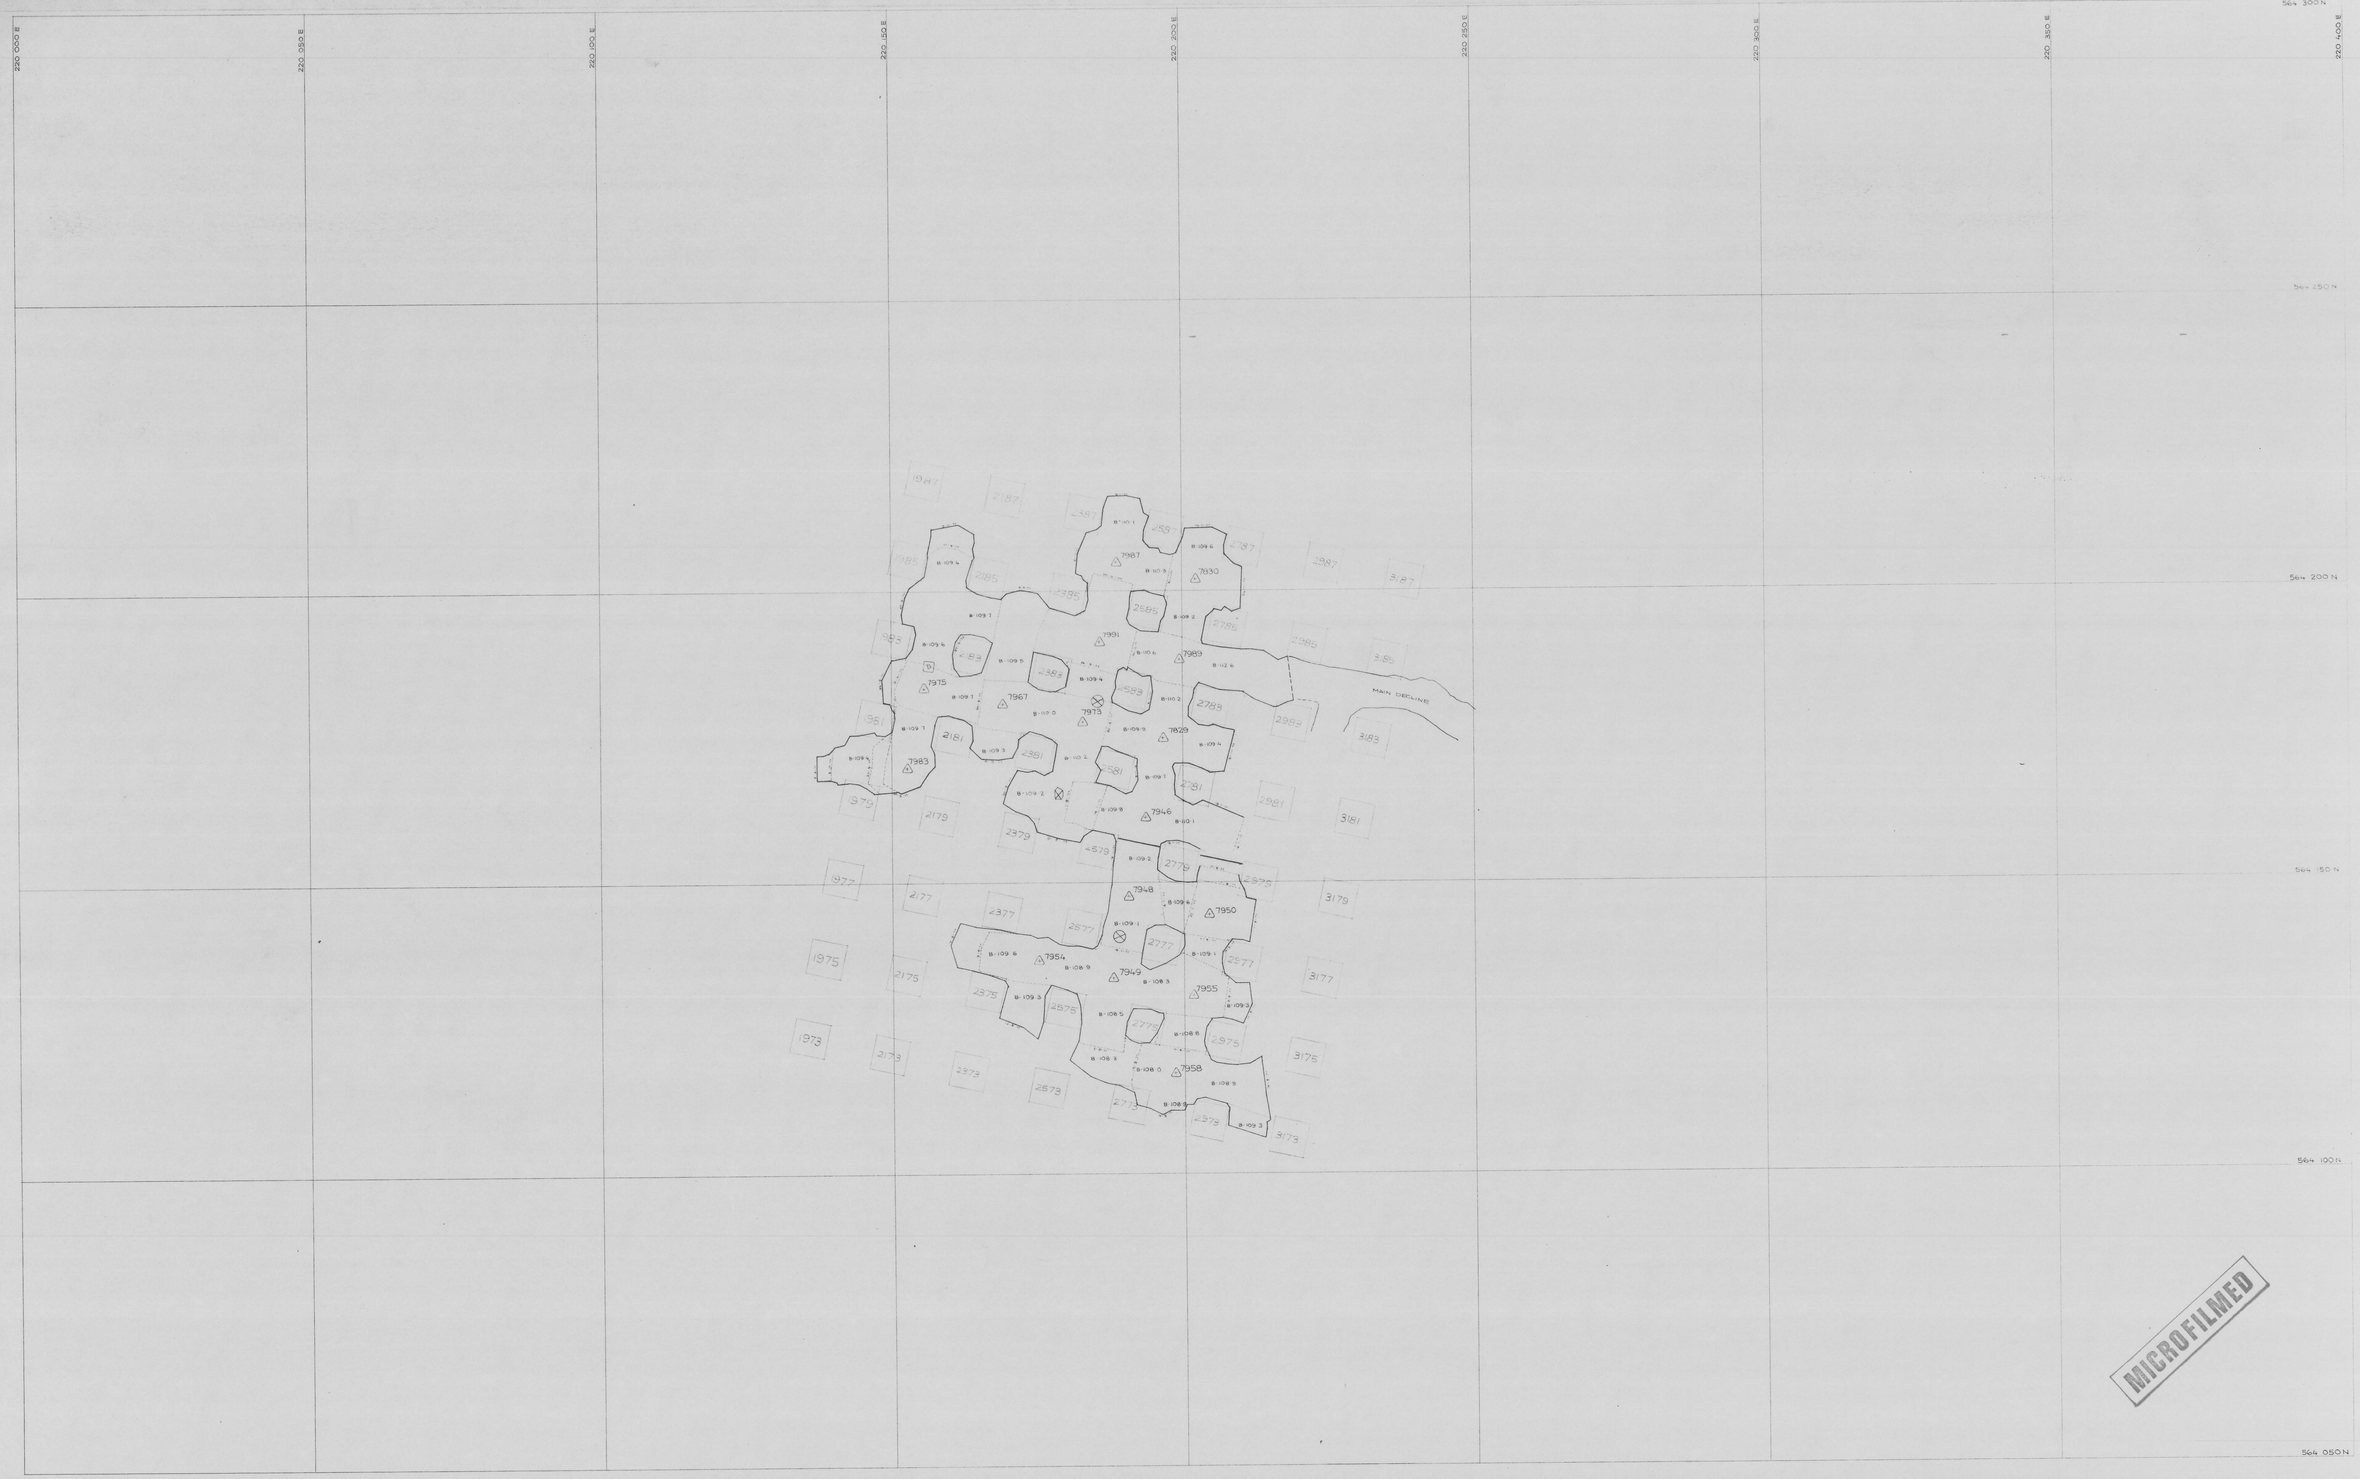

MICROFILMED

0374_859

0374_859	SCALE 1:500 5 cm	north	LOCATION: DOLPHIN MINE SUBJECT: C LENS WEDGE -113m CONTOUR

KING ISLAND SCHEELITE
A DIVISION OF WARMAN INTERNATIONAL
GRASSY KING ISLAND
PLAN NUMBER 04DM15 - 1018 78057

0374_859