


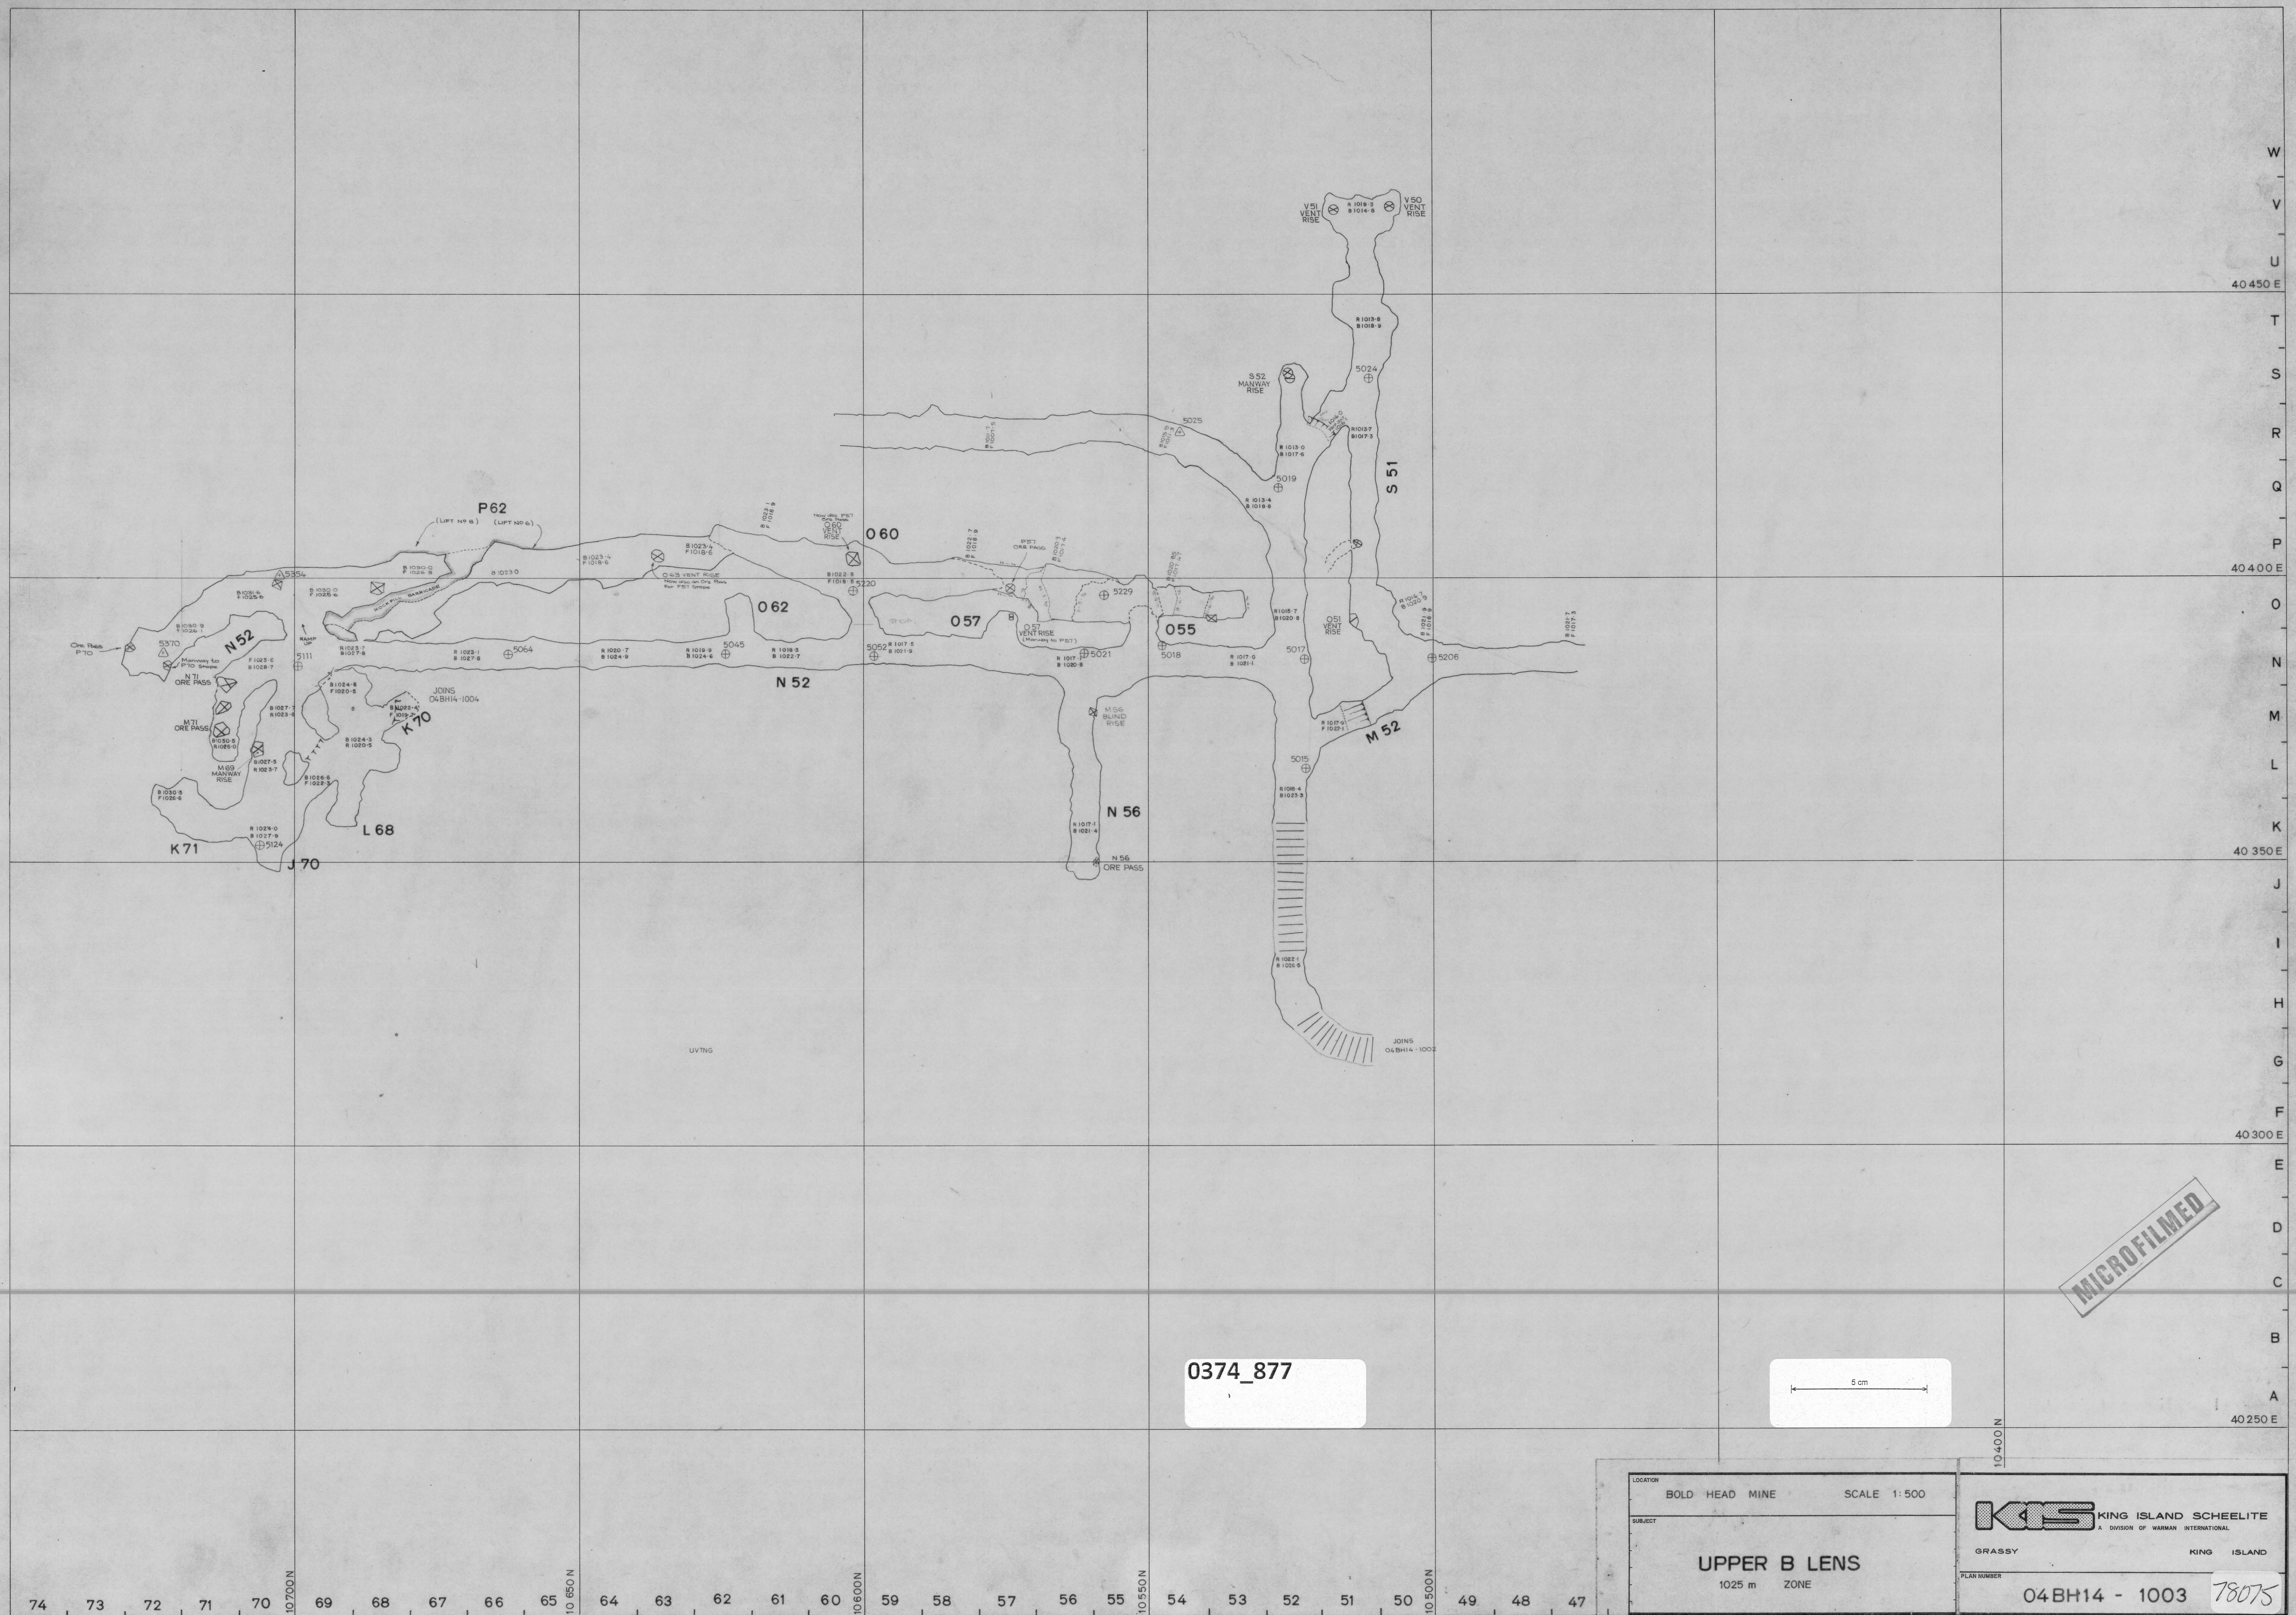

0374_877

5 cm

MICROFILMED

LOCATION	BOLD HEAD MINE	SCALE	1:500
SUBJECT	UPPER B LENS 1025 m ZONE		
PLAN NUMBER	04BH14 - 1003 78075		

KIS KING ISLAND SCHEELITE
A DIVISION OF WARMAN INTERNATIONAL
GRASSY KING ISLAND