


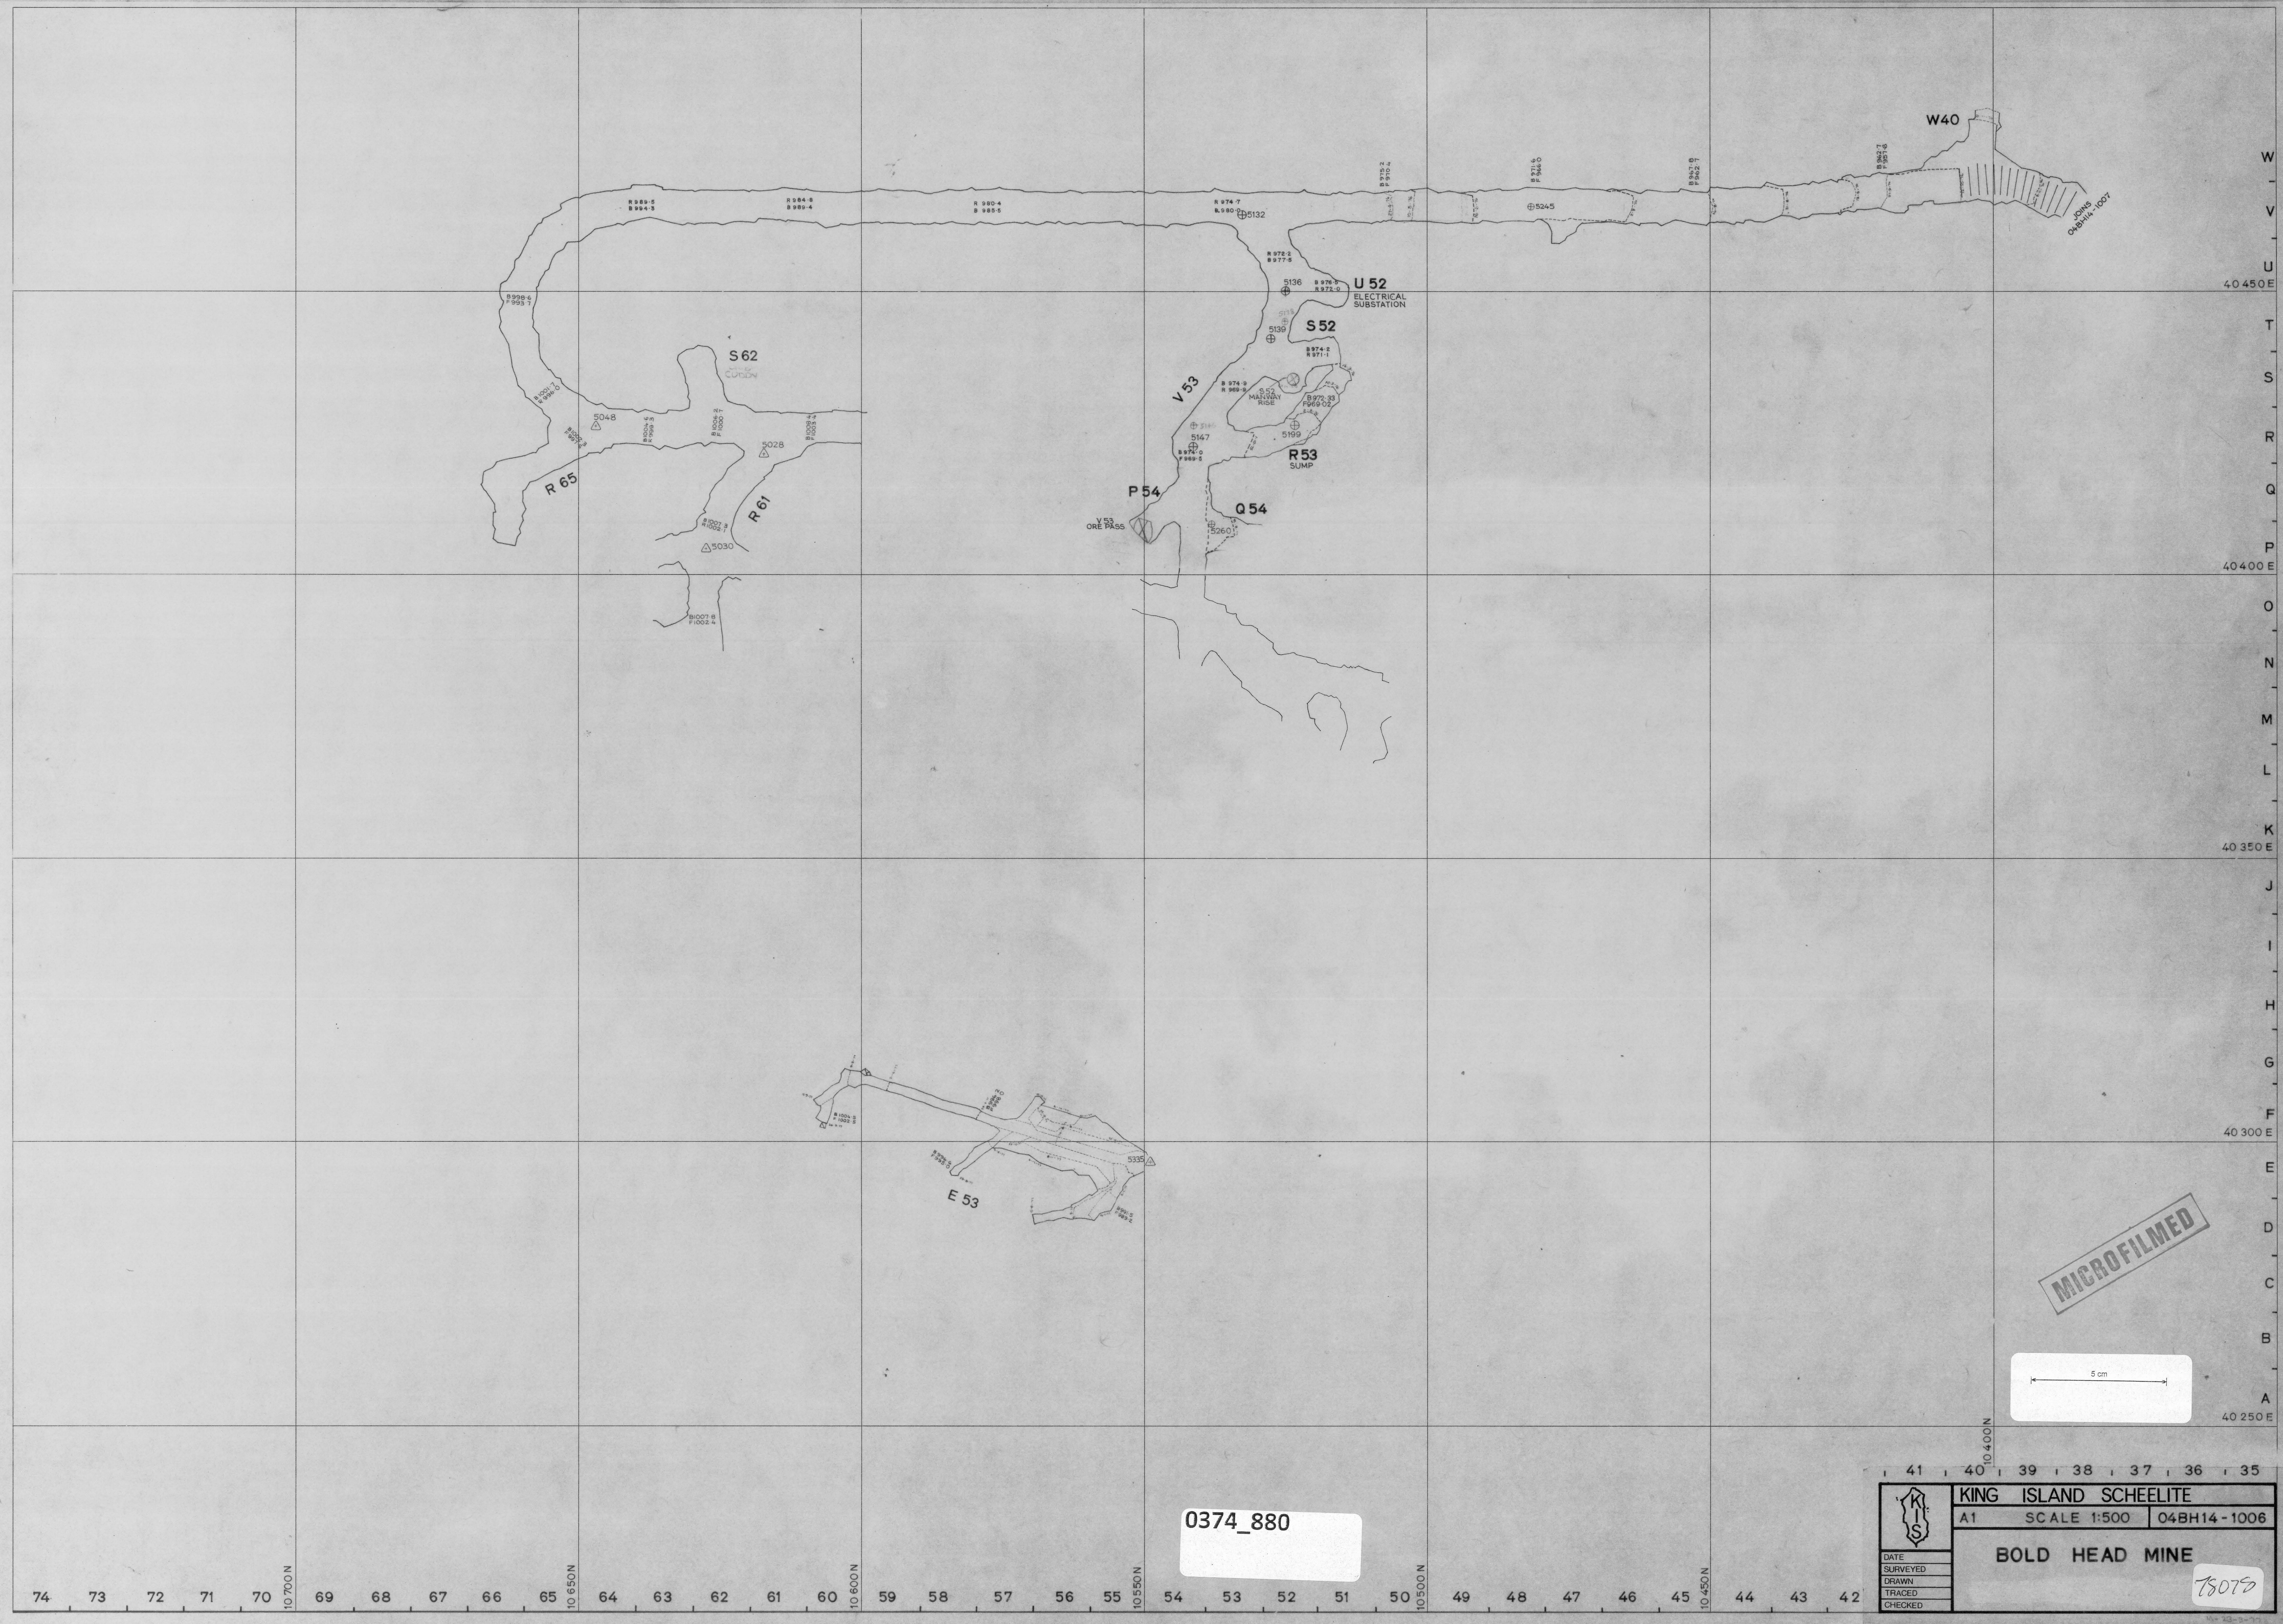

0374_880

	KING ISLAND SCHEELITE	
	A1	SCALE 1:500
	04BH14-1006	
	BOLD HEAD MINE	
	78072	

0374_880