

10 1000 N

10 650 N

10 600 N

10 550 N

10 500 N

10 450 N

10 400 N

40 450 E

40 400 E


40 350 E

40 300 E

40 250 E

04BH14-1002
ADJOINS


N 56
ORE PASS

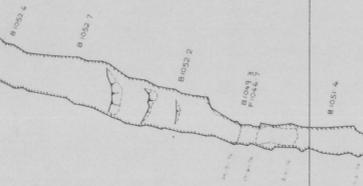

MICROFILMED

0374_888

SCALE 1:500

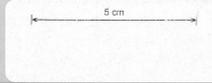

north

LOCATION

BOLD HEAD MINE

SUBJECT

A LENS
H 50 STOPE, 1052m CONTOUR

KIS KING ISLAND SCHEELITE
A DIVISION OF WARMAN INTERNATIONAL

GRASSY KING ISLAND

PLAN NUMBER

04 BH 15 - 1001

750086

0374_888