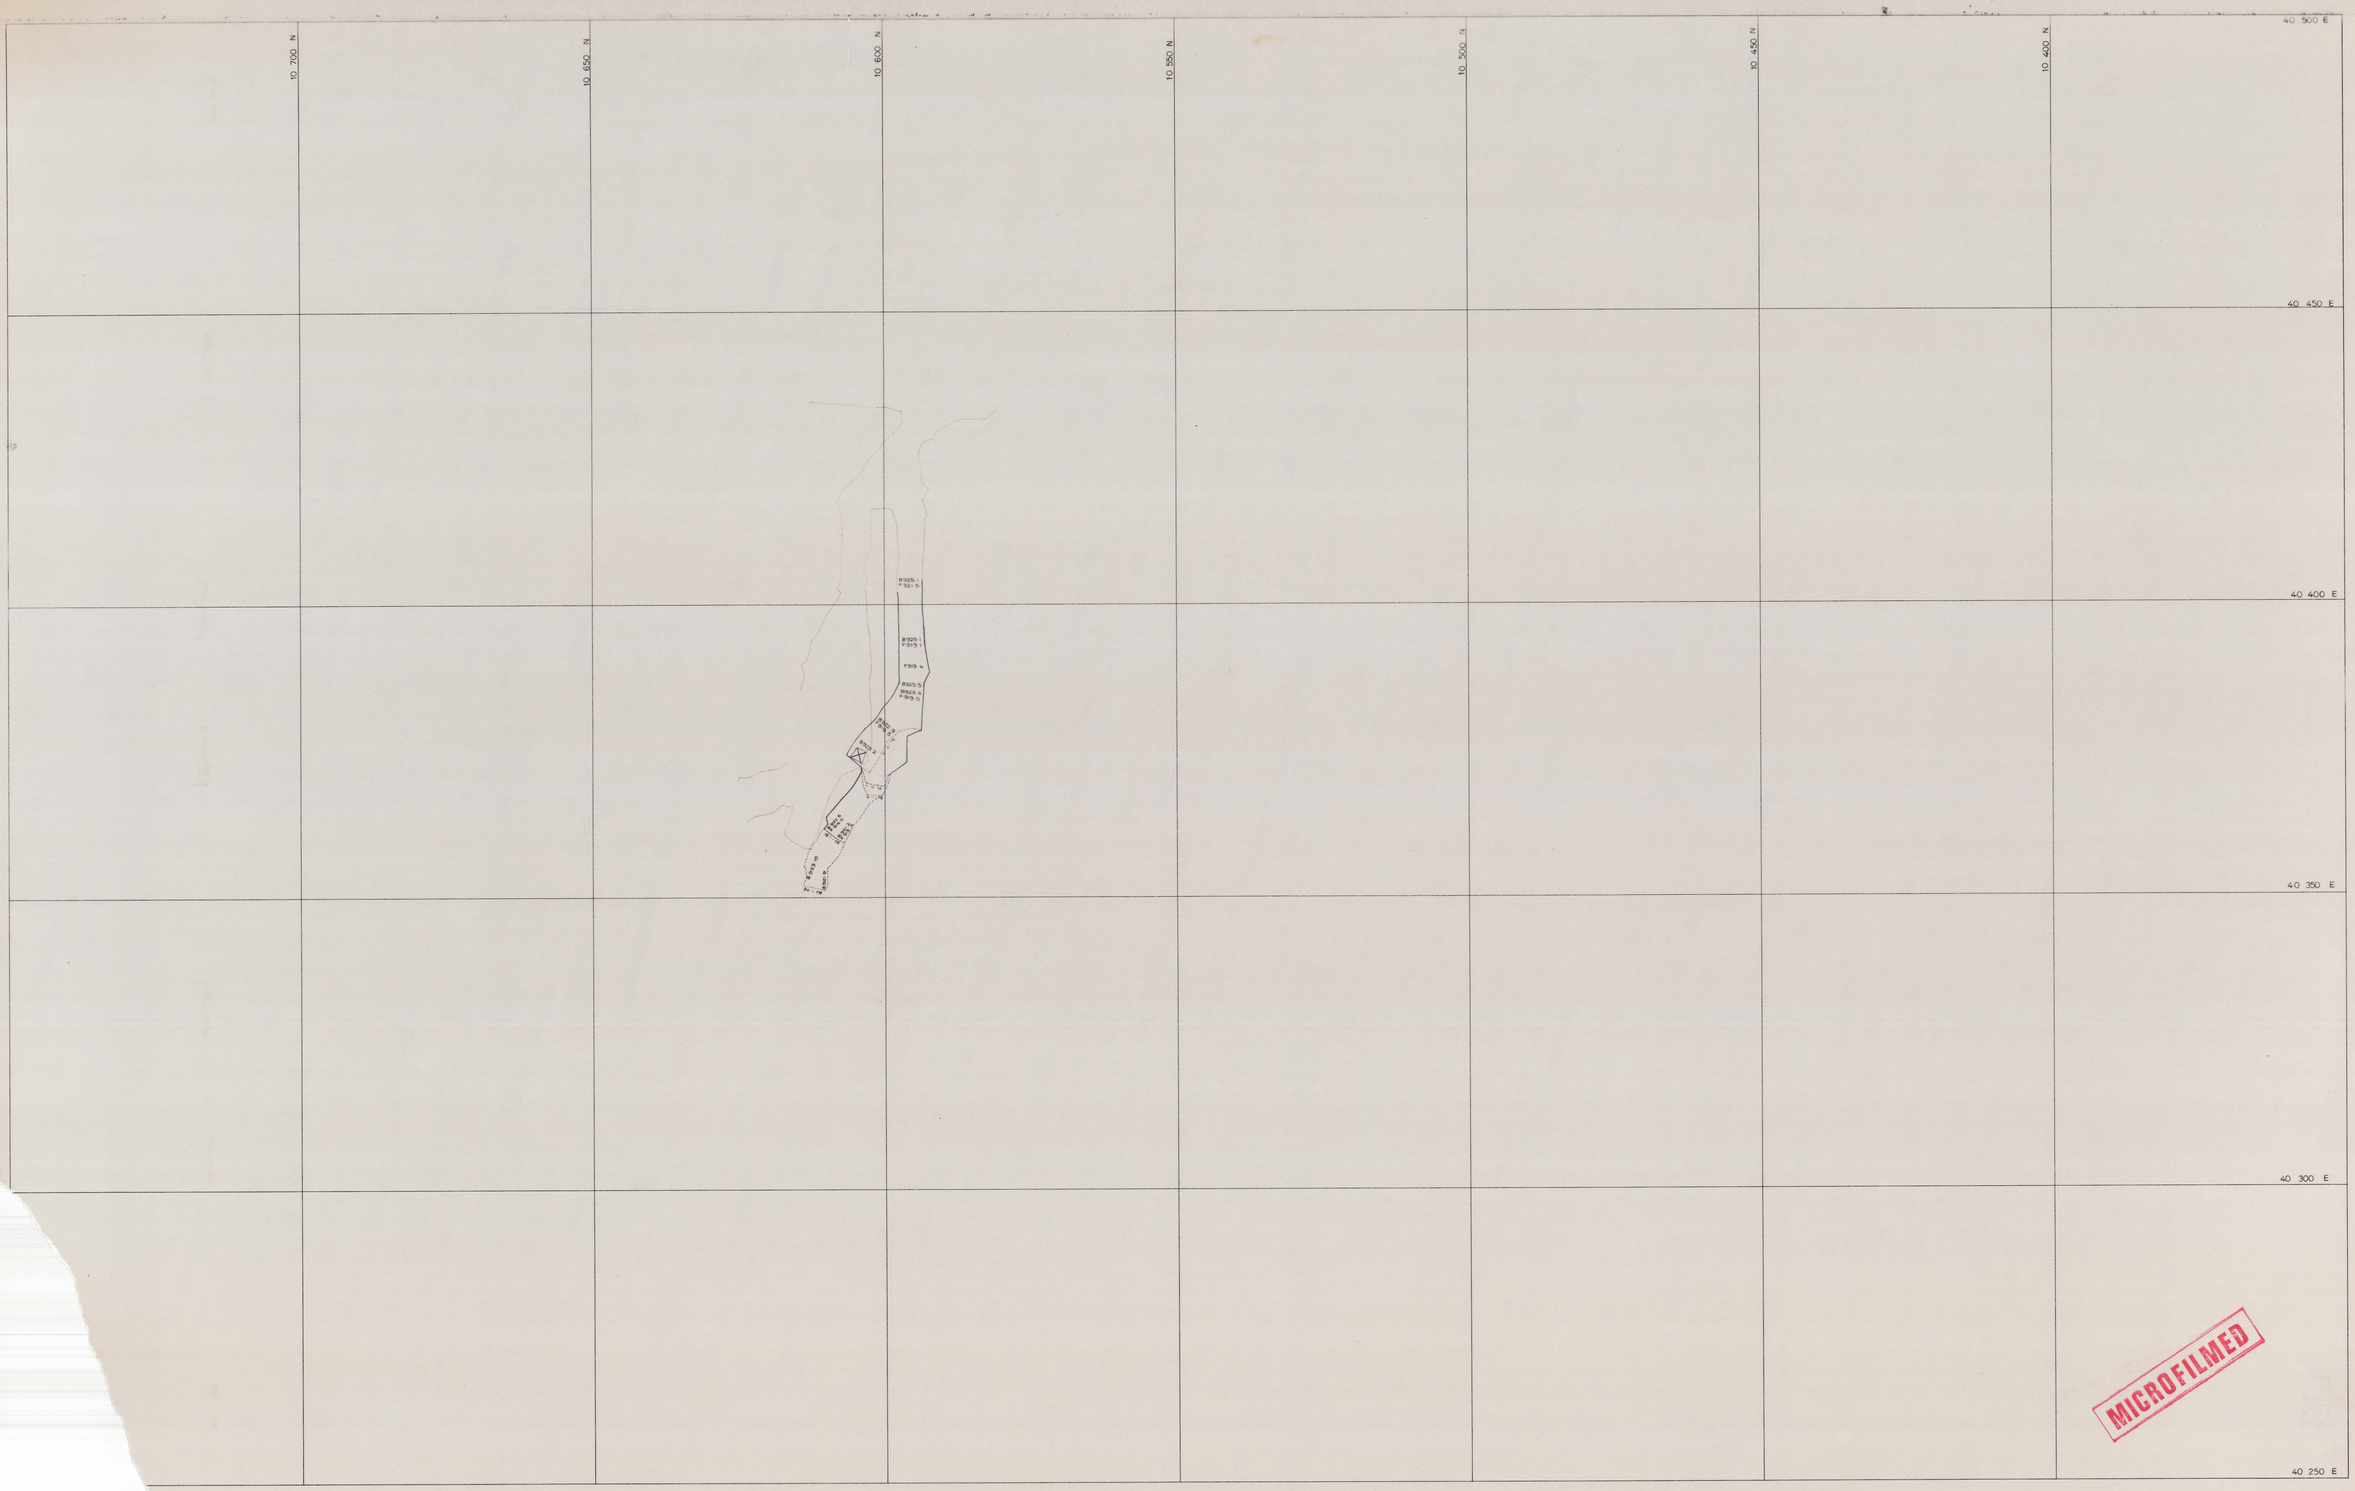

MICROFILMED

0374_922

SCALE 1: 500

5 cm

north

LOCATION

BOLD HEAD MINE

SUBJECT

C_2 LENS OREBODY

R59 BENCHING

KING ISLAND SCHEELITE
A DIVISION OF WARMAN INTERNATIONAL

GRASSY KING ISLAND

PLAN NUMBER

04BH15 - 1065

78120

0374_922