3-15
-02

5 cm

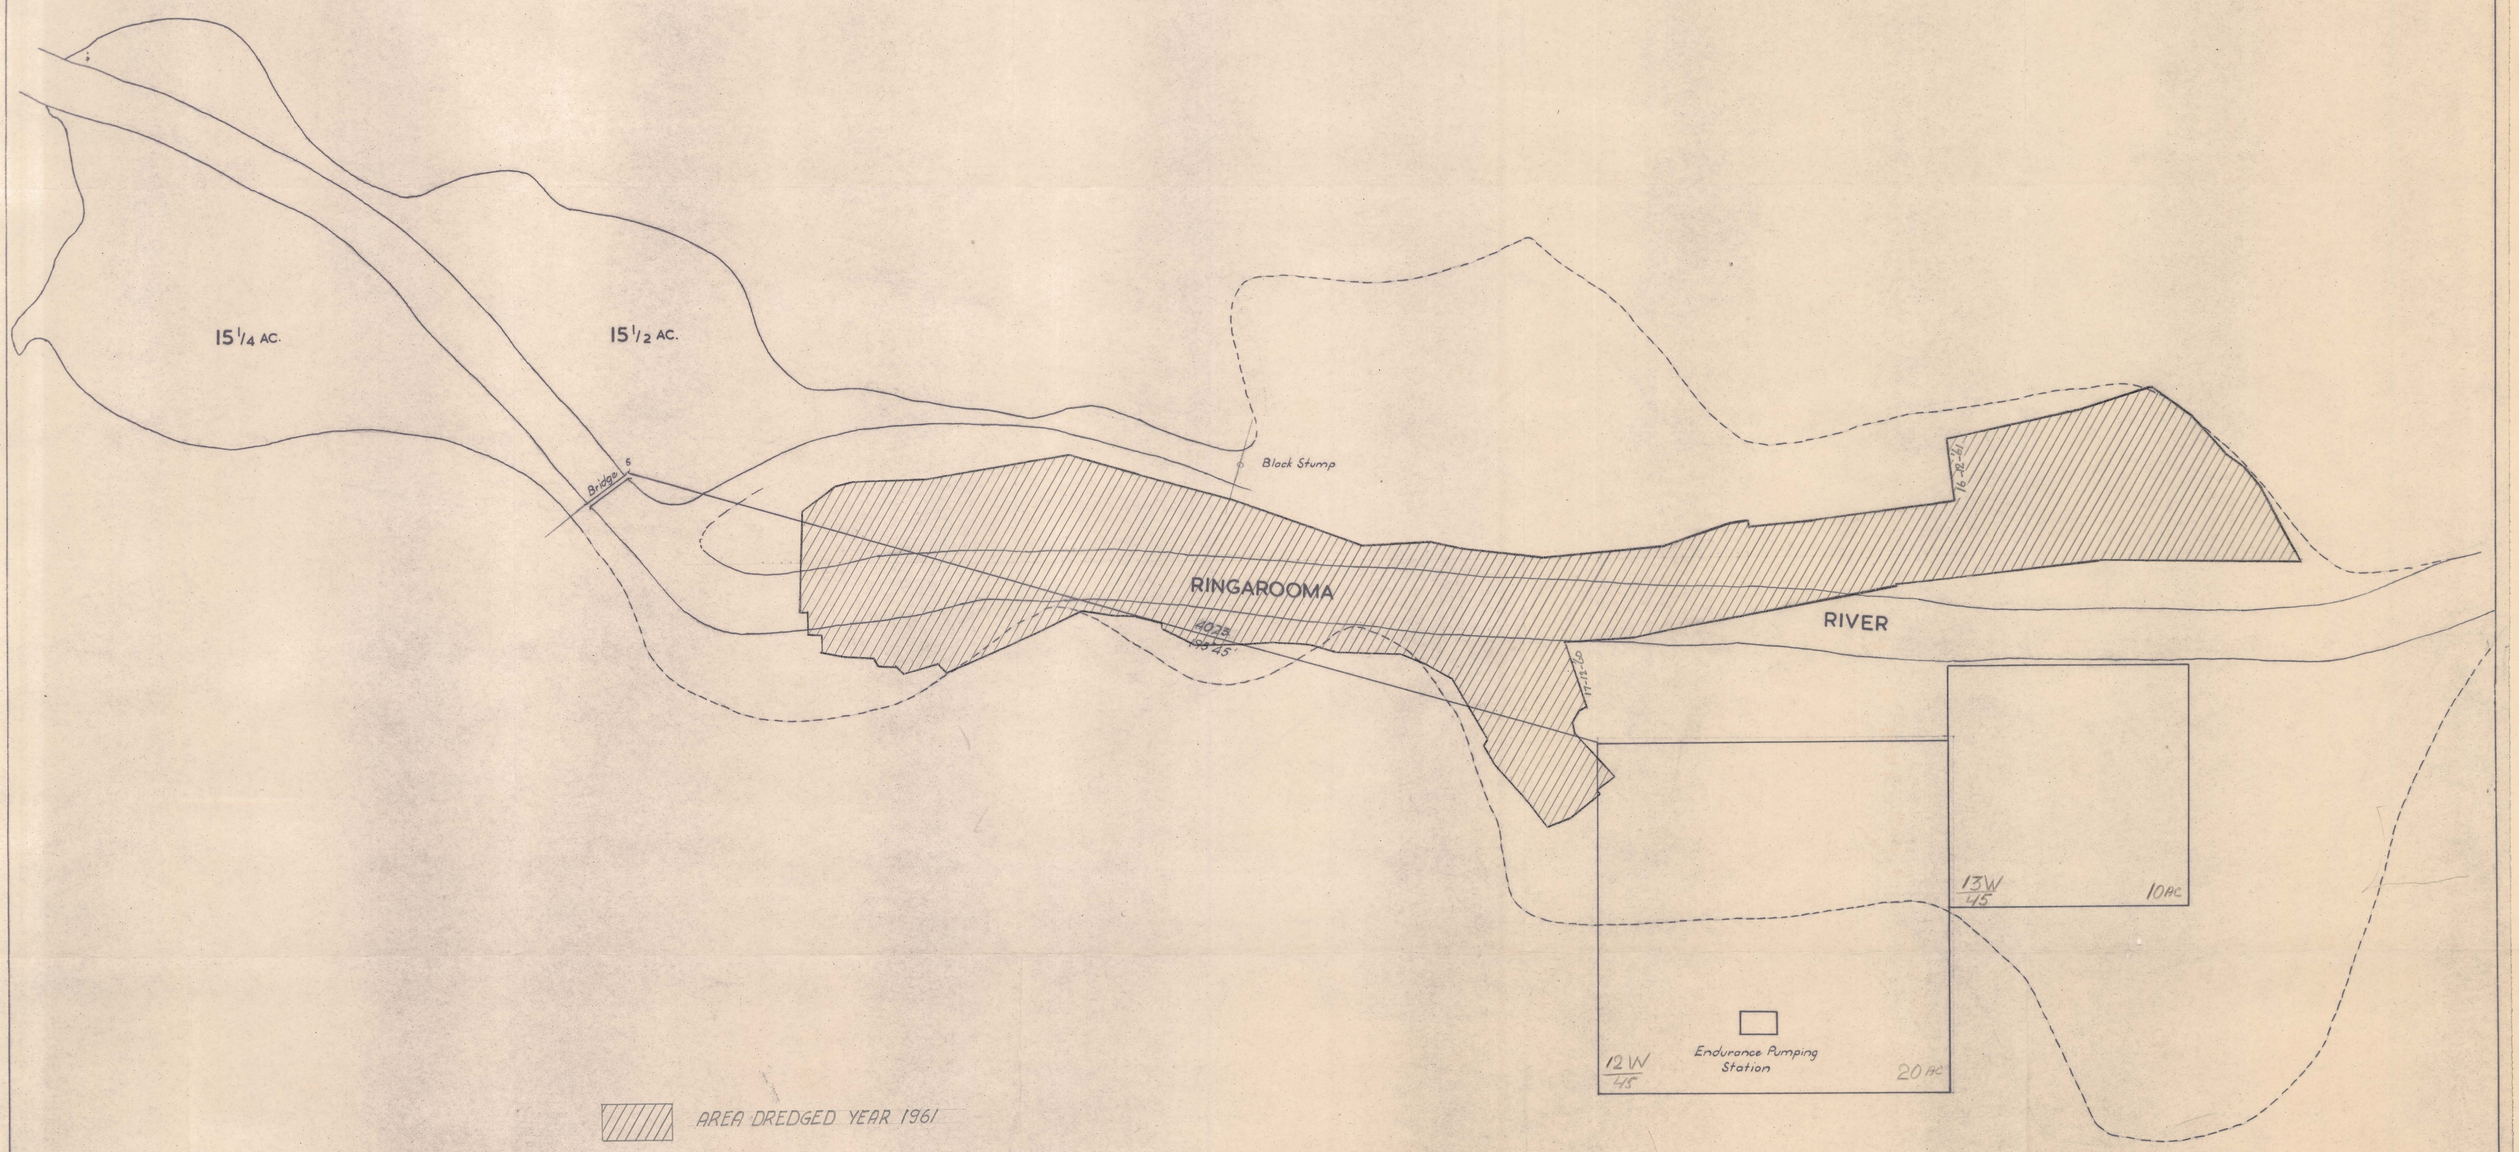


3-15
-02

Storeys Creek Tin Mining Co. N.L.
DORSET TIN DIVISION

| | | |
|---|---|---|
| PAUL A. PHELPS<br>1 YORK ST | AUTHORISED SURVEYOR<br>LAUNCESTON | 11/62 |

DORSET EXTENDED
FOR DORSET TIN DIVISION

| SCALE | SHEET NO. | DATE | |
|---|---|---|---|
| 3 CHNS — 1" | 1 OF 1 | 15/6/62 | Paul A Phelps |

ys Creek Tin Mining Co. N.L.
DORSET TIN DIVISION