


0376-054

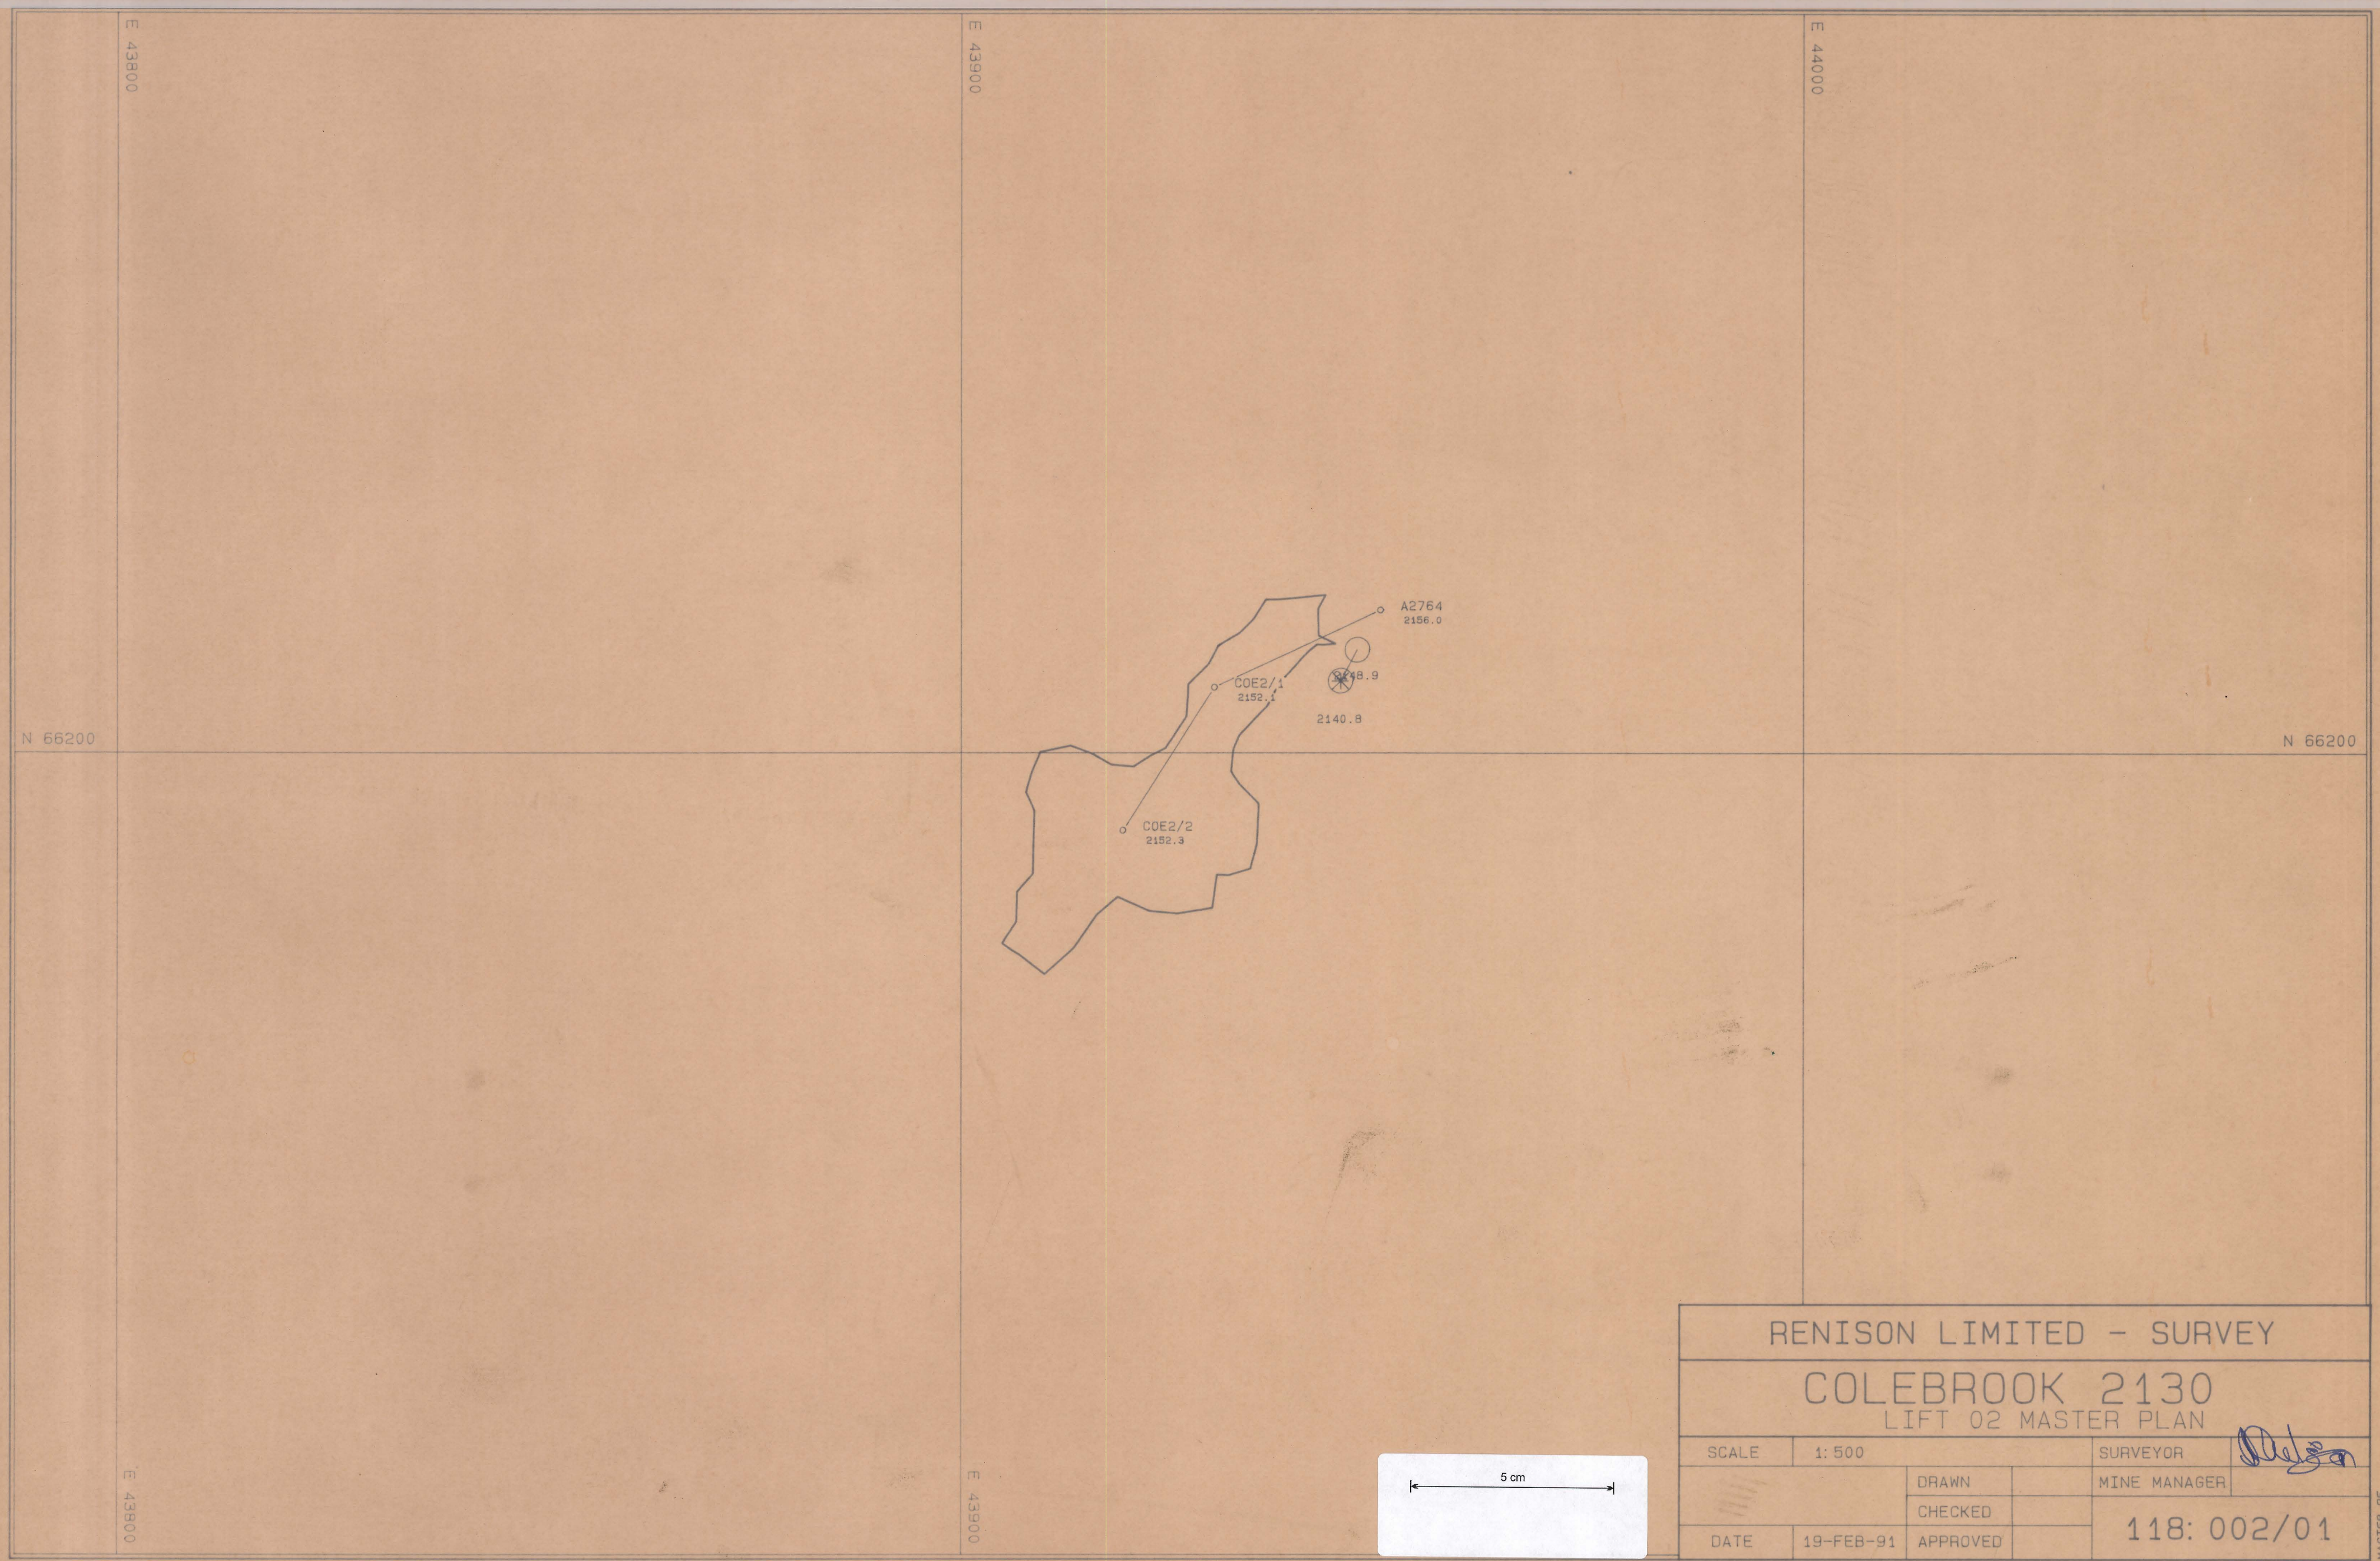

RENISON LIMITED - SURVEY			
COLEBROOK 2130			
LIFT 02 MASTER PLAN			
SCALE	1:500	SURVEYOR	<i>[Signature]</i>
		DRAWN	
		CHECKED	
DATE	19-FEB-91	APPROVED	
			118: 002/01