0376-071

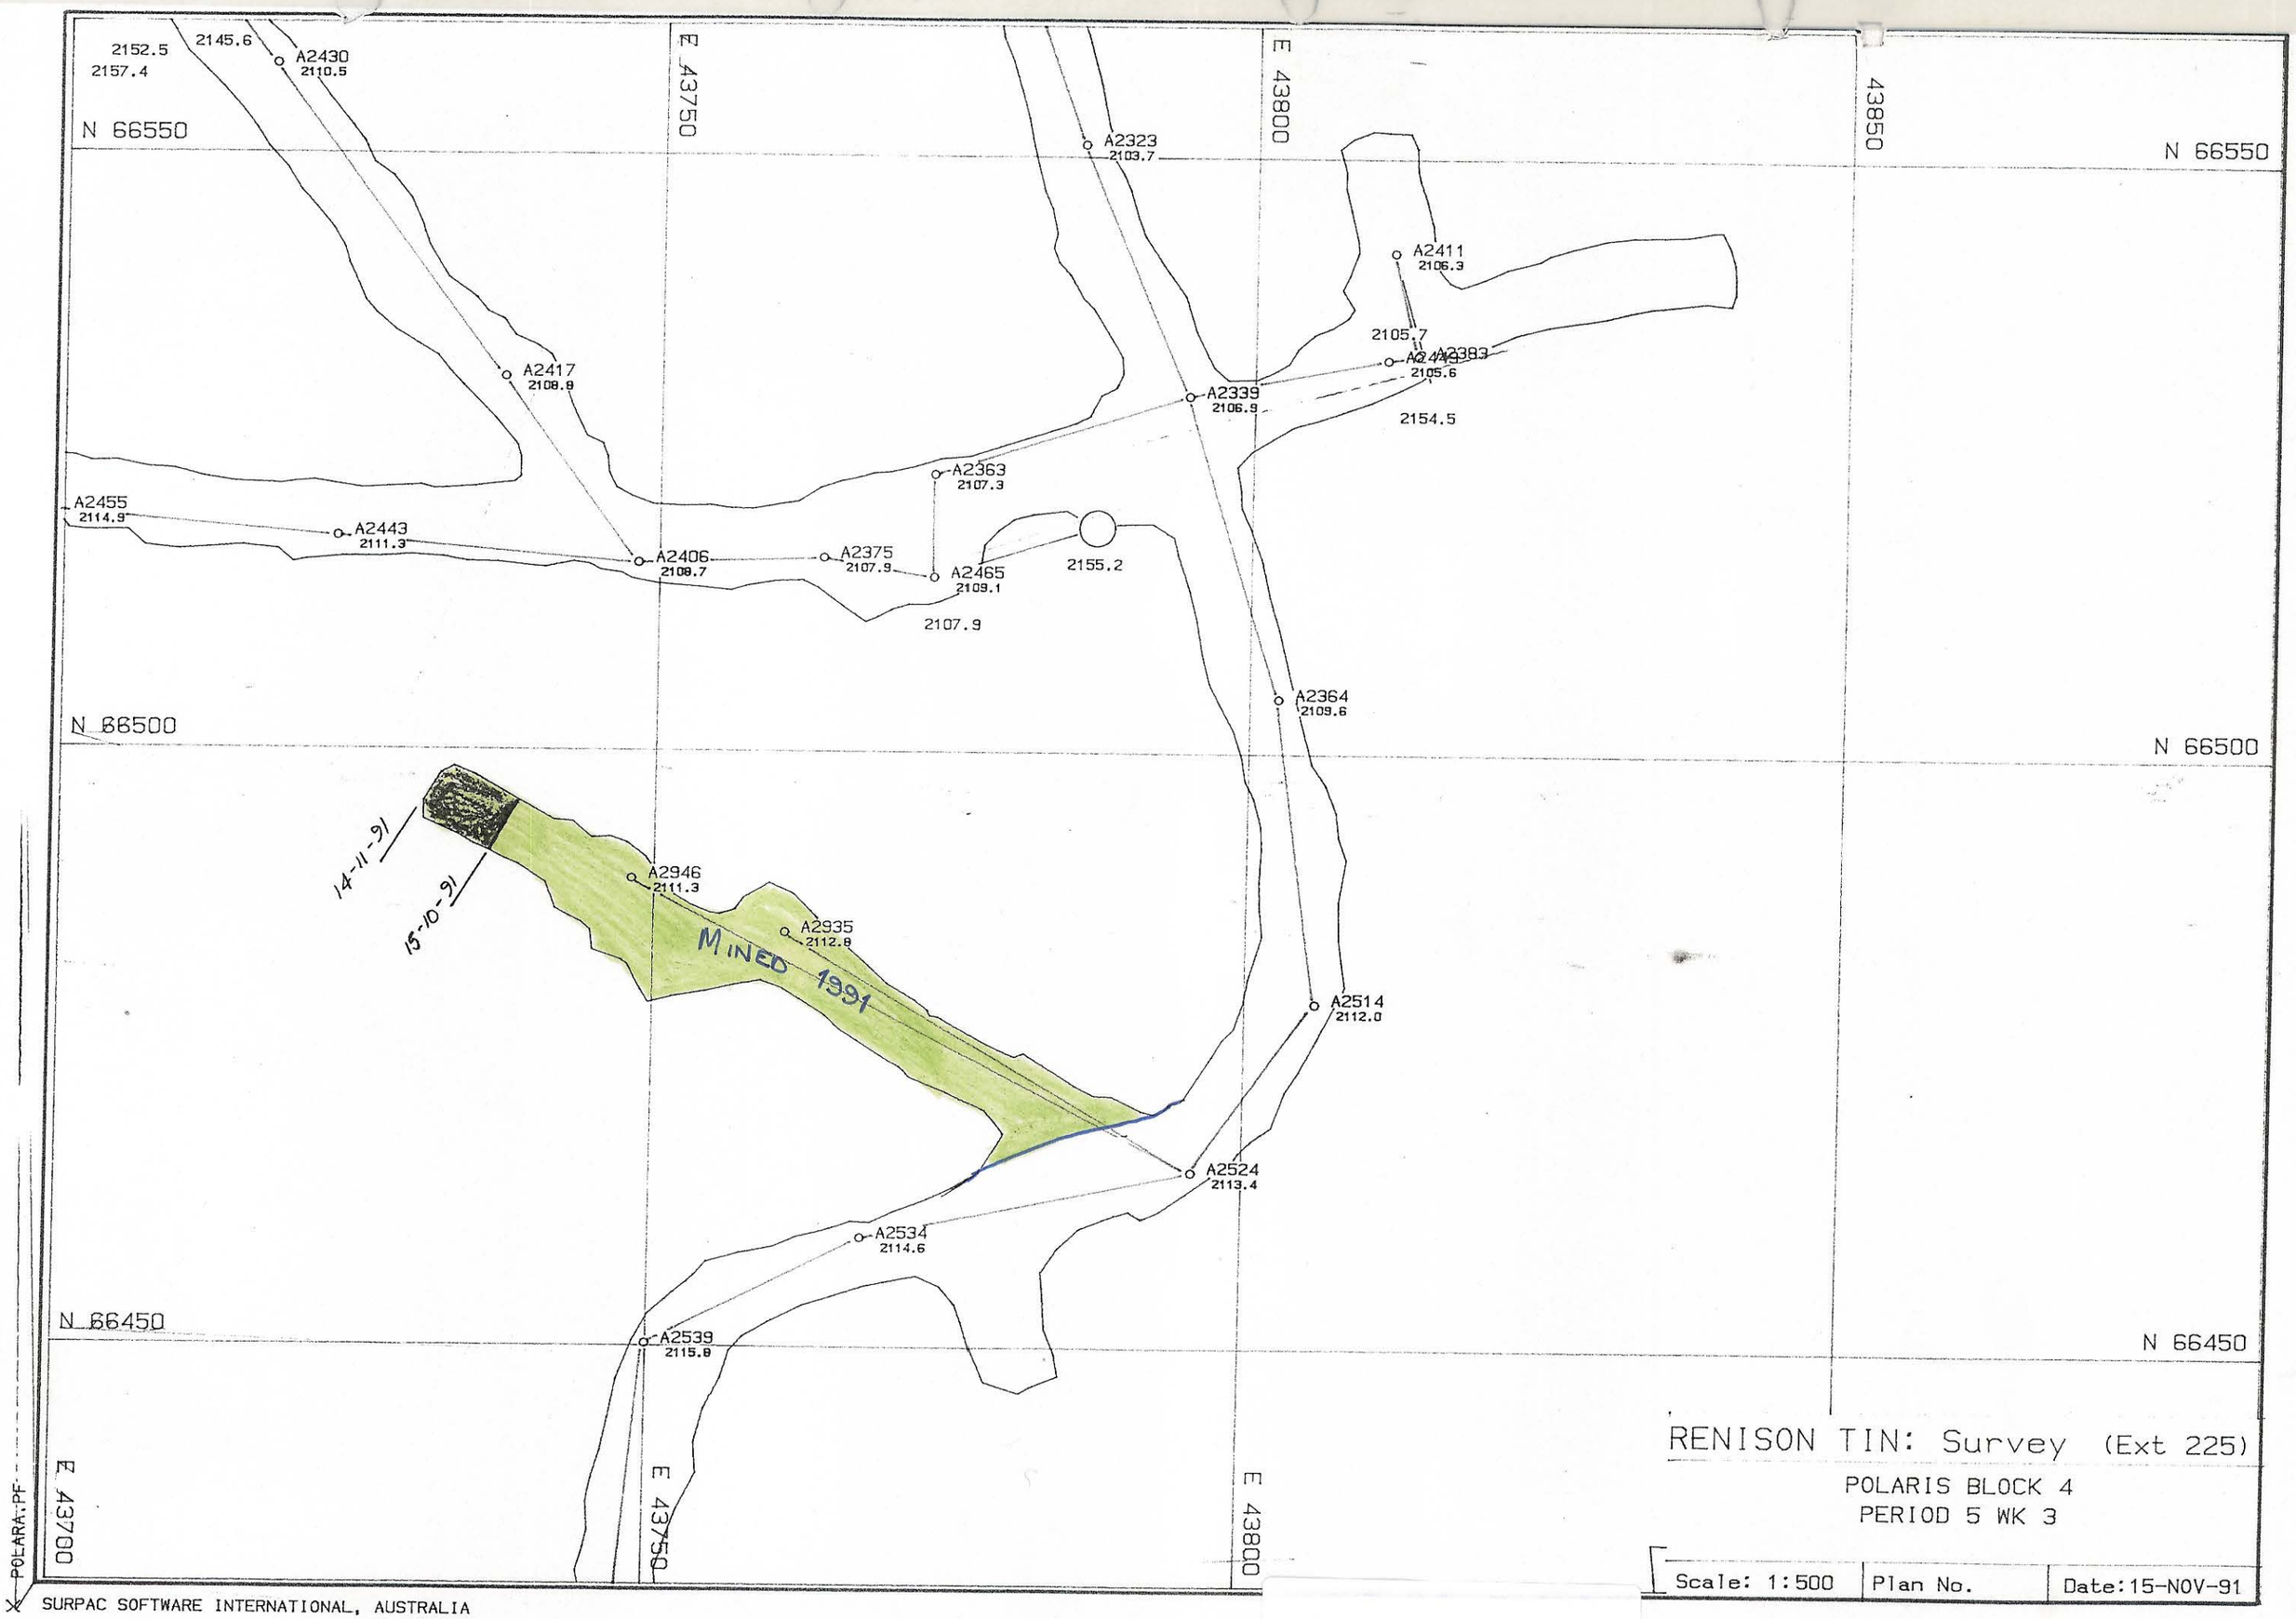
2152.5
2157.4
2145.6
A2430
2110.5
N 66550
E 43750
E 43800
43850
N 66550
A2323
2103.7
A2411
2106.3
2105.7
A2383
2105.6
A2417
2108.8
A2339
2106.9
2154.5
A2363
2107.3
A2455
2114.9
A2443
2111.3
A2406
2108.7
A2375
2107.9
A2465
2109.1
2155.2
2107.9
A2364
2109.6
N 66500
N 66500
14-11-91
15-10-91
A2946
2111.3
A2935
2112.8
MINED 1991
A2514
2112.0
A2524
2113.4
A2534
2114.6
N 66450
A2539
2115.8
N 66450
E 43700
E 43750
E 43800
POLARA.PF
SURPAC SOFTWARE INTERNATIONAL, AUSTRALIA
RENISON TIN: Survey (Ext 225)
POLARIS BLOCK 4
PERIOD 5 WK 3
Scale: 1:500
Plan No.
Date:15-NOV-91
5 cm