0376 - 092

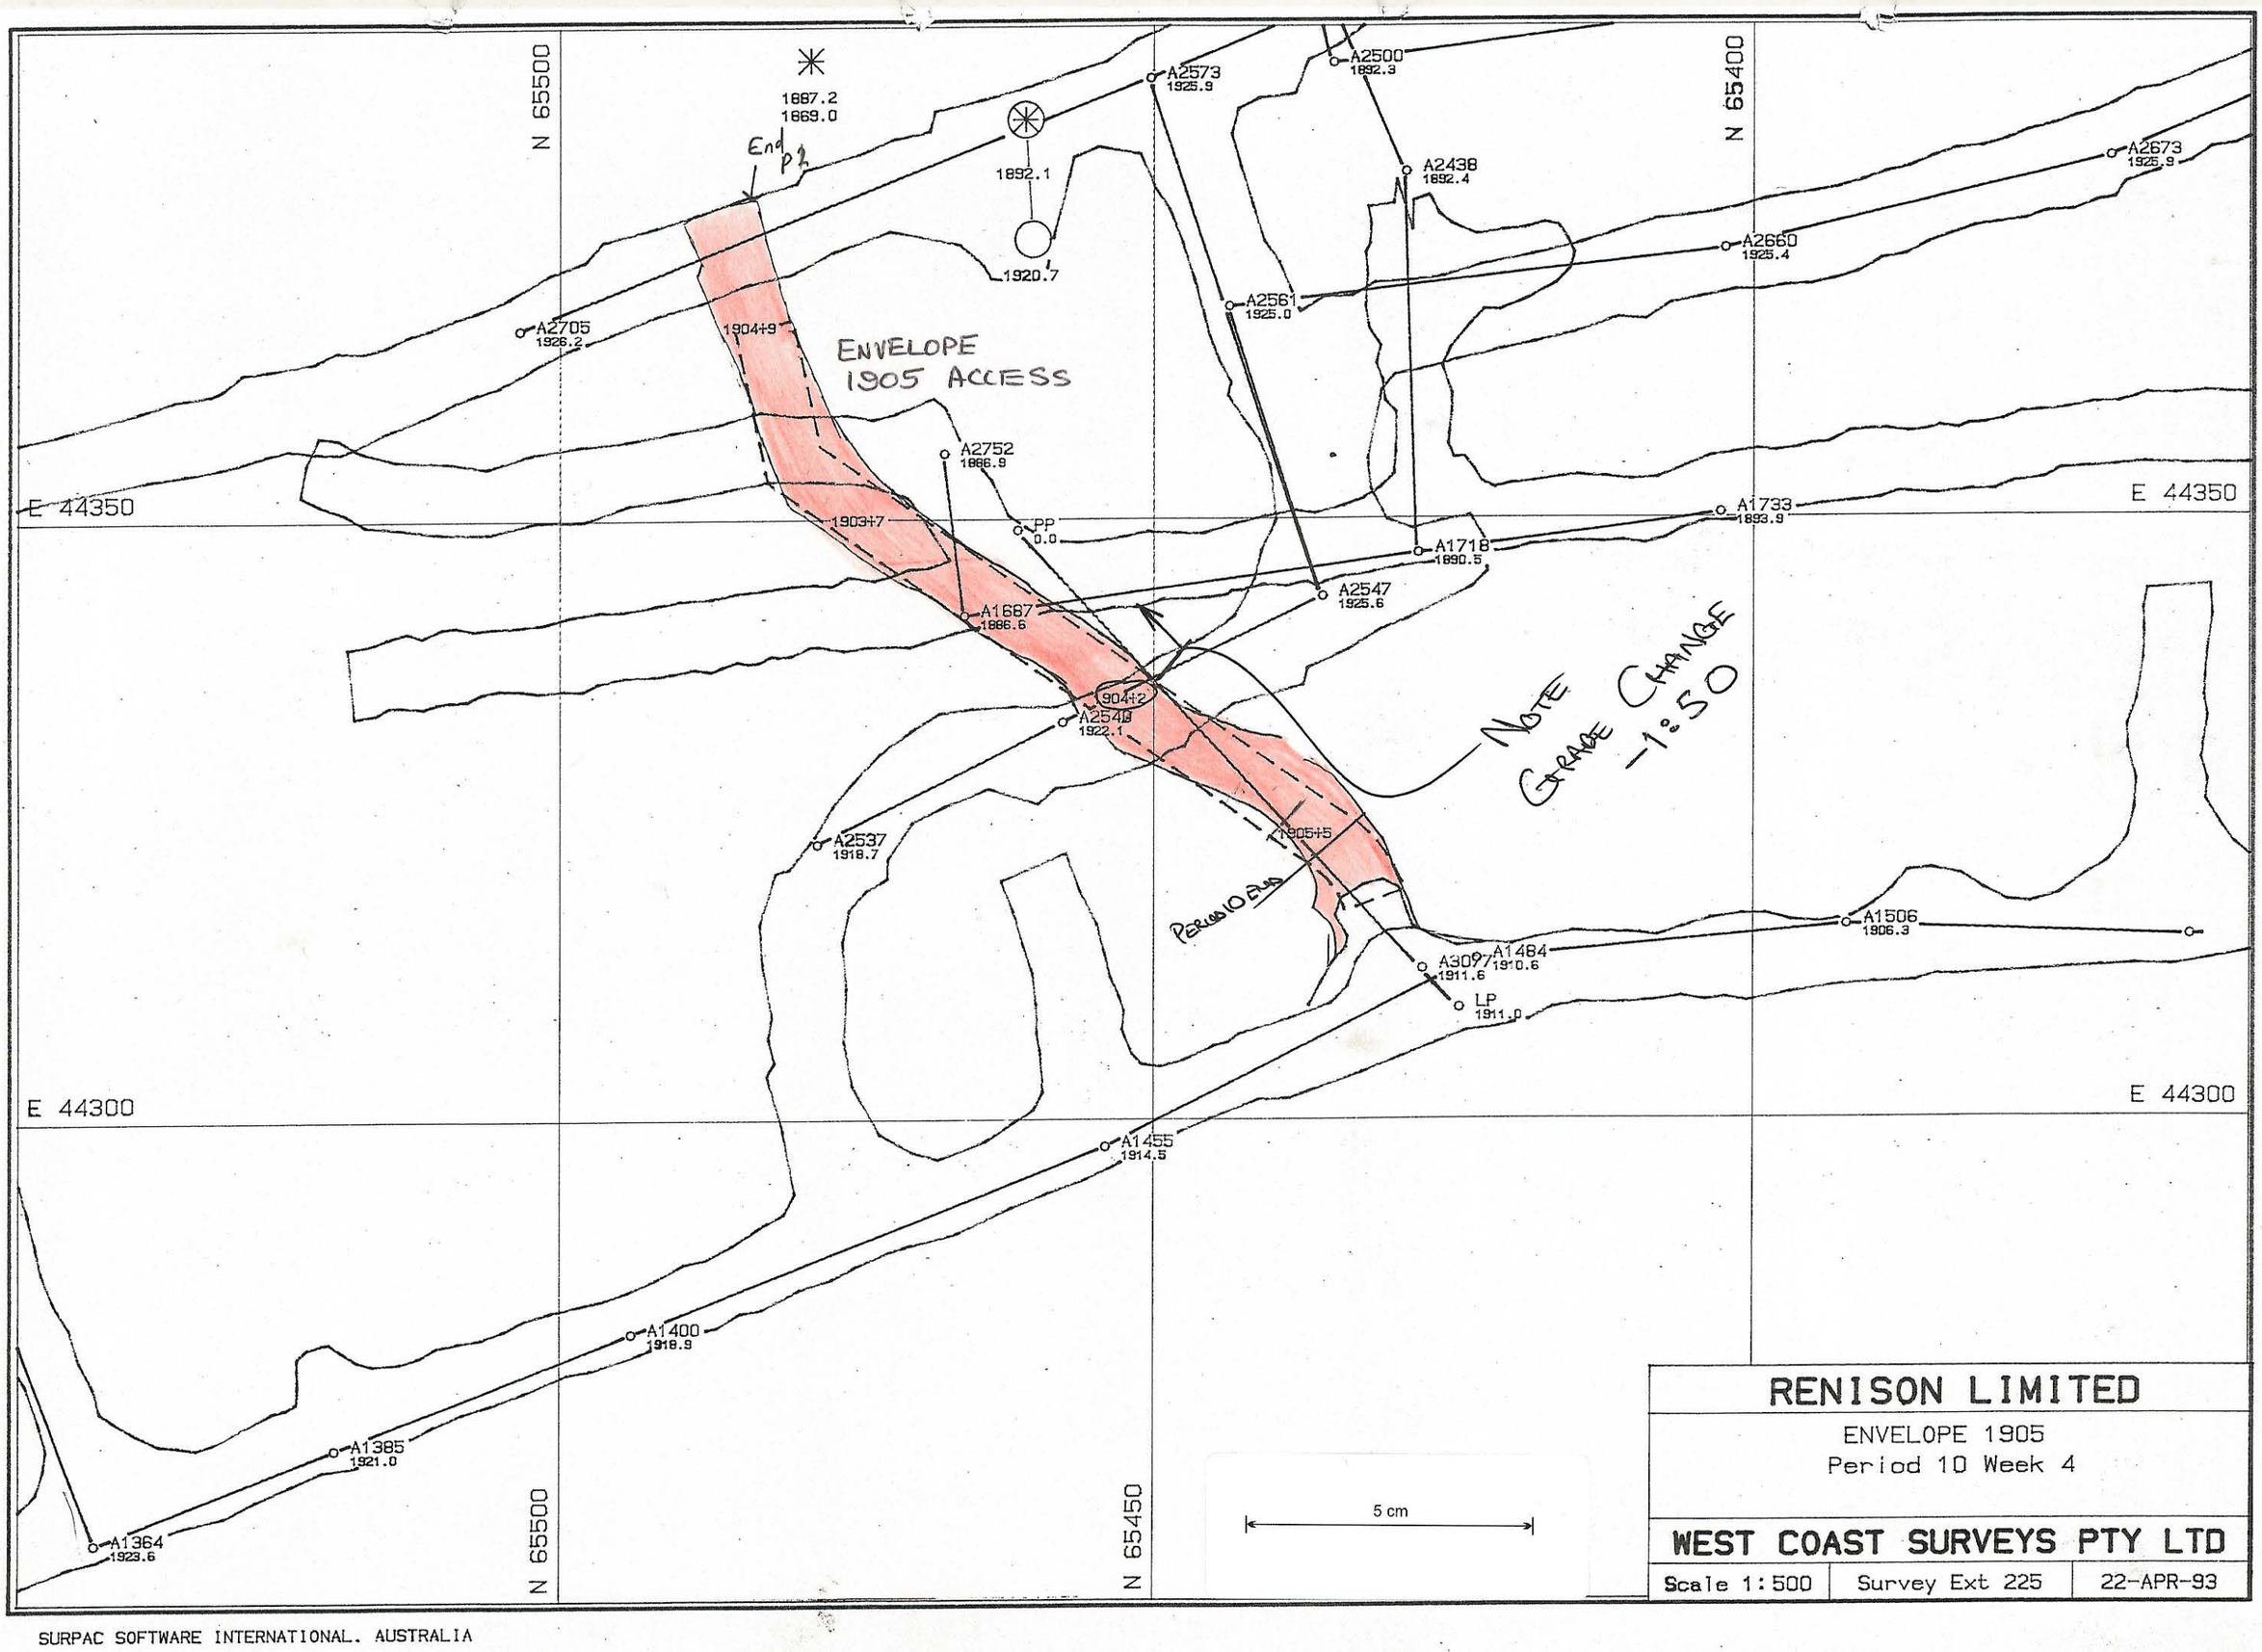

RENISON LIMITED

ENVELOPE 1905

Period 10 Week 4

WEST COAST SURVEYS PTY LTD

Scale 1:500	Survey Ext 225	22-APR-93

SURPAC SOFTWARE INTERNATIONAL. AUSTRALIA