FEQ : Federal 2190
(LOW BACKS HW SIDE)

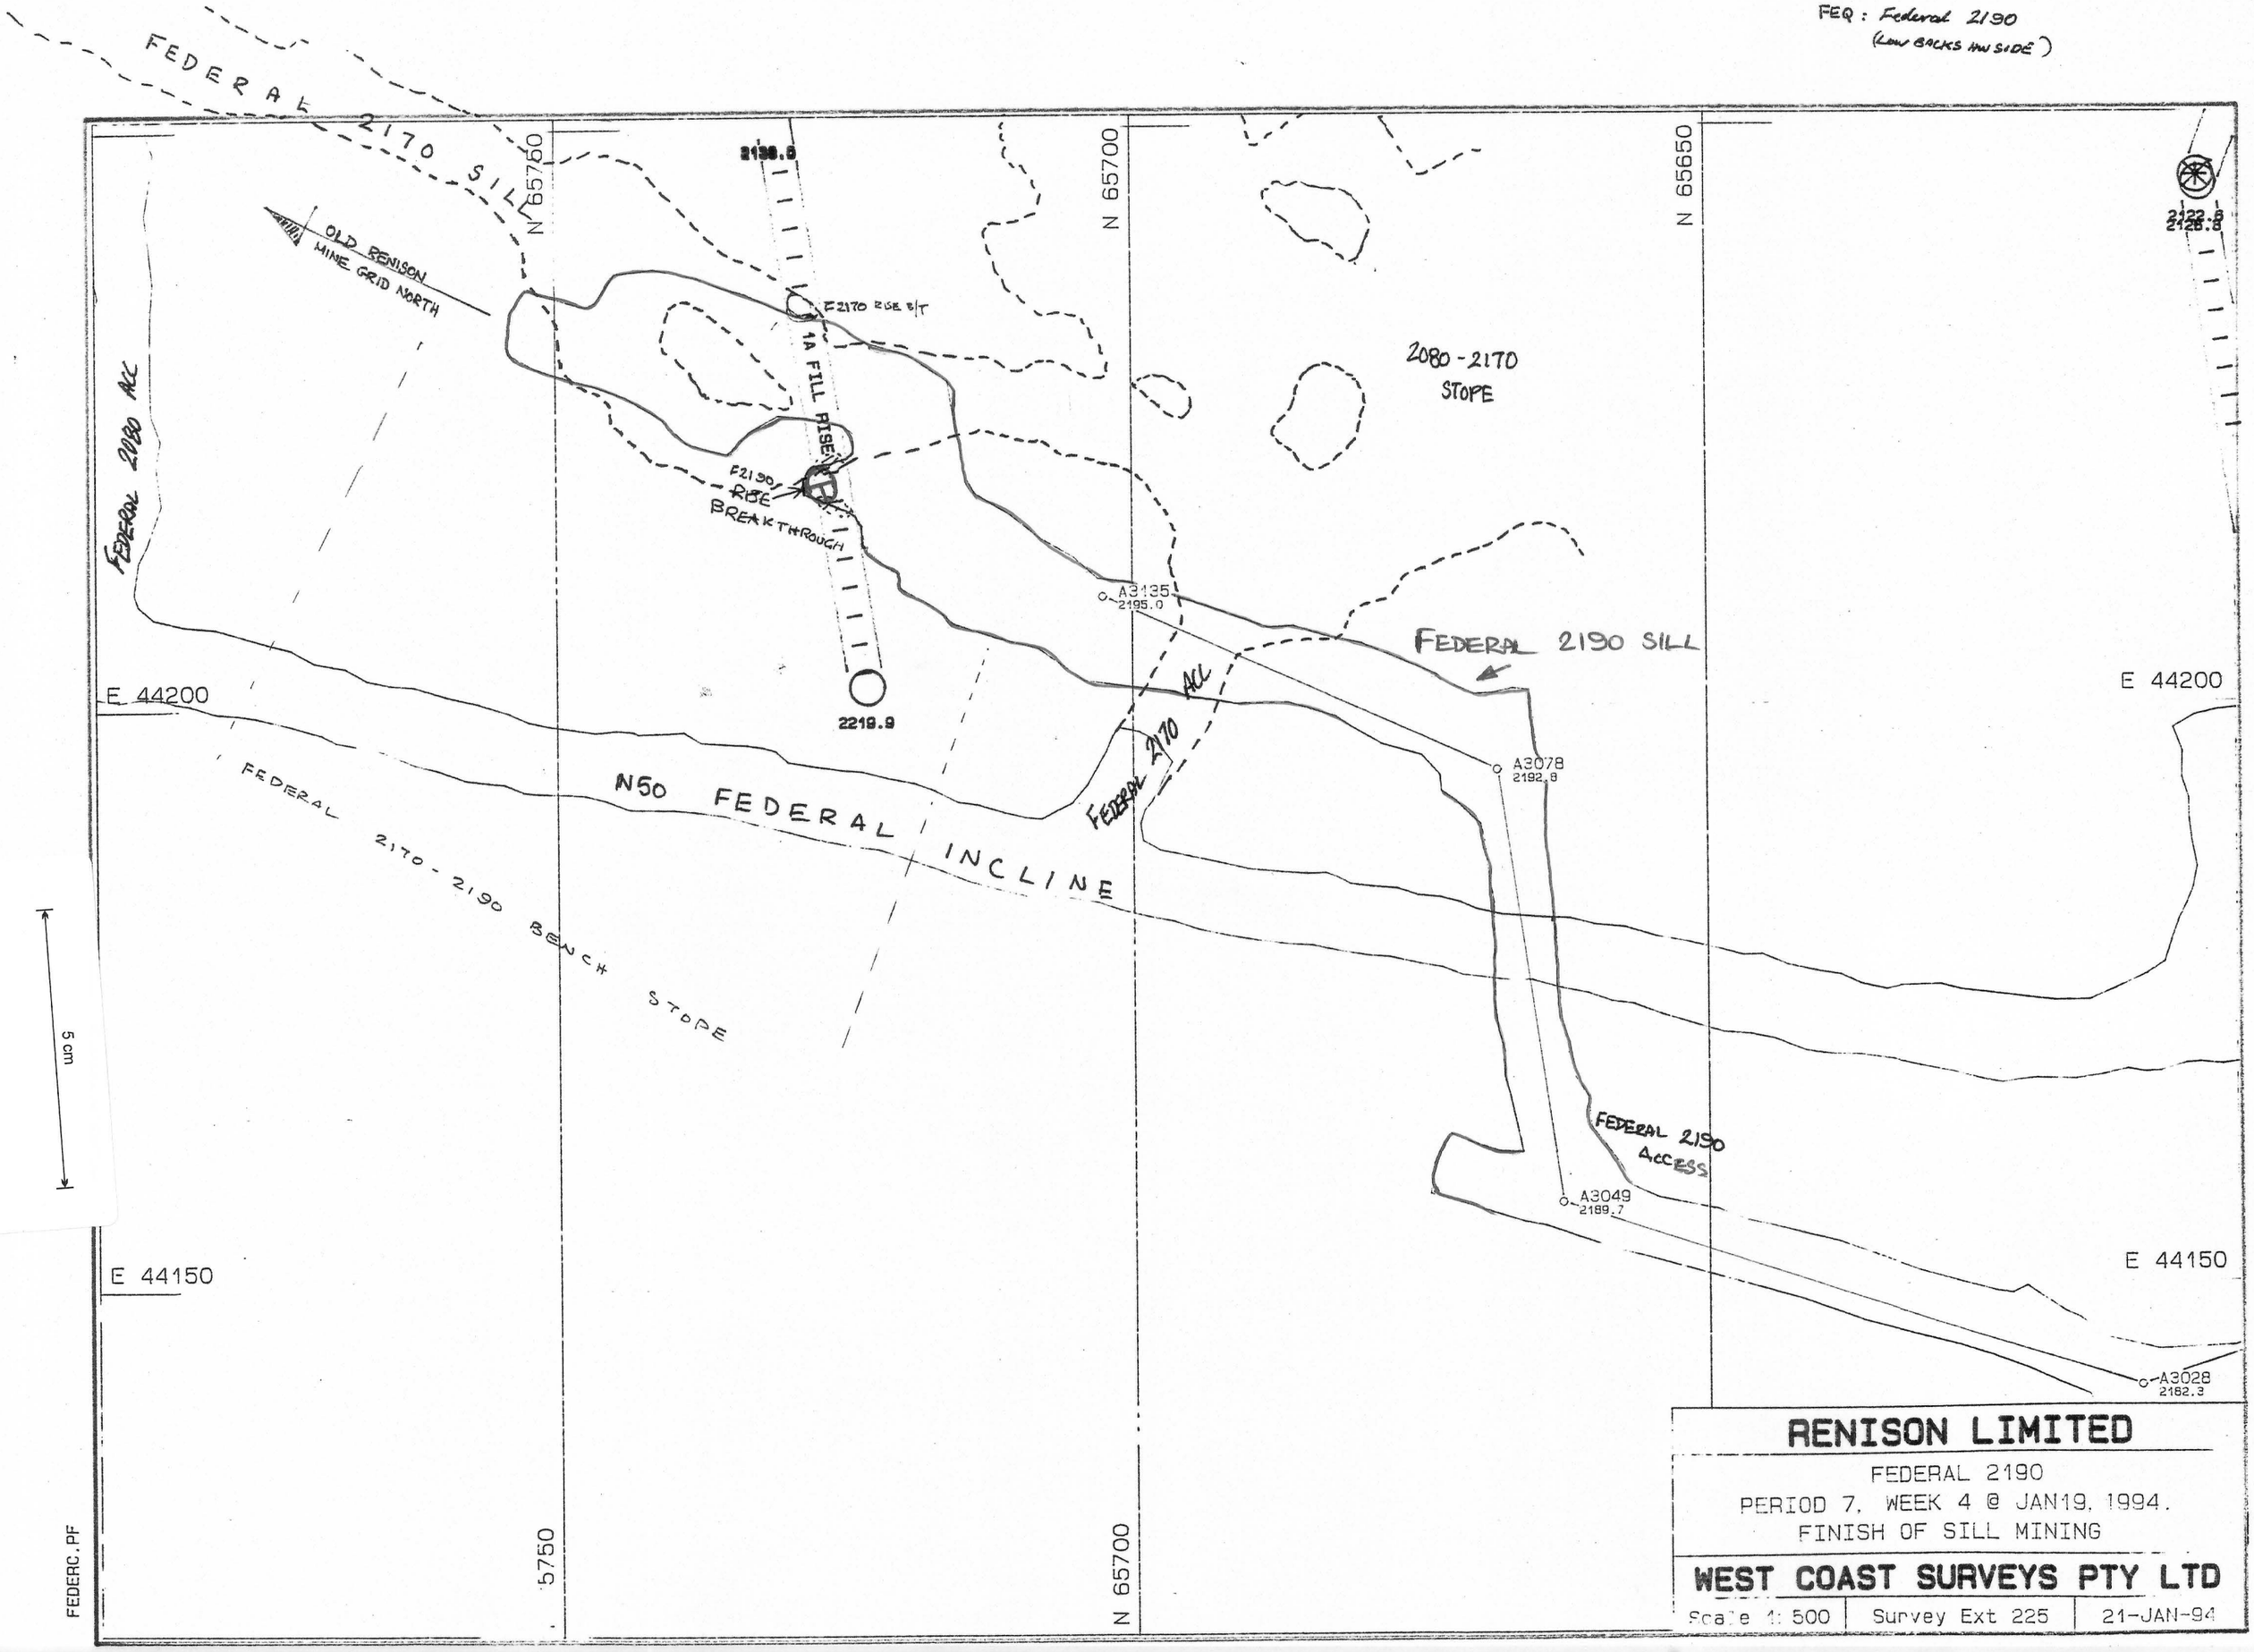

SURPAC SOFTWARE INTERNATIONAL, AUSTRALIA

0376 - 106