


0376 - 133

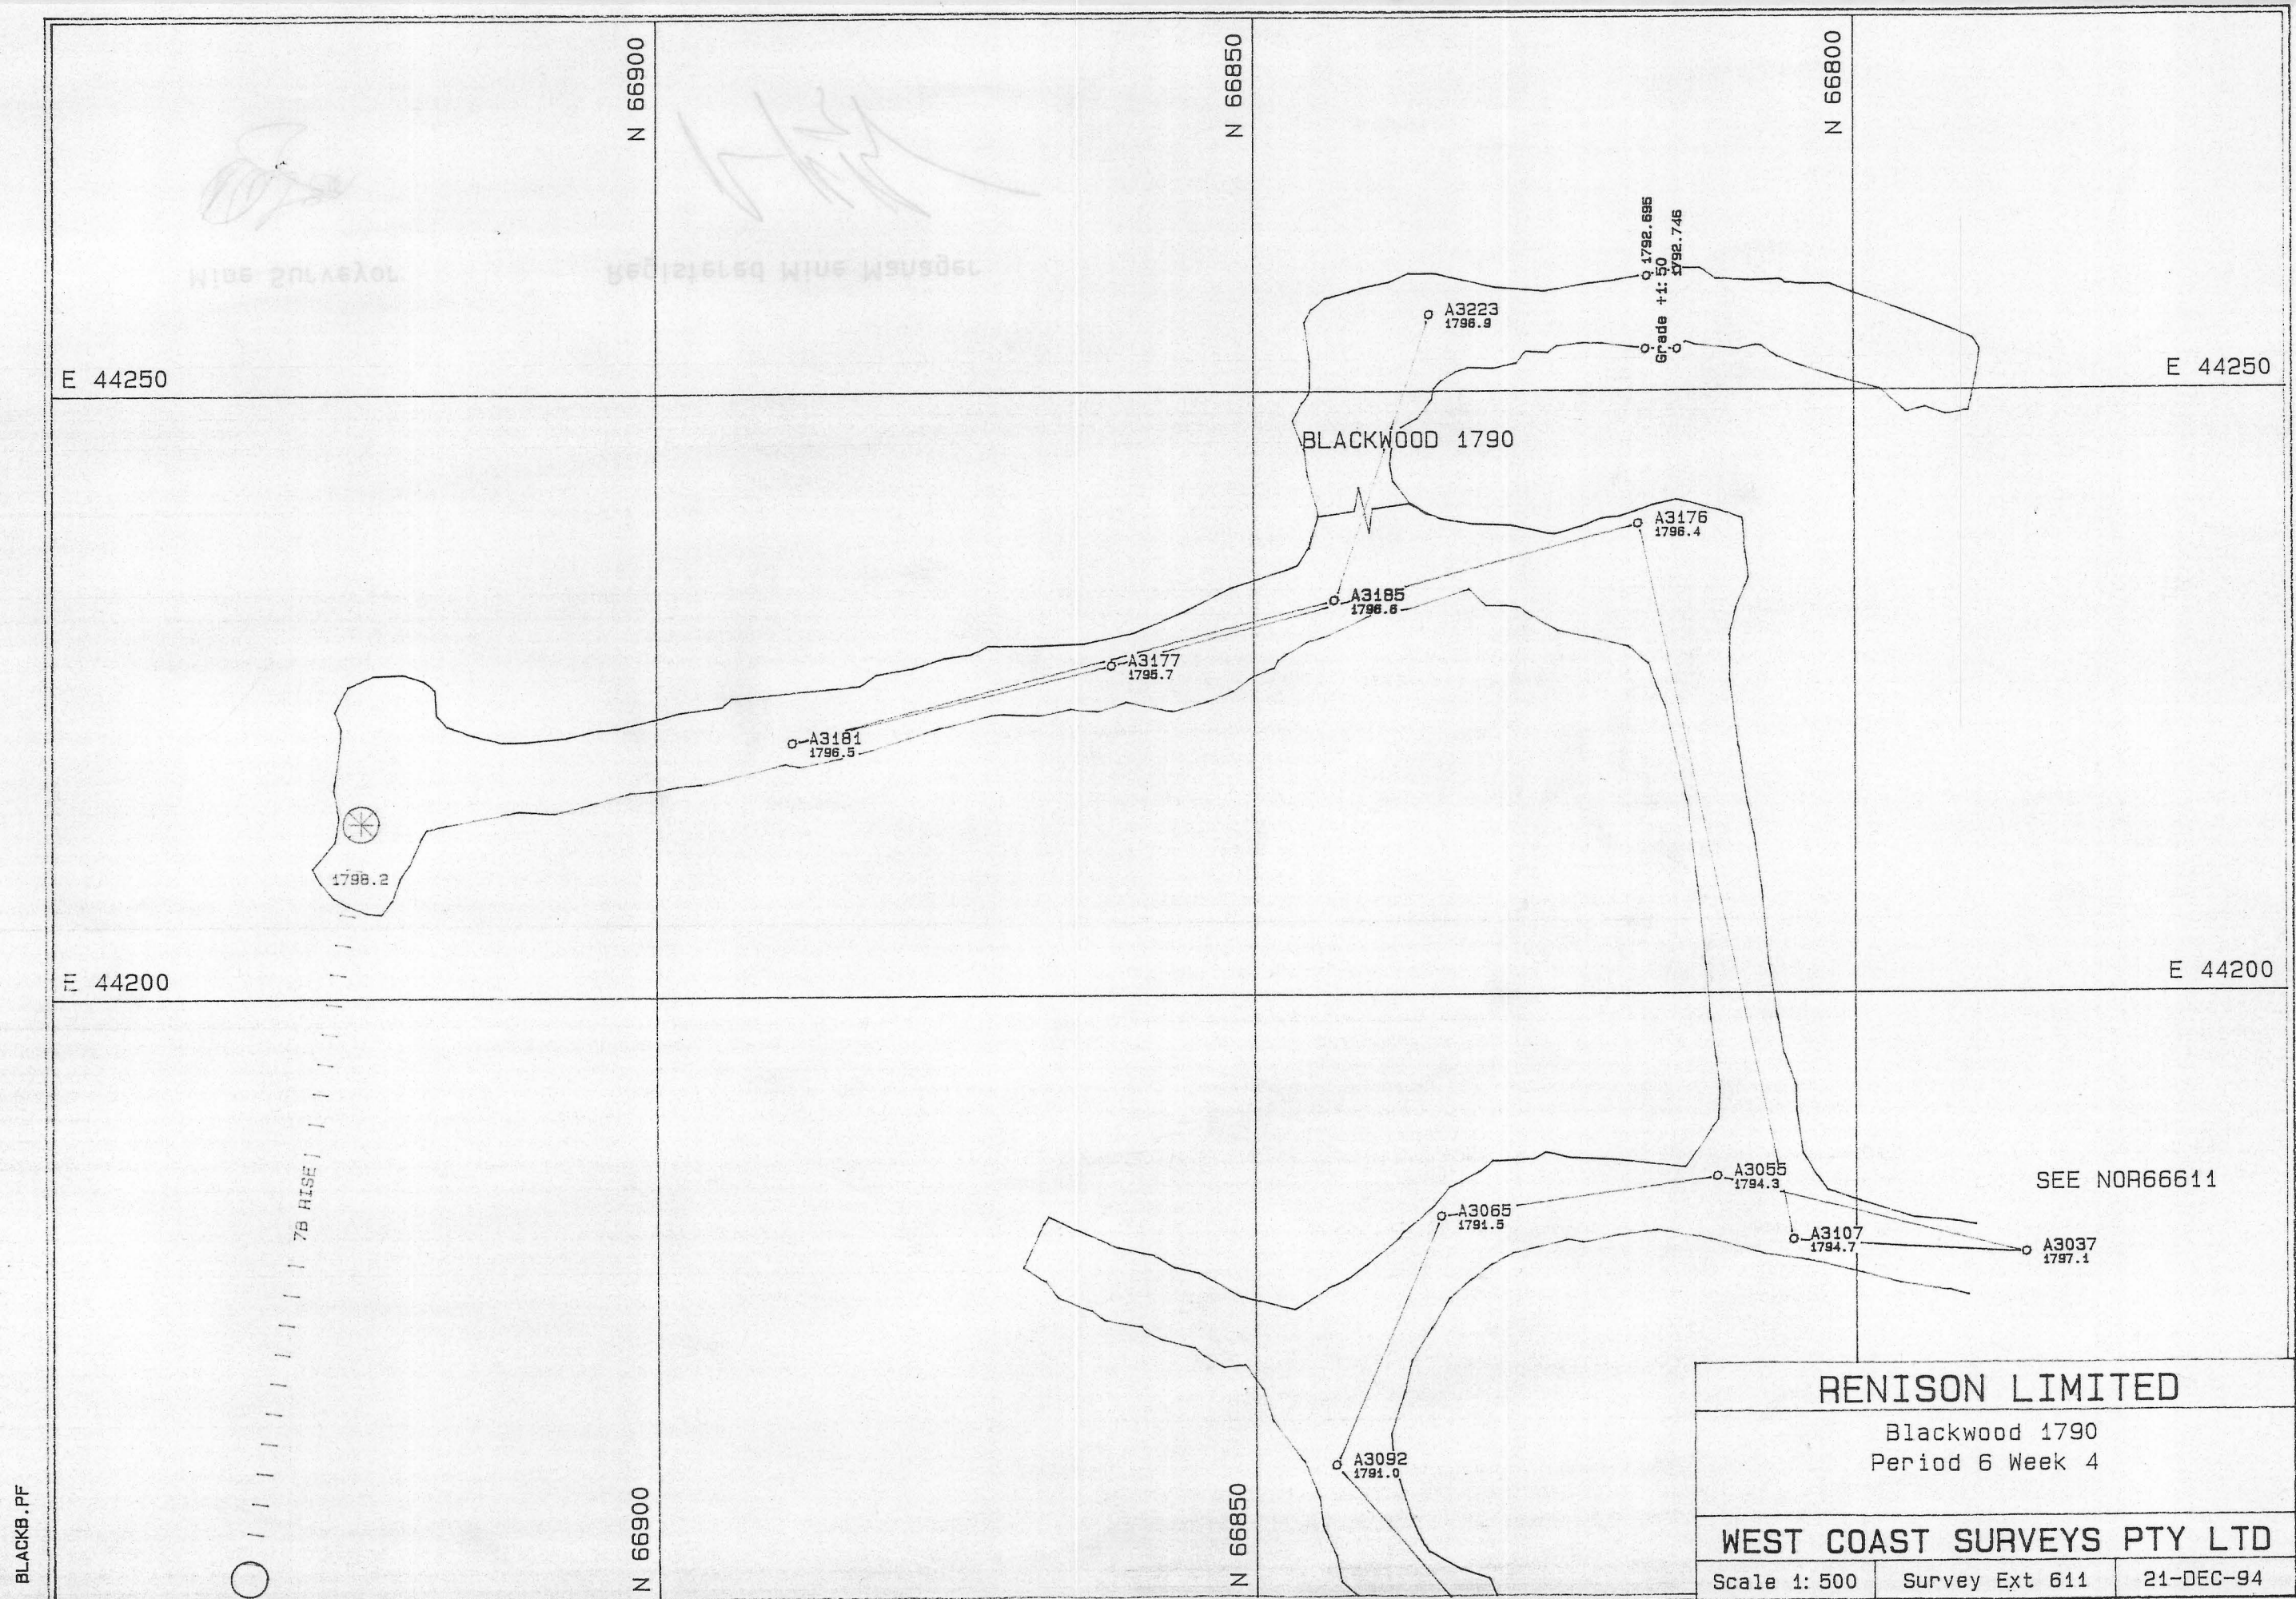

BLACKB.PF

X

5 cm