0376- 148

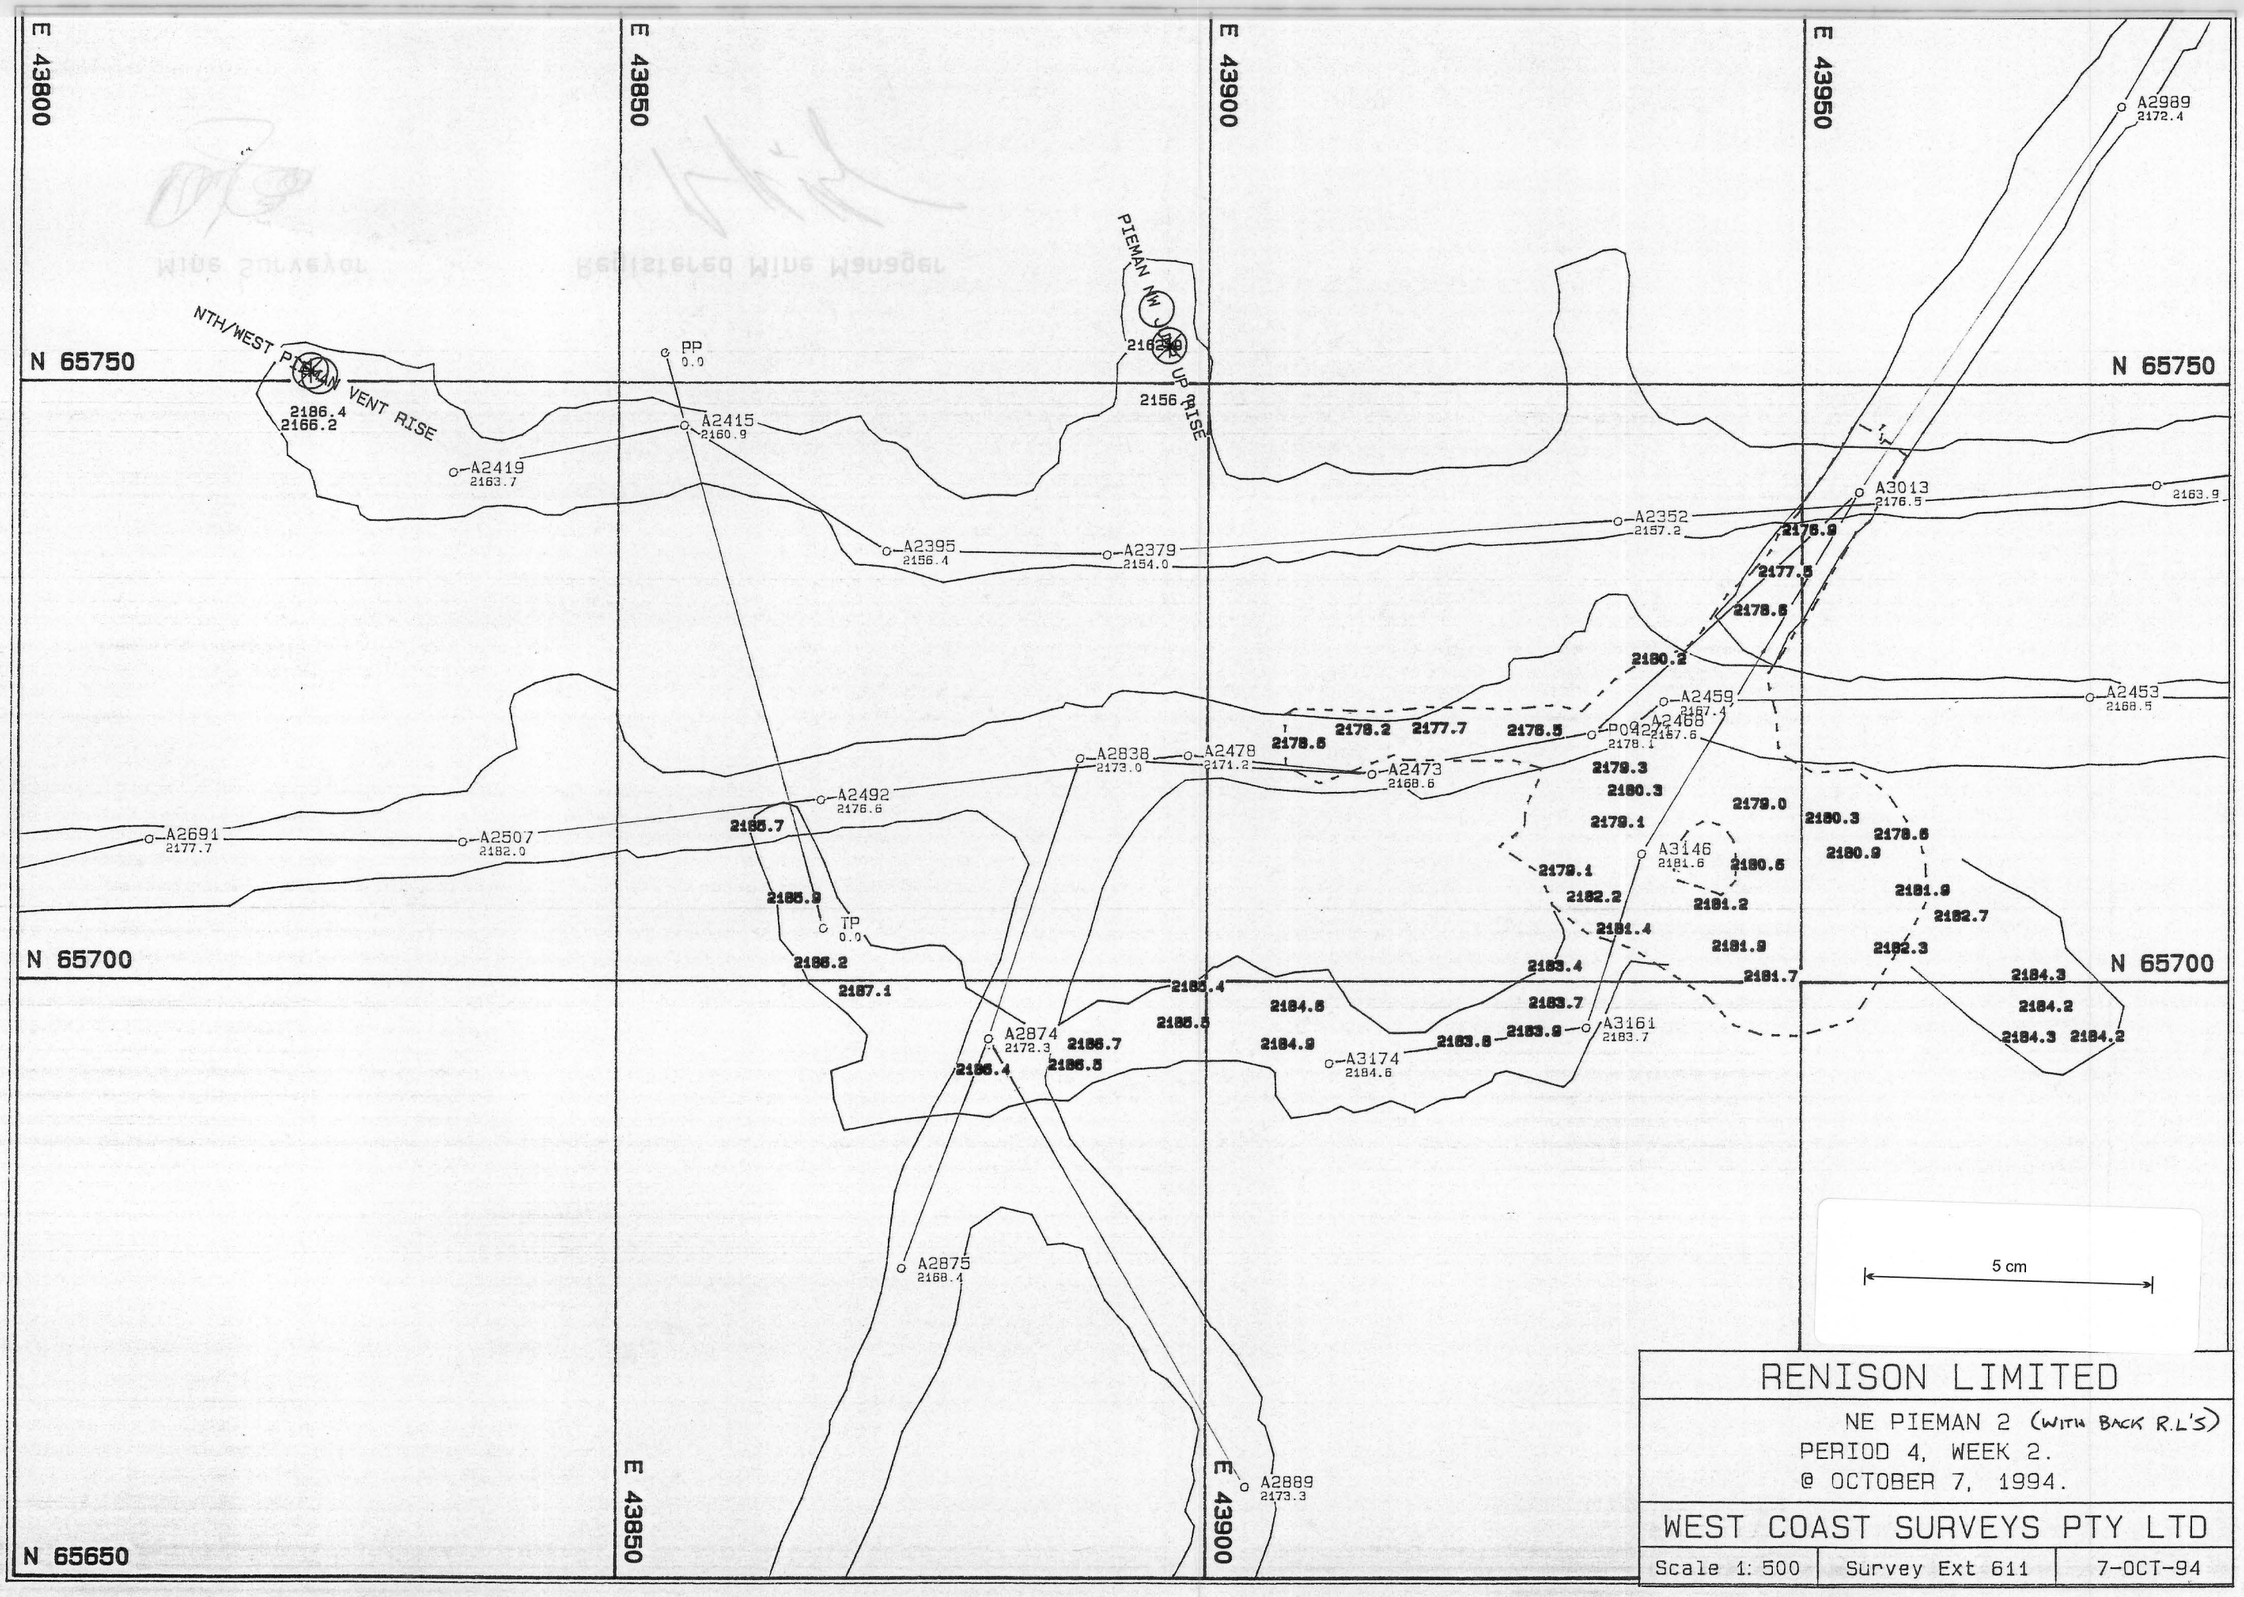

RENISON LIMITED

NE PIEMAN 2 (WITH BACK R.L'S)
PERIOD 4, WEEK 2.
@ OCTOBER 7, 1994.

WEST COAST SURVEYS PTY LTD

Scale 1: 500	Survey Ext 611	7-OCT-94

NEPIEA.PF

SURPAC SOFTWARE INTERNATIONAL. AUSTRALIA