0376- 152

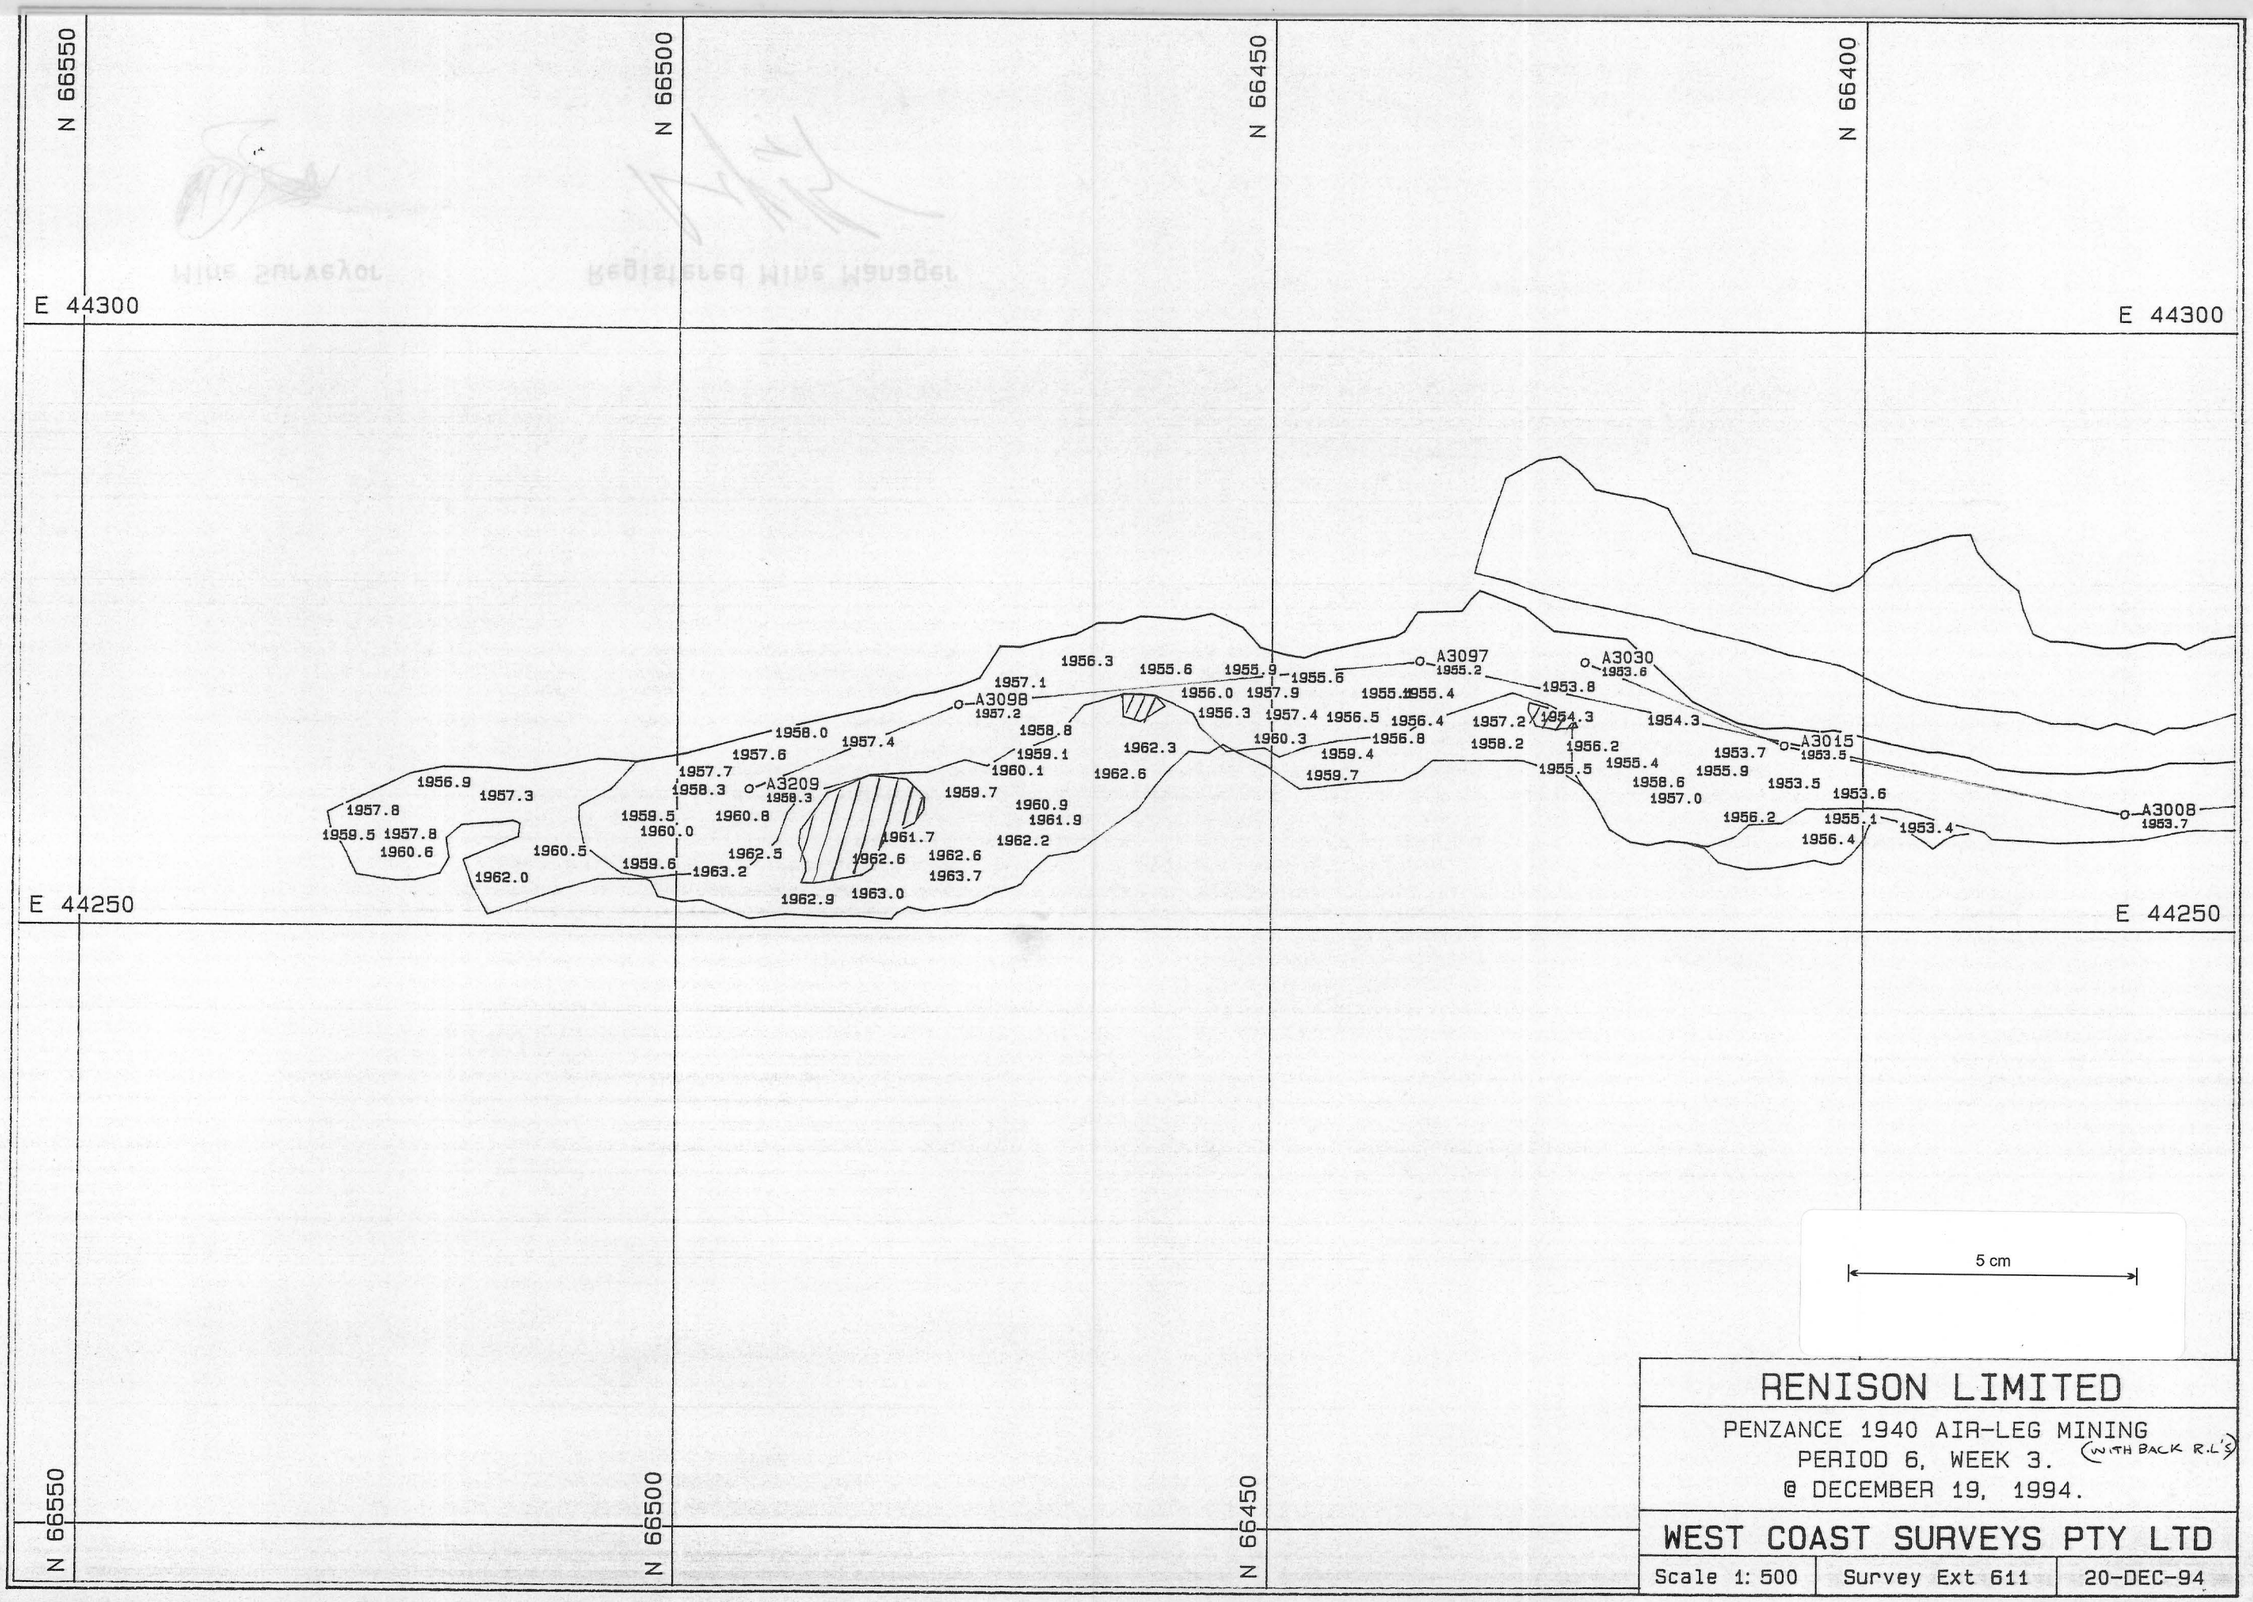

PENZAA.PF

SURPAC SOFTWARE INTERNATIONAL. AUSTRALIA