0376 - 1SS

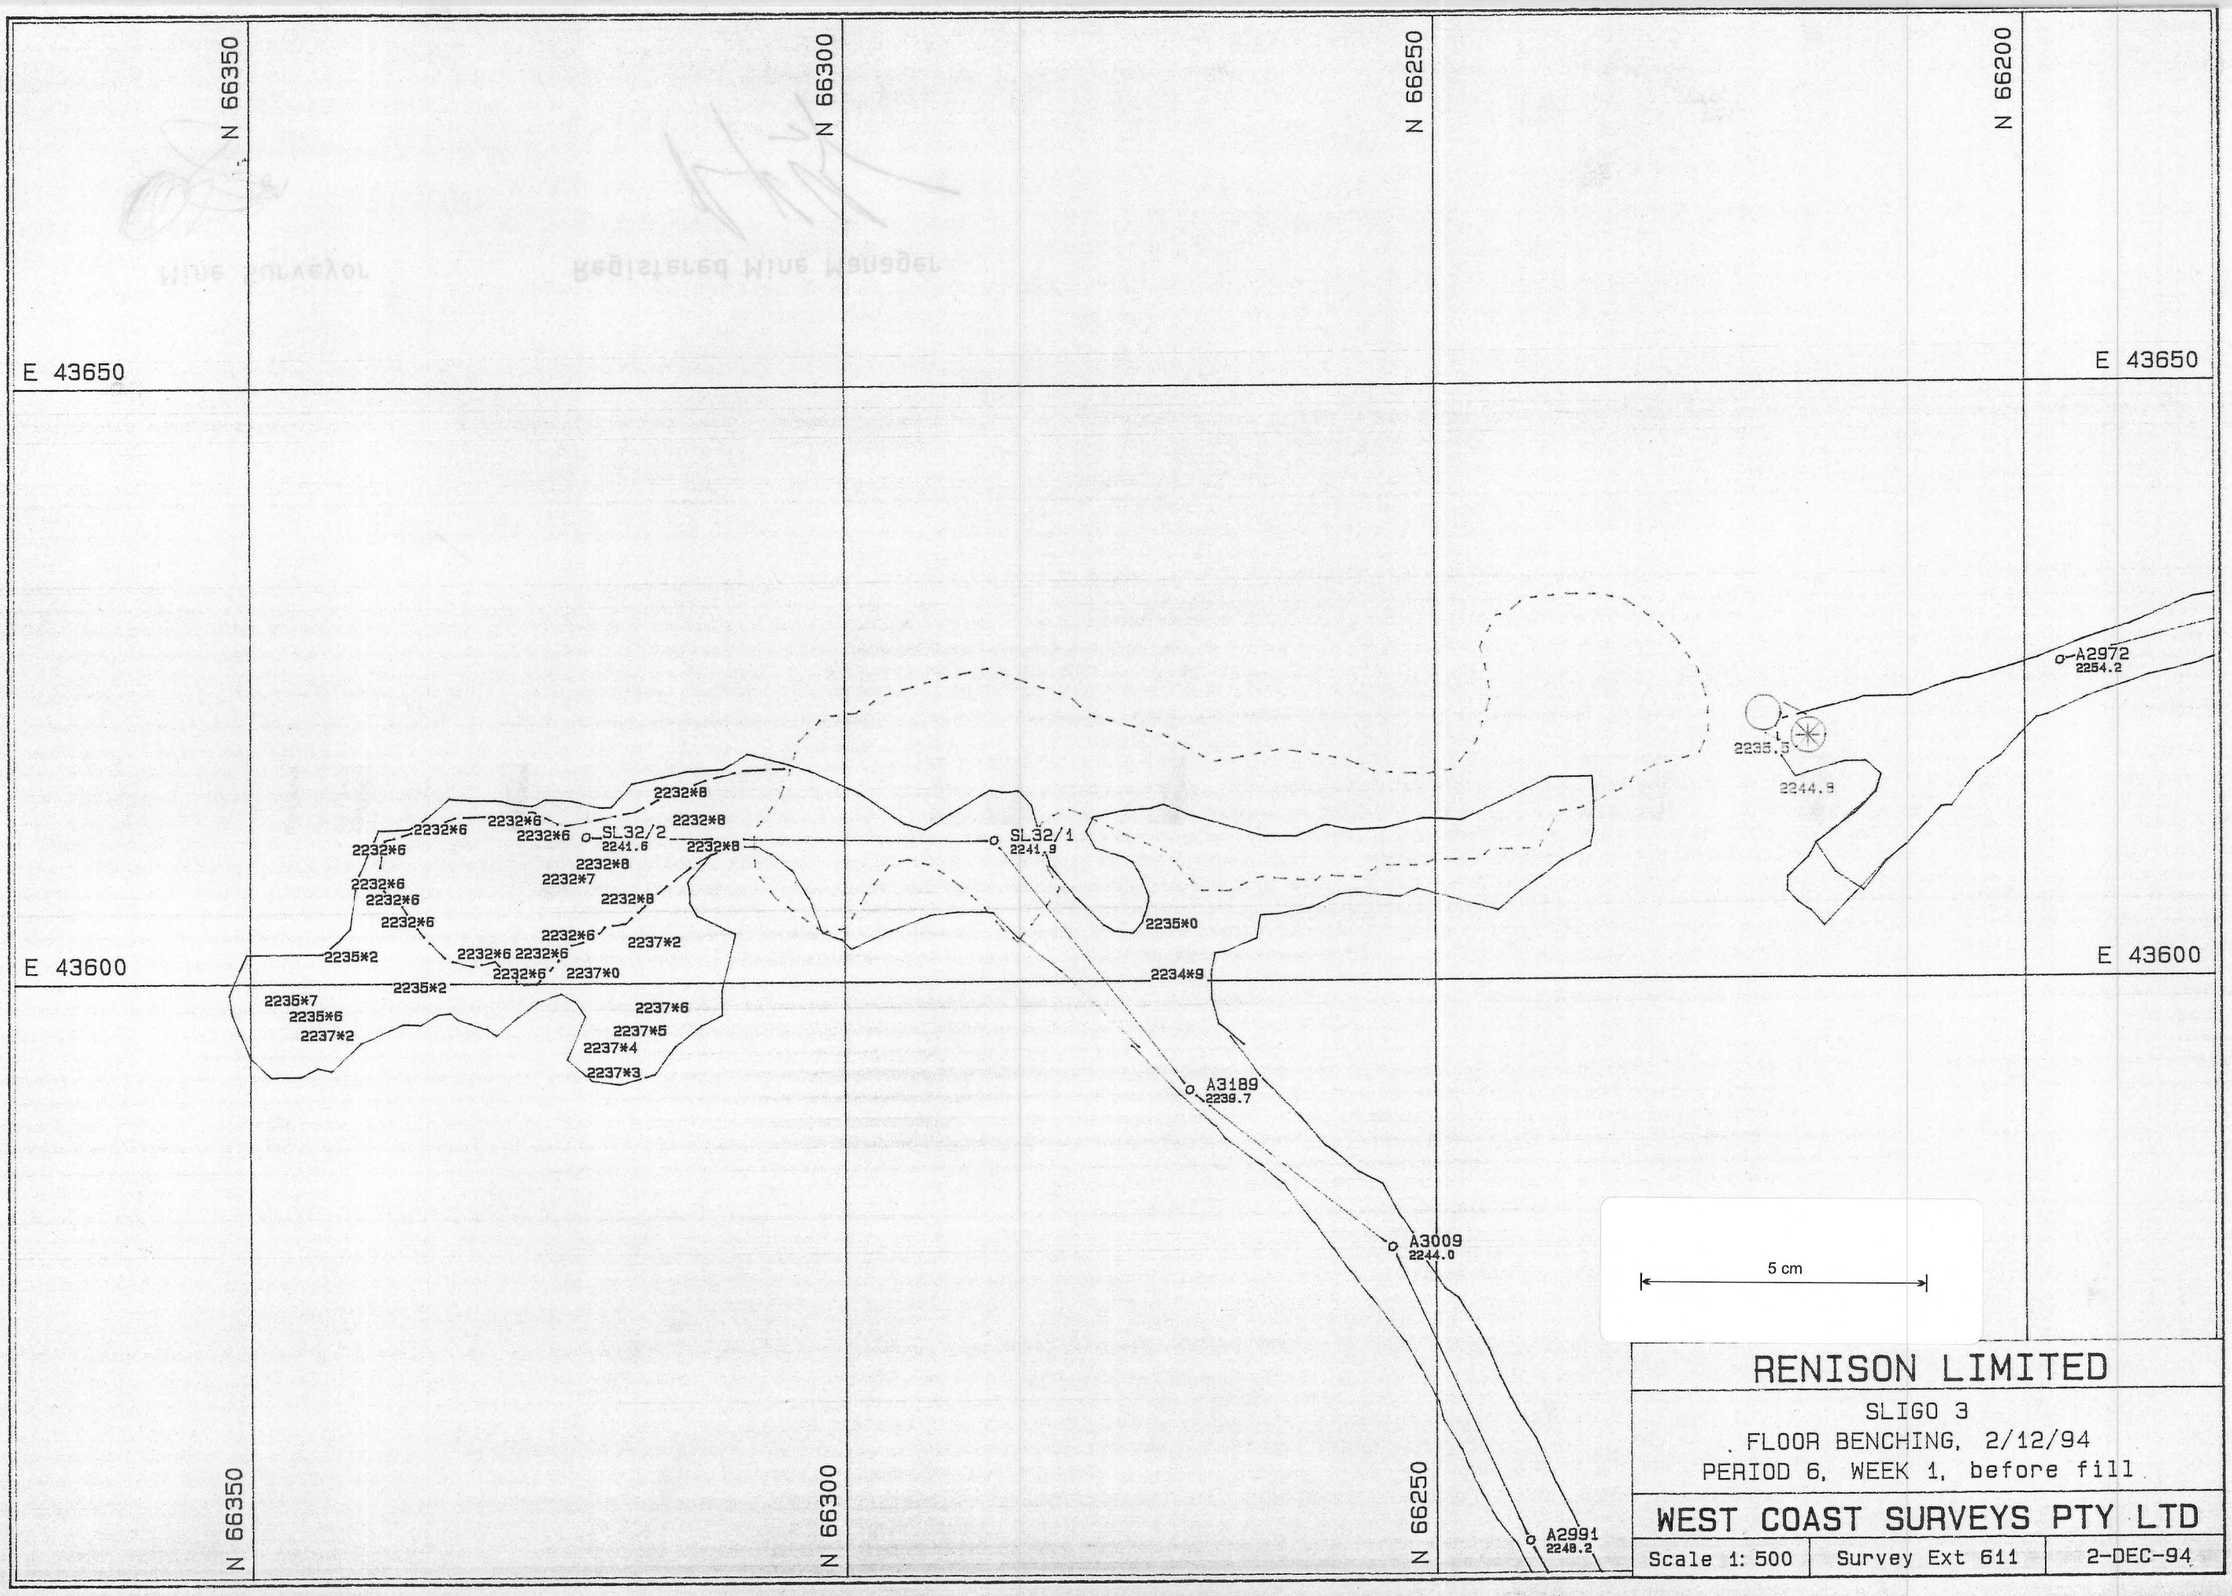
N 66350
N 66300
N 66250
N 66200
E 43650
E 43650
E 43600
E 43600
A2972
2254.2
2235.5
2244.8
SL32/2
2241.6
SL32/1
2241.9
2232*8
2232*6
2232*7
2235*0
2234*9
2235*2
2237*2
2237*0
2235*7
2235*6
2237*6
2237*5
2237*4
2237*3
A3189
2239.7
A3009
2244.0
A2991
2248.2
5 cm
RENISON LIMITED
SLIGO 3
FLOOR BENCHING, 2/12/94
PERIOD 6, WEEK 1, before fill
WEST COAST SURVEYS PTY LTD
Scale 1: 500
Survey Ext 611
2-DEC-94
SLIGOD.PF
SURPAC SOFTWARE INTERNATIONAL. AUSTRALIA