0376-16A

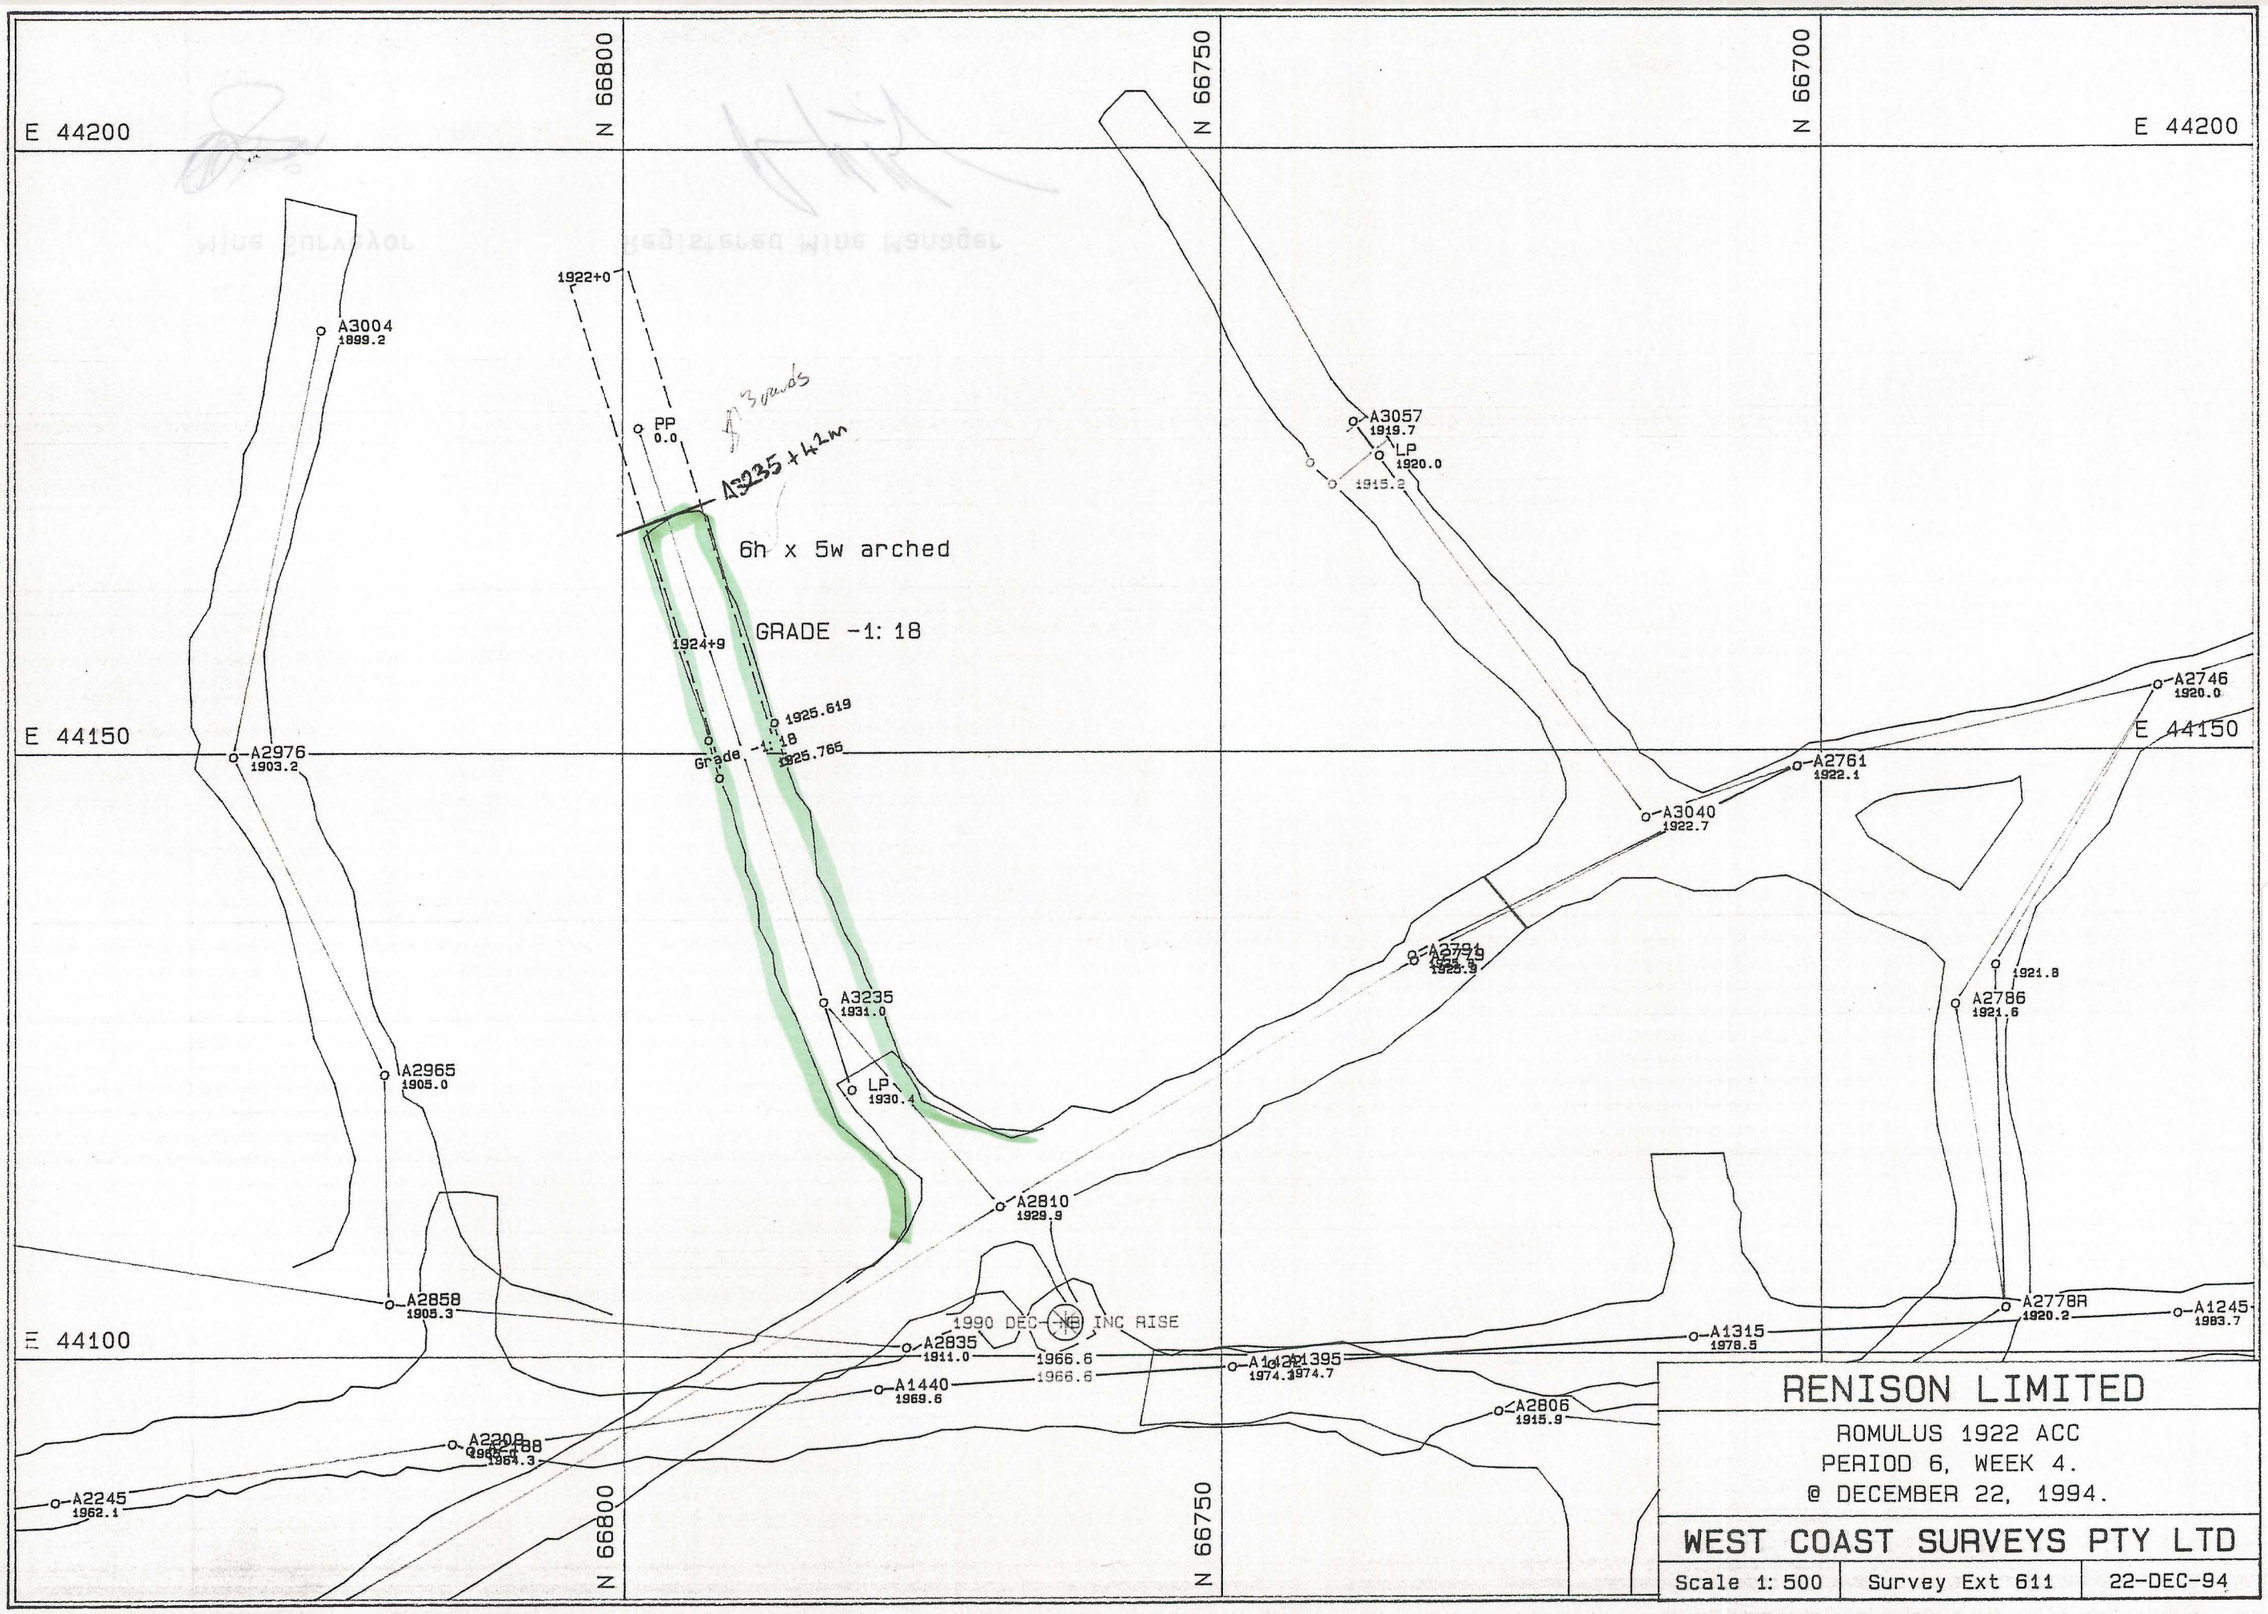
E 44200
N 66800
N 66750
N 66700
E 44200
E 44150
E 44150
E 44100
N 66800
N 66750
A3004
1899.2
1922+0
PP
0.0
A3235+4.2m
6h x 5w arched
GRADE -1: 18
1924+9
1925.619
Grade -1: 18
1925.765
A2976
1903.2
A3057
1919.7
LP
1920.0
1915.2
A2746
1920.0
A2761
1922.1
A3040
1922.7
A2965
1905.0
A3235
1931.0
LP
1930.4
1921.8
A2786
1921.6
A2810
1929.9
A2858
1905.3
1990 DEC-NE INC RISE
A2835
1911.0
1966.6
1966.6
A1440
1969.6
A1395
1974.7
A2806
1915.9
A1315
1978.5
A2778R
1920.2
A1245
1983.7
A2245
1962.1
5 cm
RENISON LIMITED
ROMULUS 1922 ACC
PERIOD 6, WEEK 4.
@ DECEMBER 22, 1994.
WEST COAST SURVEYS PTY LTD
Scale 1: 500
Survey Ext 611
22-DEC-94
ROMULA.PF
SURPAC SOFTWARE INTERNATIONAL. AUSTRALIA