0376-267

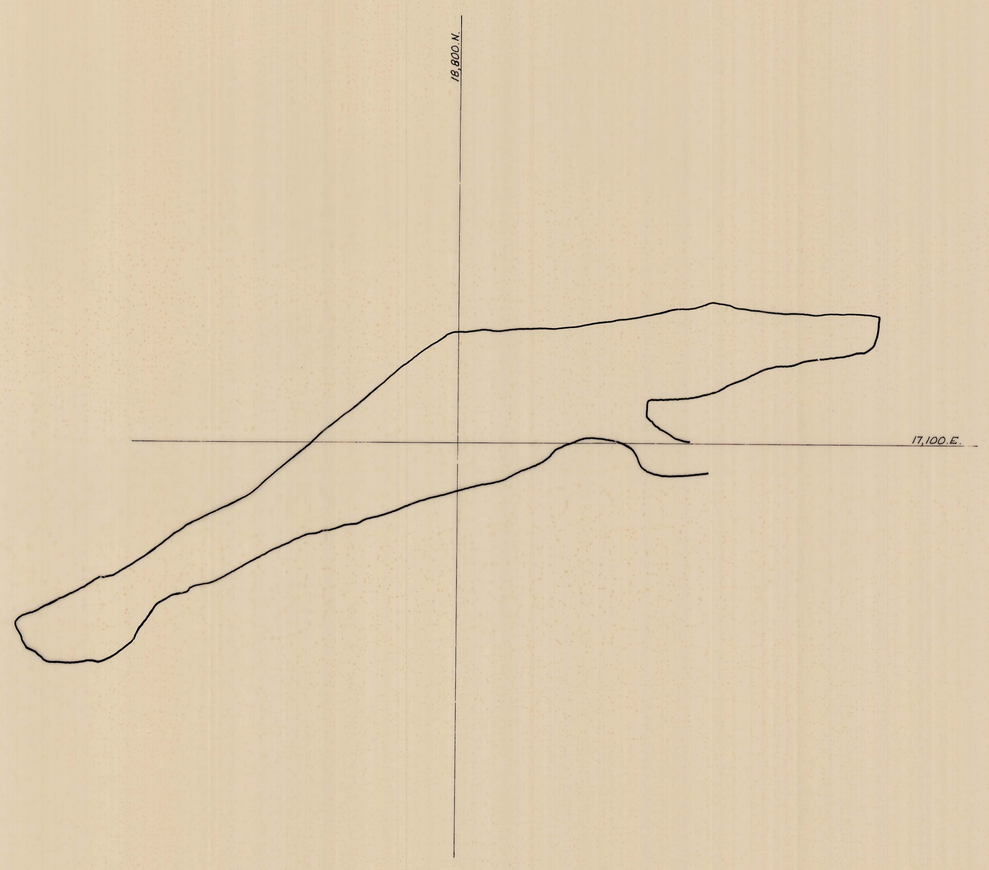

5 cm

0376-267

DATE	MANAGER	SURVEYOR	RENISON LIMITED SURVEY	DRAWING Nº
31-12-82			DRAWN: P.W.K / DATE: 7·3·73 / SCALE 1:500	12:038
			NORTH FEDERAL STOPE LEVEL 2104	

83052