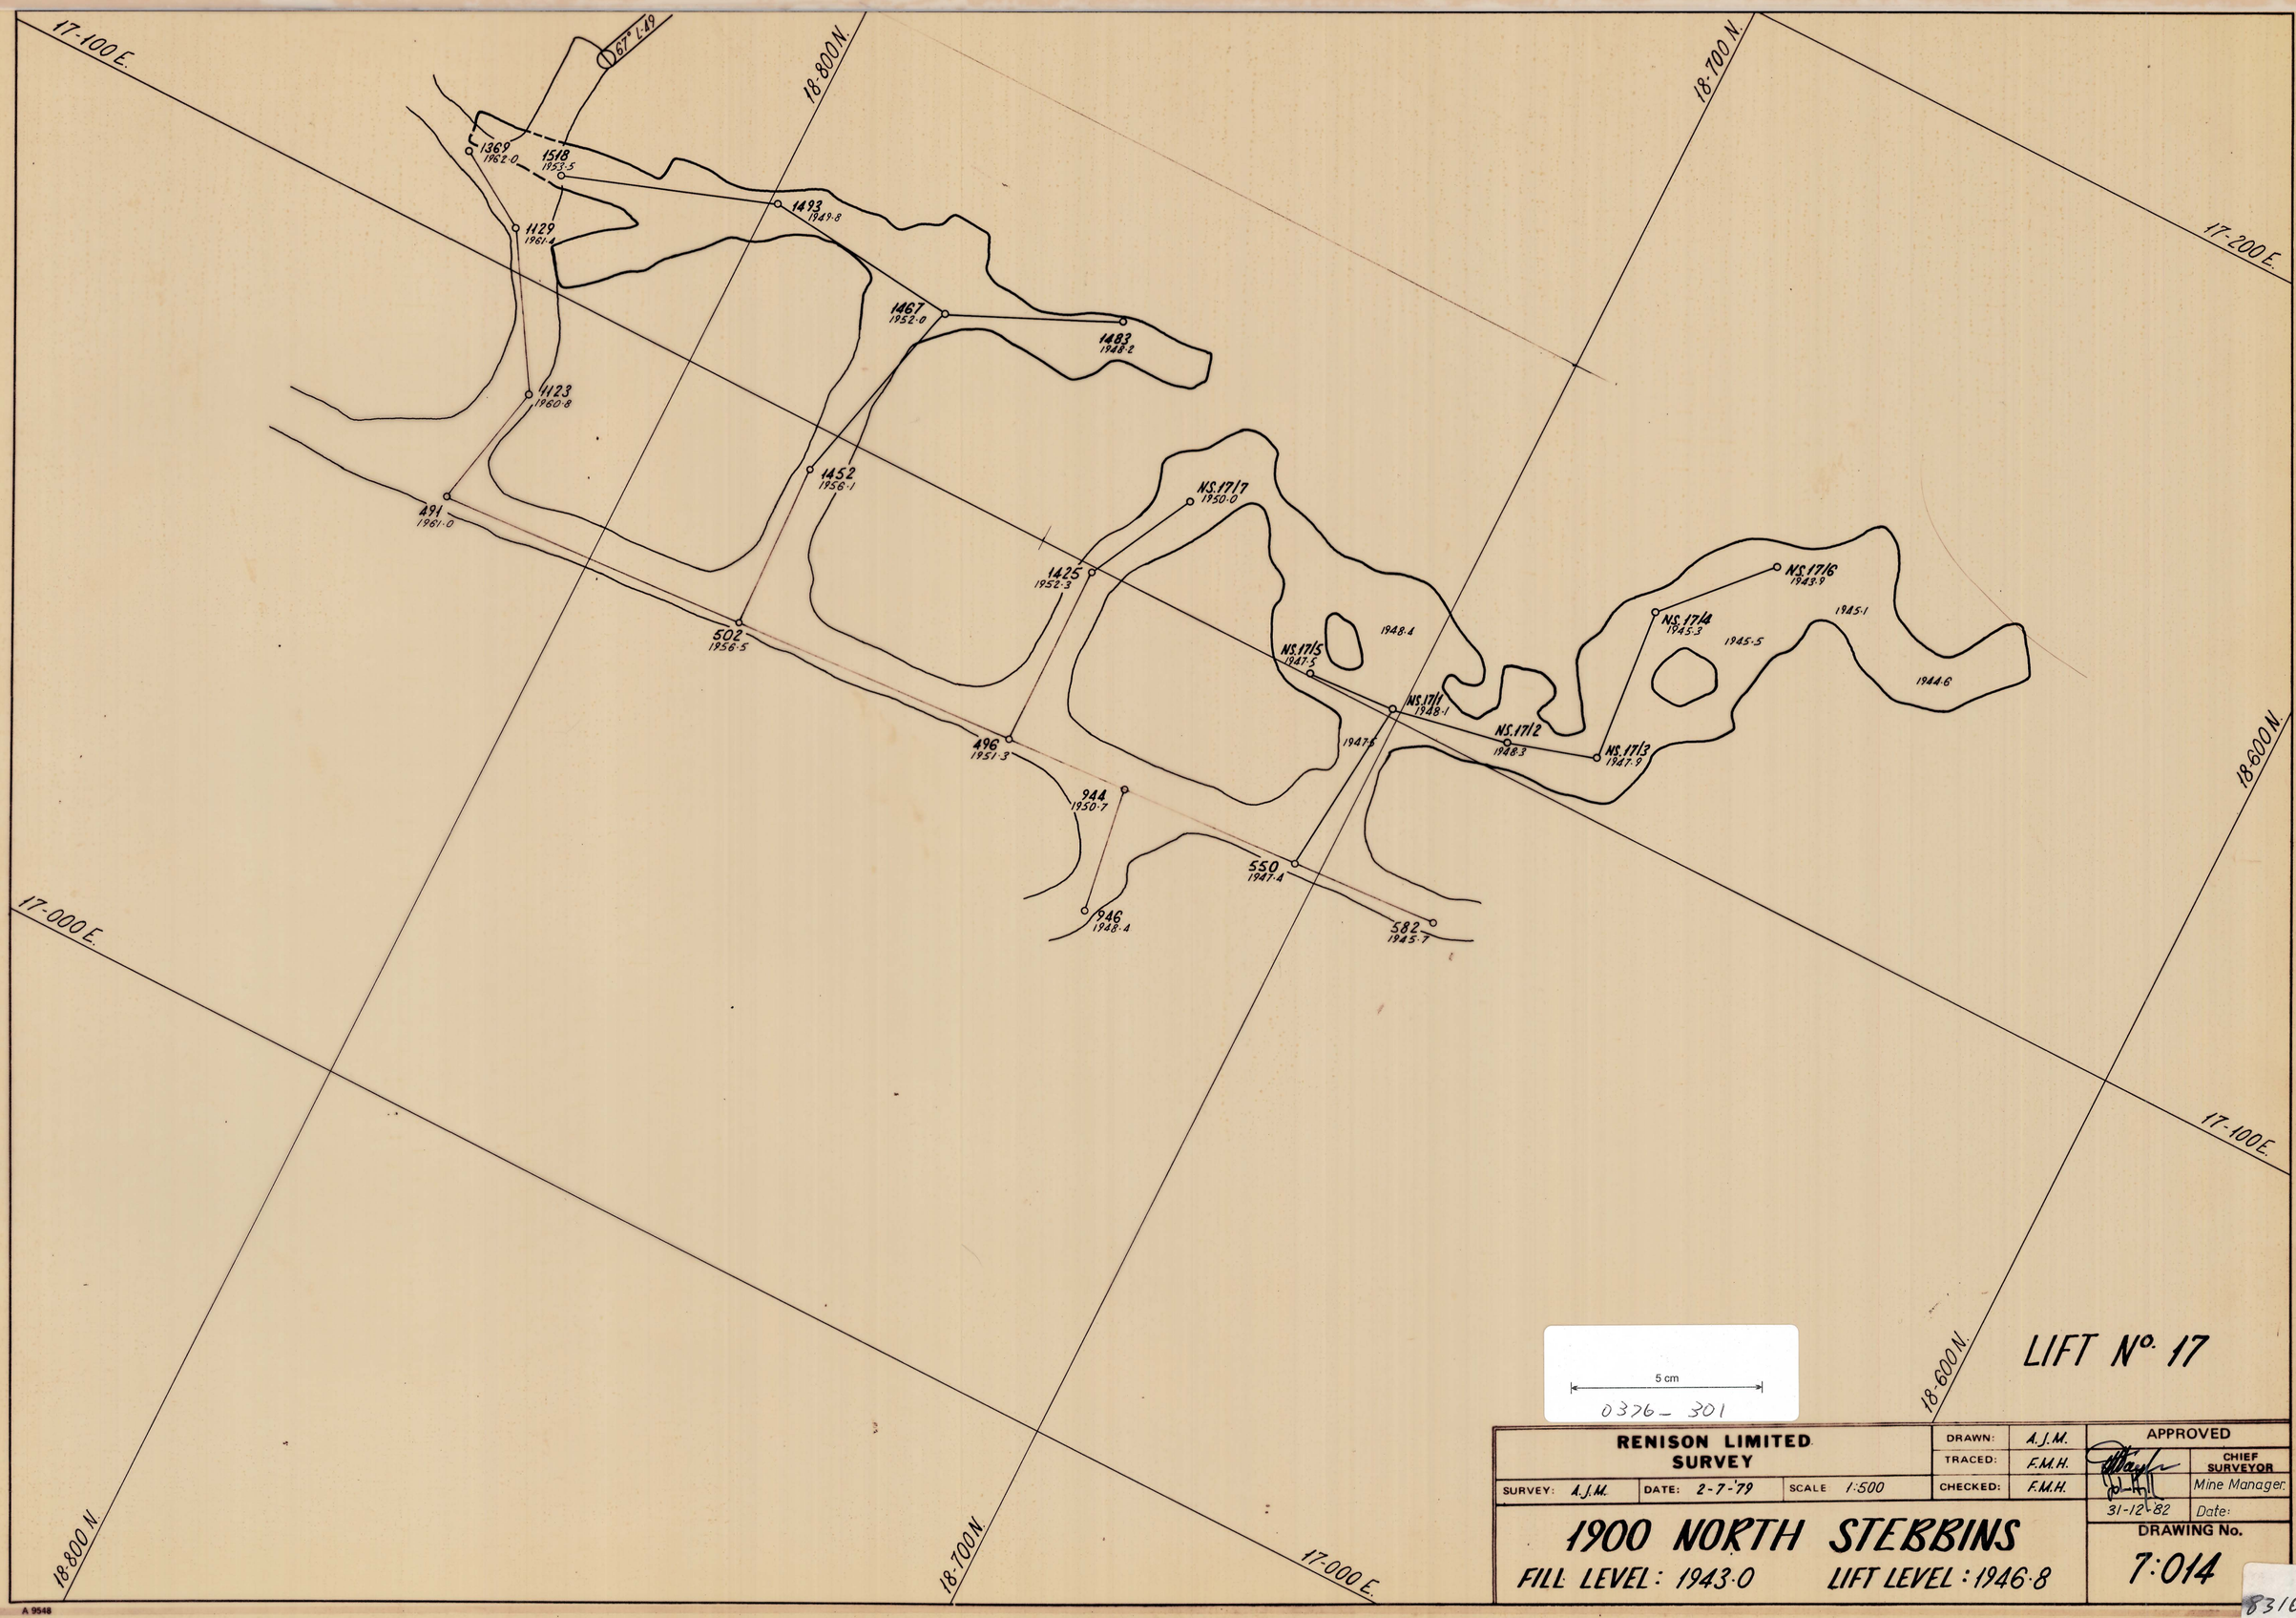

LIFT Nº 17

RENISON LIMITED SURVEY			DRAWN: A.J.M.	APPROVED
			TRACED: F.M.H.	CHIEF SURVEYOR
SURVEY: A.J.M.	DATE: 2-7-79	SCALE 1:500	CHECKED: F.M.H.	Mine Manager
				31-12-82 Date:

1900 NORTH STEBBINS

FILL LEVEL: 1943·0 LIFT LEVEL: 1946·8

DRAWING No. 7:014

A 9548

83106